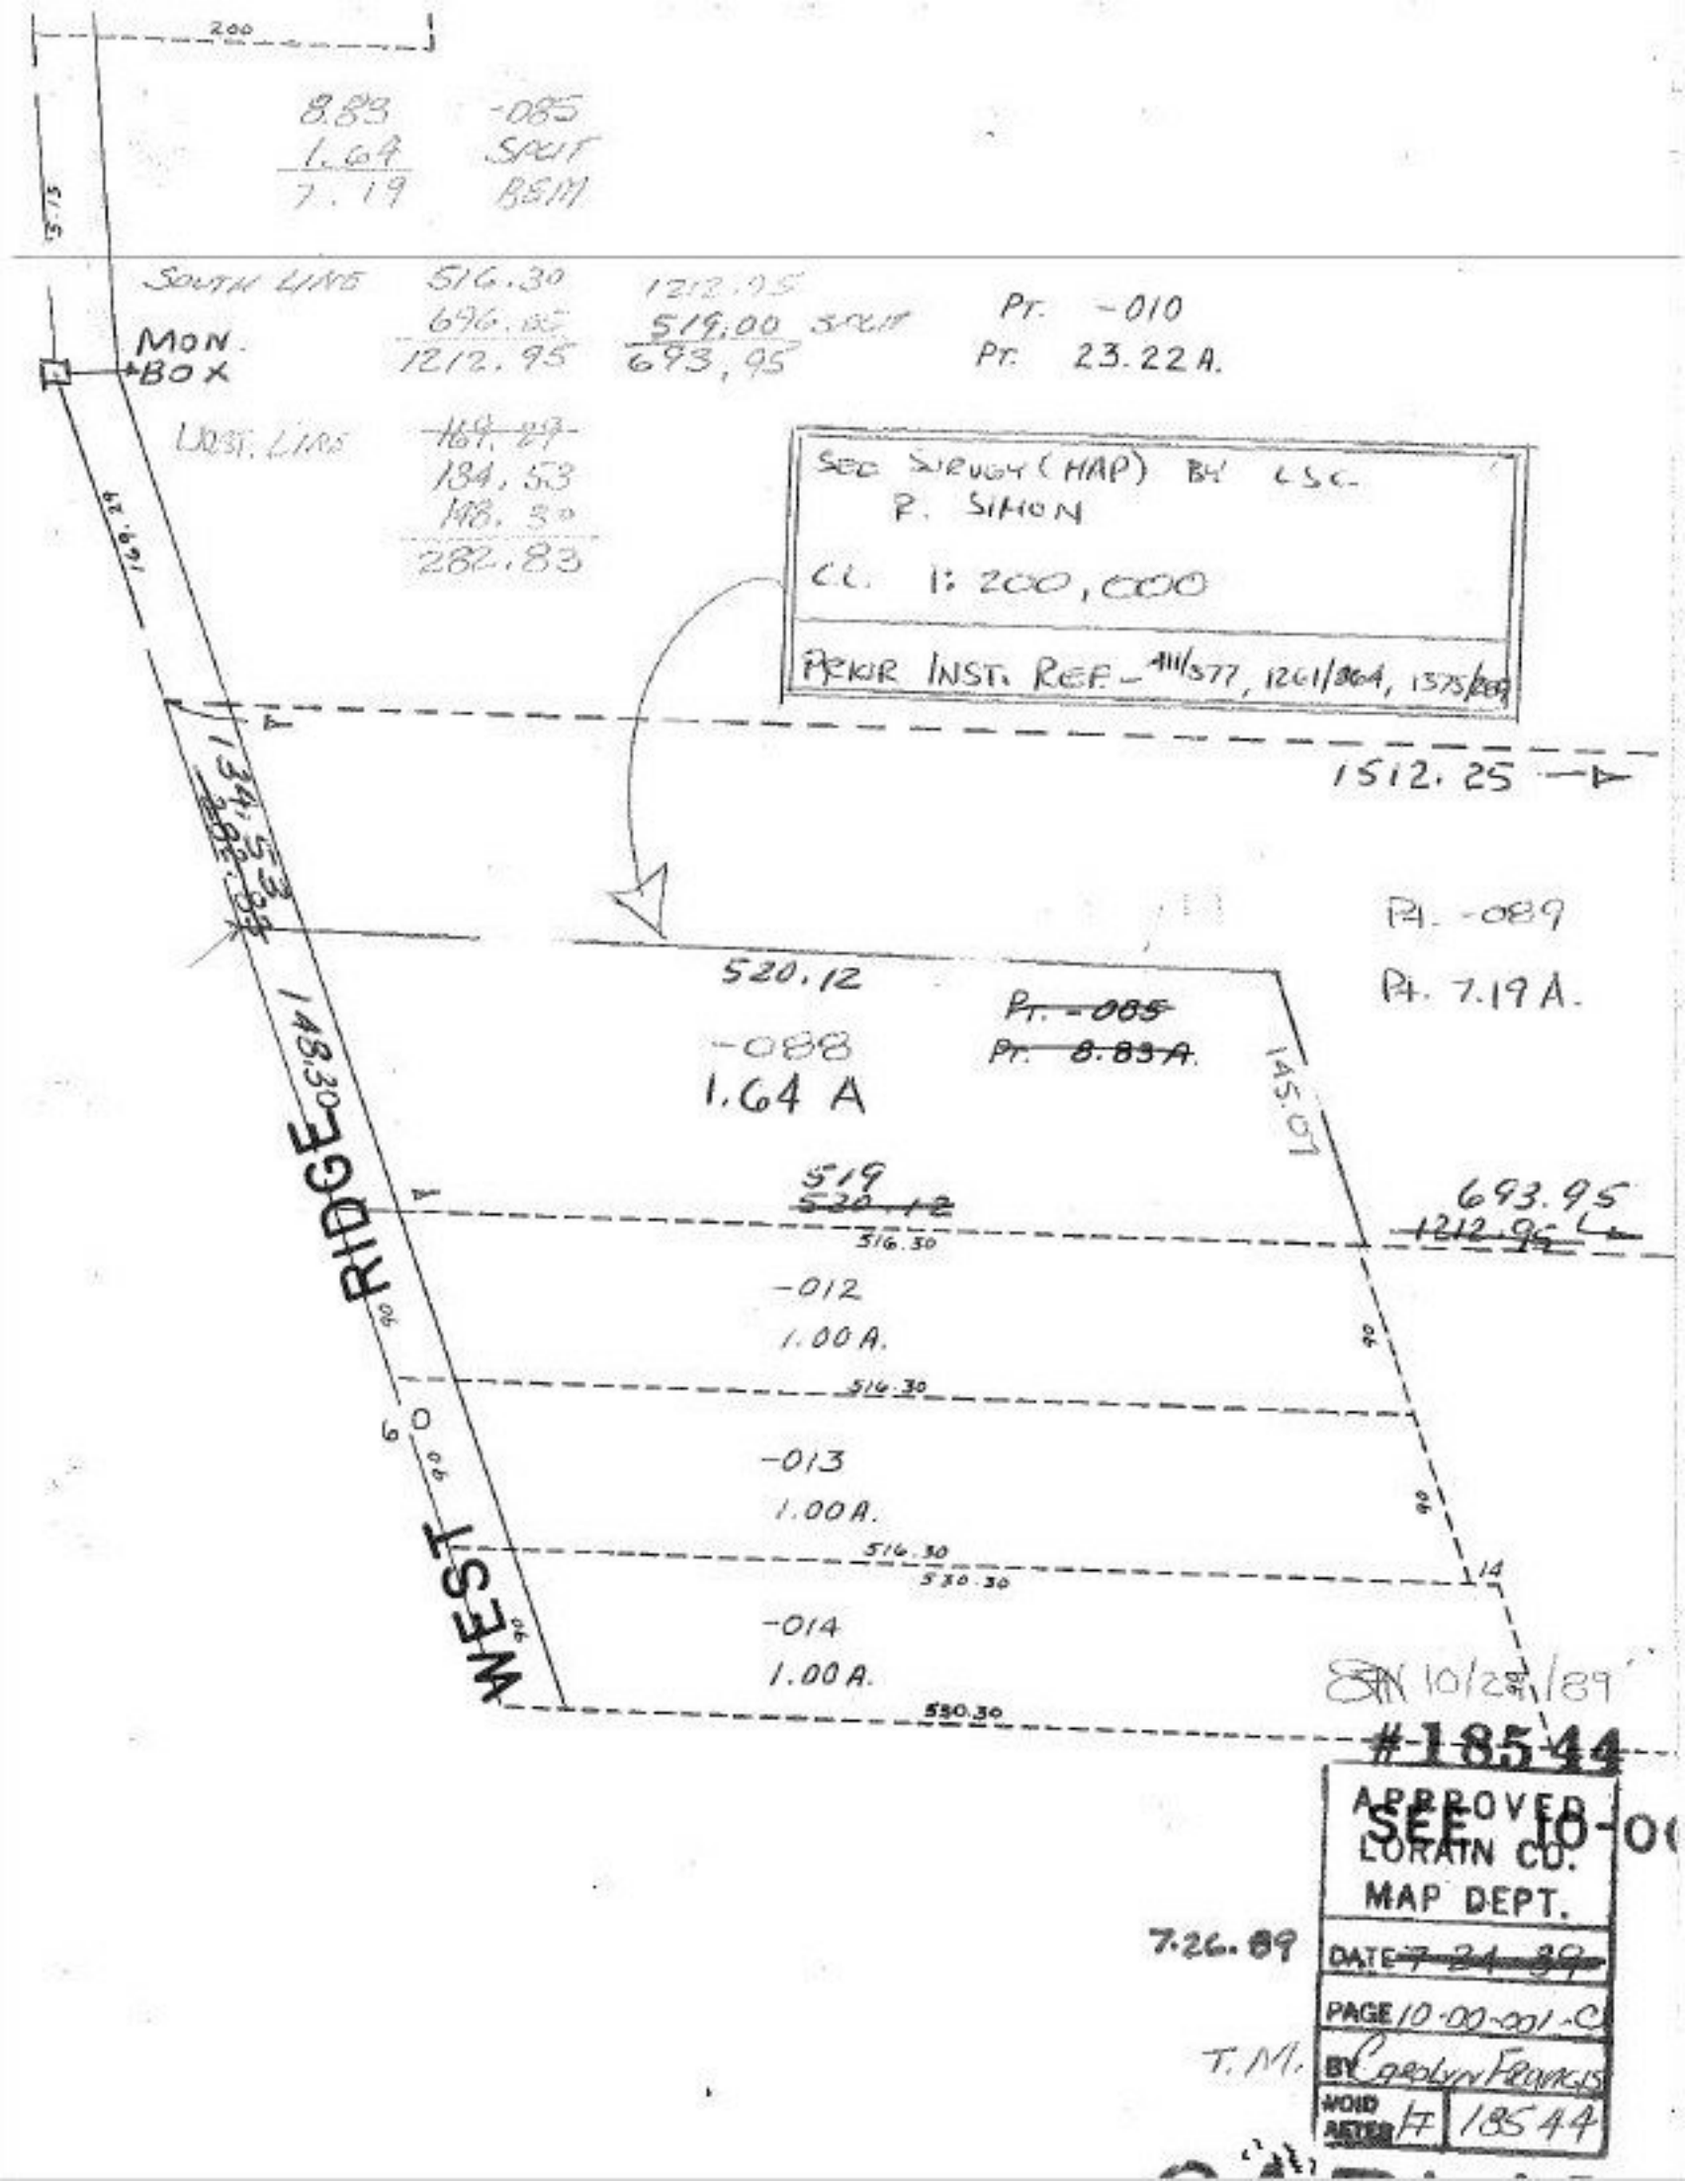
200
315
8.83
1.64
7.19
-085
SPLIT
BSM
SOUTH LINE
516.30
696.65
1212.95
MON.
BOX
1212.95
519.00 SPLIT
693.95
Pt. -010
Pt. 23.22 A.
WEST LINE
169.27
134.53
148.30
282.83
SEE SURVEY (MAP) BY L.S.C.
P. SIMON
C.L. 1: 200,000
PRIOR INST. REF. 411/577, 1261/864, 1375/869
1512.25
1134.53
148.30
RIDGE
520.12
-088
1.64 A
Pt. -089
Pt. 7.19 A.
Pt. -085
Pt. 8.83 A.
145.97
519
516.30
693.95
1212.95
-012
1.00 A.
516.30
-013
1.00 A.
516.30
530.30
-014
1.00 A.
530.30
10/23/89
#18544
APPROVED
LORAIN CO.
MAP DEPT.
7-26-89
DATE 7-24-89
PAGE 10-00-001-C
BY Carolyn Francis
VOID AFTER 7 18544
T.M.
SEE 10-0