


1855

SEE 6-25

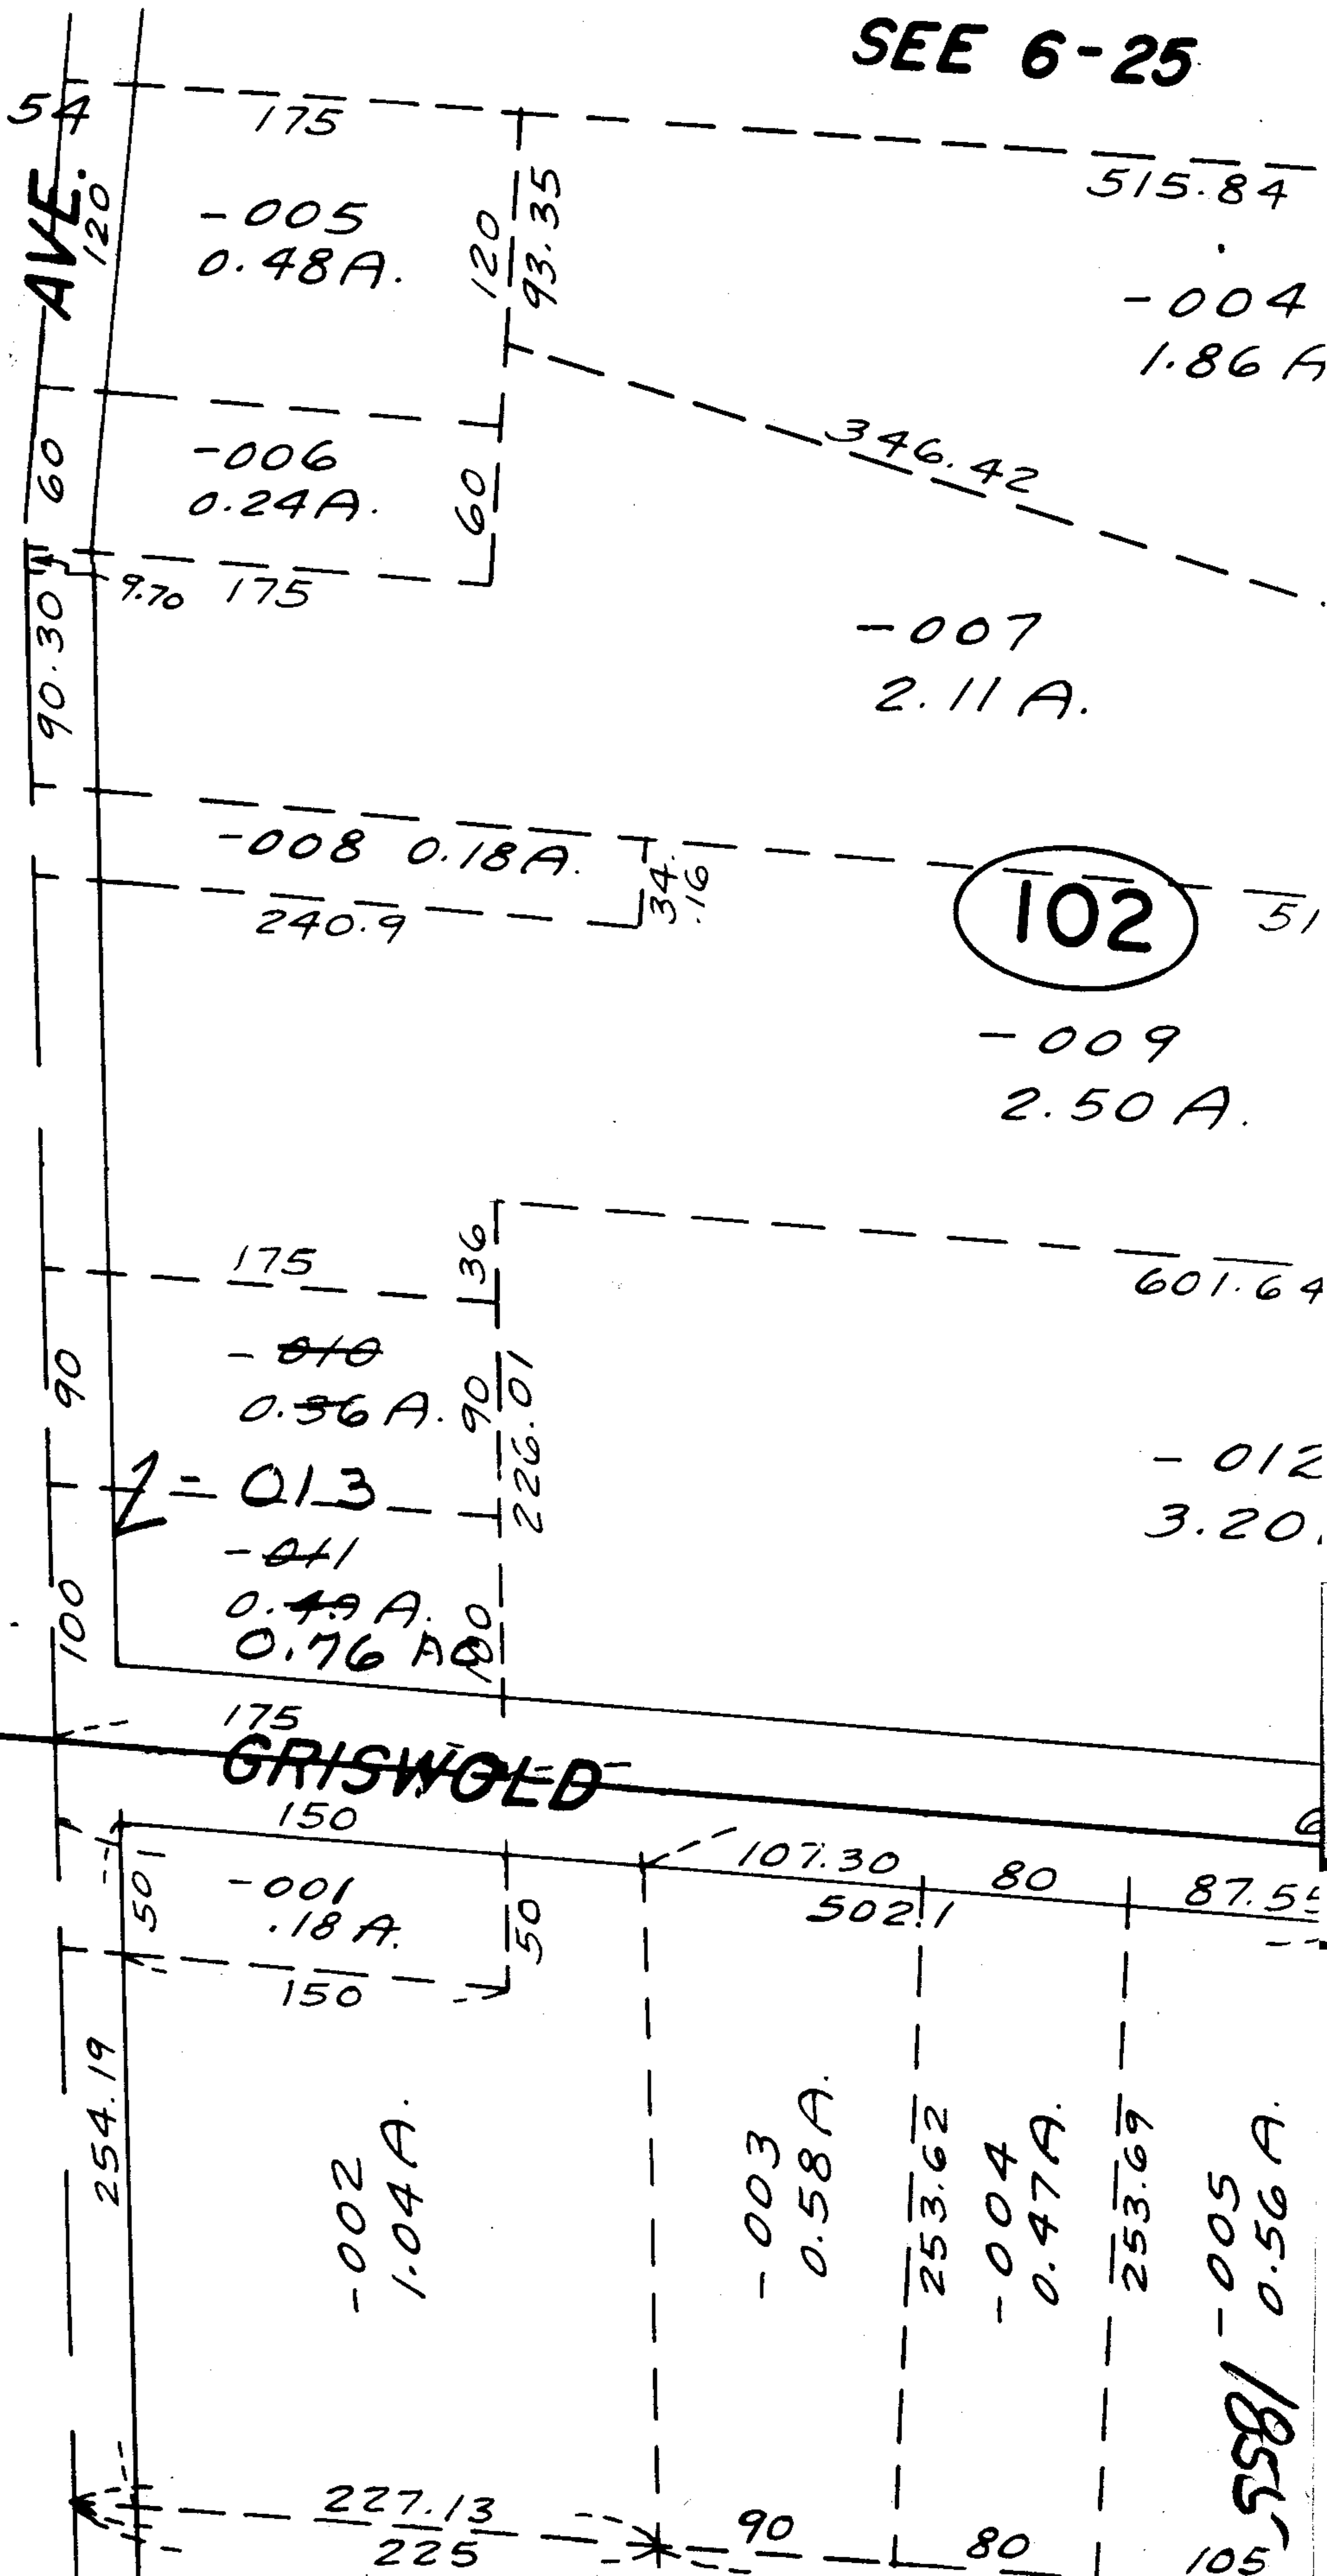

#1855  
**APPROVED**  
**LORAIN CO.**  
**MAP DEPT.**  
 DATE 6-12-68  
 6-43  
 BY L.W. Hall

Done 7-20-68

Jimi Grace  
6-43

1855  
105.5581