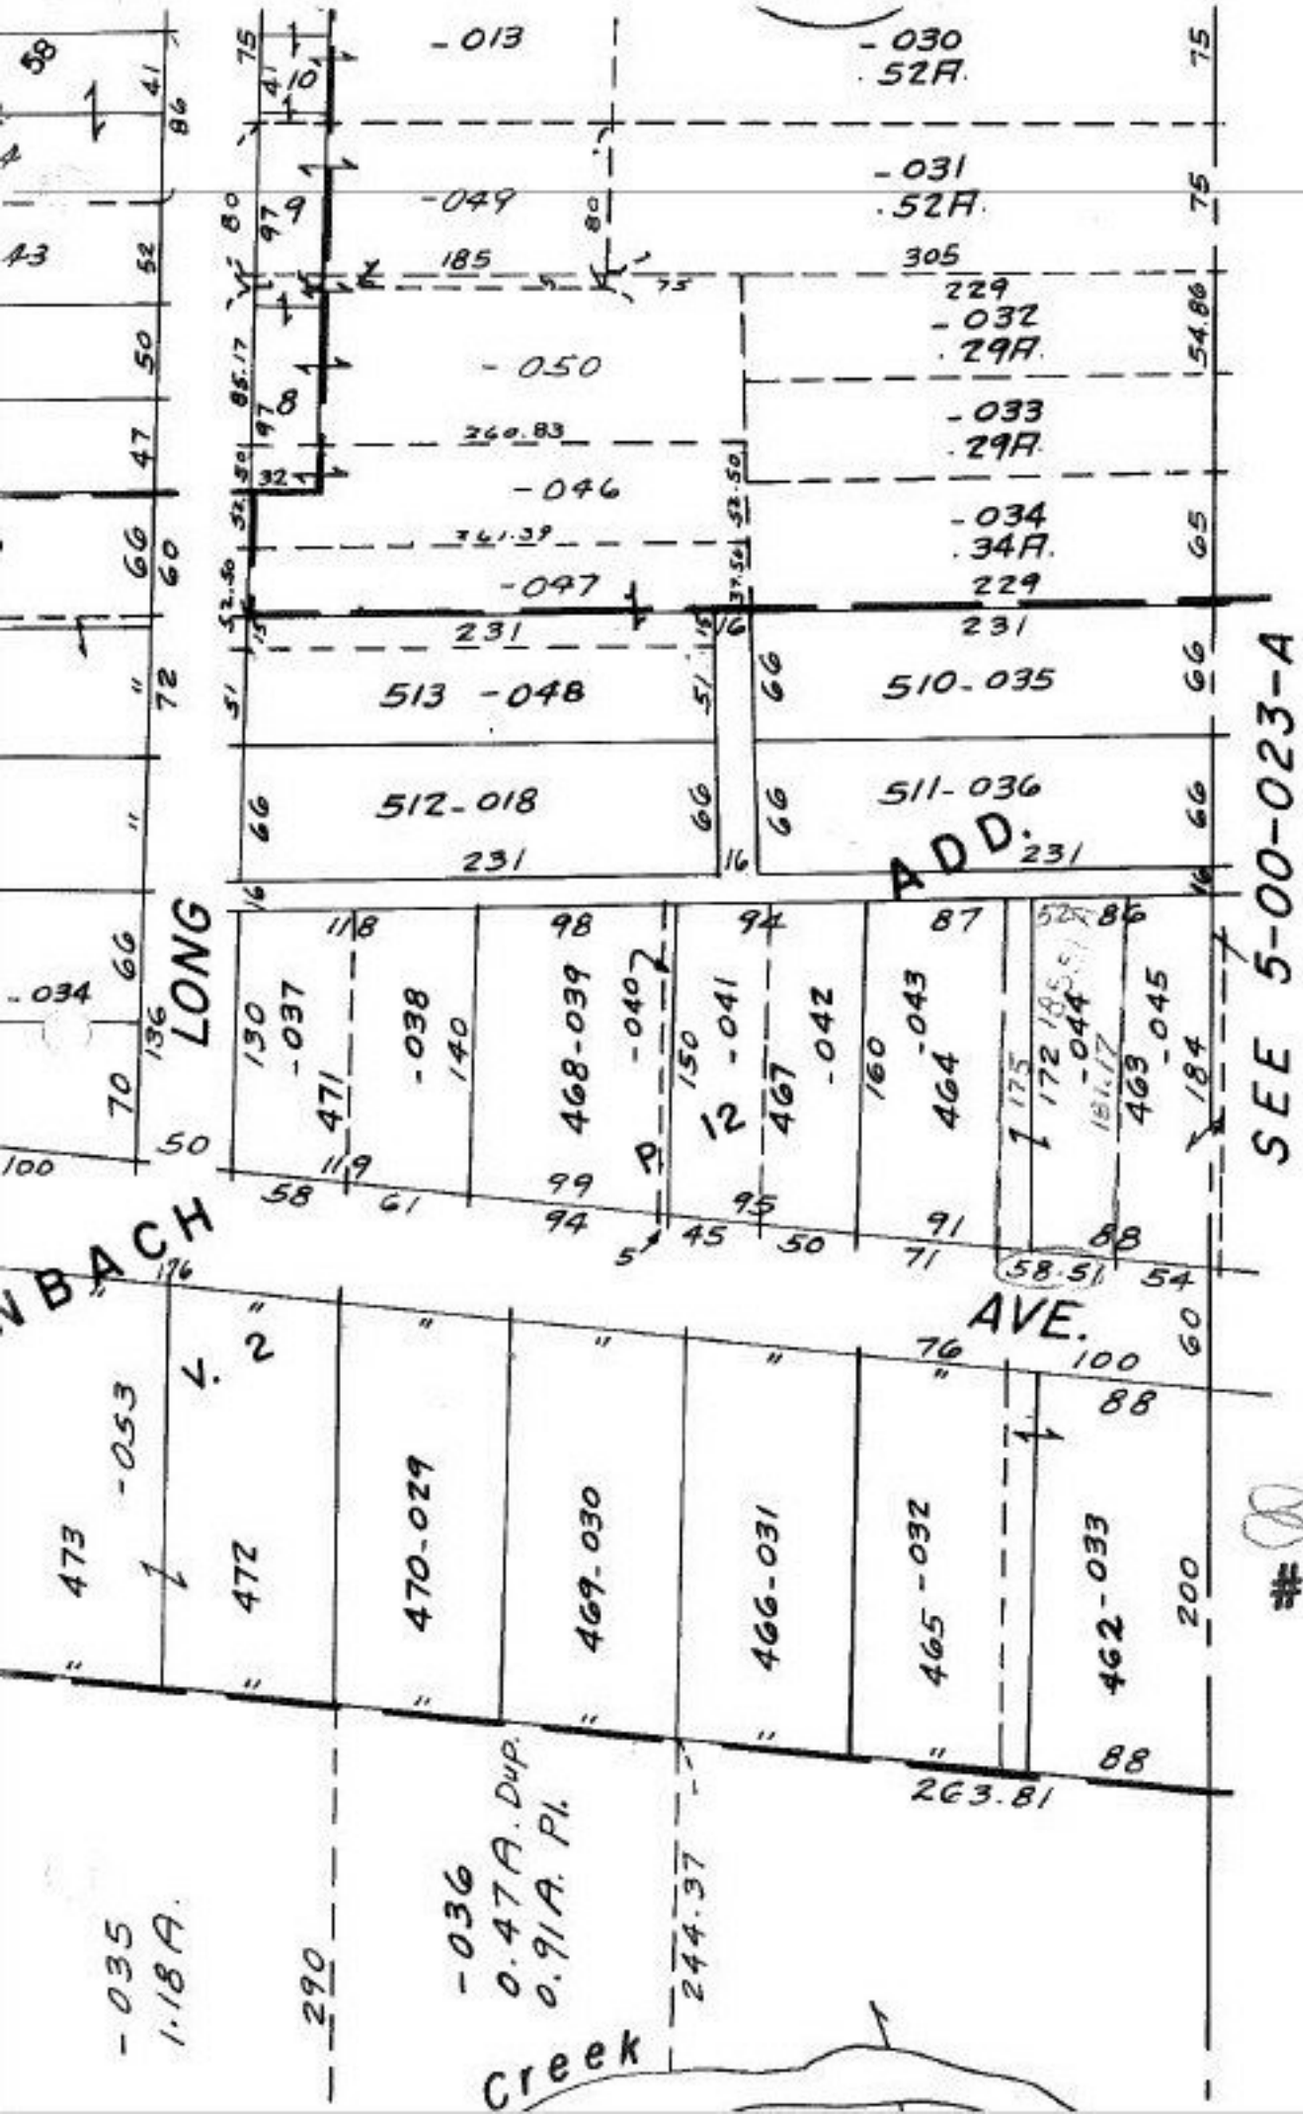

SEE SURVEY BY
K.E. McCARTNEY
JAMES B. ROBERTS 4279 RS
CL 1: 142857

PRIOR INST. REF.- 1349/461

SH 10/12/89

#18551-A

APPROVED
LORAIN CO.
MAP DEPT.

DATE 7-28-89

PAGE 5-00-018-B

BY T. McNair

VOID AFTER 18551-A