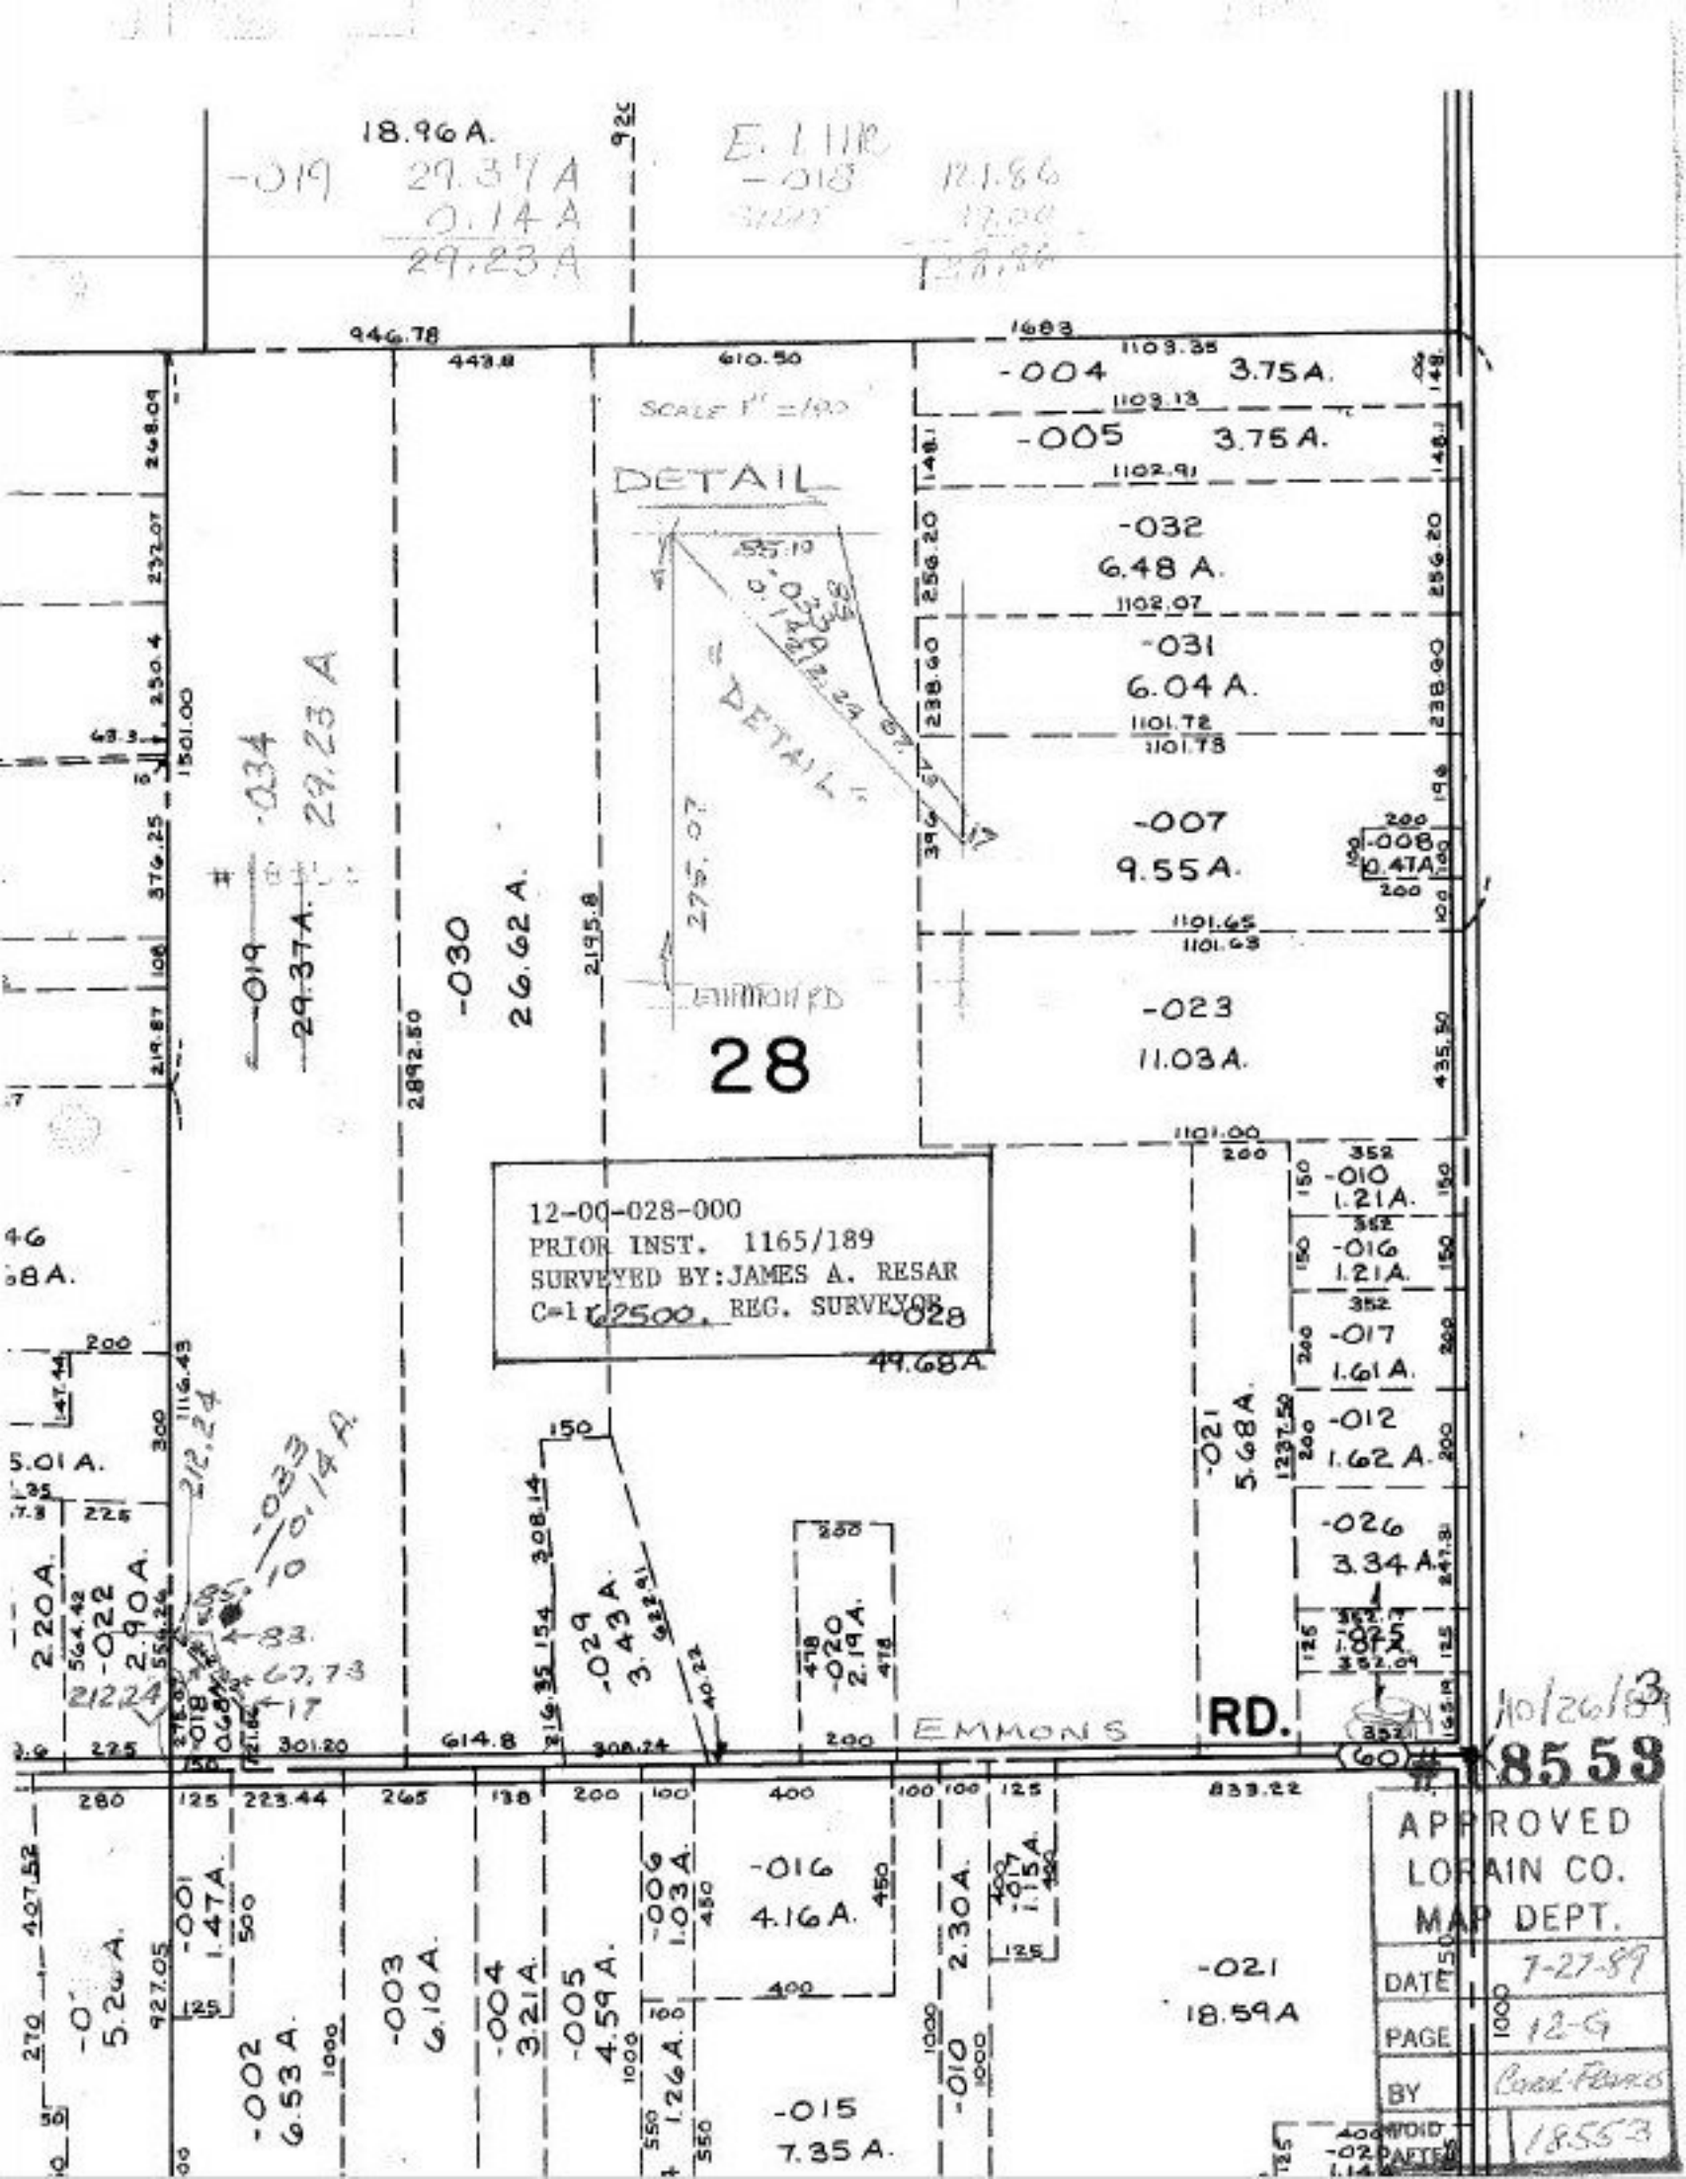
18.96 A.
-019 29.37A
0.14 A
29.23 A
E. LINE
-018 12.1.66
946.78
443.8
610.50
1683
-004 3.75 A.
-005 3.75 A.
SCALE 1" = 100
DETAIL
-032
6.48 A.
-031
6.04 A.
-007
9.55 A.
-008
0.47A
-023
11.03A.
-034
29.23 A
-019
29.37A.
-030
26.62 A.
28
12-00-028-000
PRIOR INST. 1165/189
SURVEYED BY: JAMES A. RESAR
C-1 2500, REG. SURVEYOR
028
49.68A
-010
1.21A.
-016
1.21A.
-017
1.61A.
-012
1.62 A.
-021
5.68A.
-026
3.34A.
-033
0.14A
-022
2.90A.
-029
3.43A.
-020
2.19A.
EMMONS
RD.
60
10/26/83
8553
-001
1.47A.
-002
6.53A.
-003
6.10A.
-004
3.21A.
-005
4.59A.
-006
1.03A.
-016
4.16A.
-015
7.35A.
-010
2.30A.
-017
1.15A.
-021
18.59A
APPROVED
LORAIN CO.
MAP DEPT.
DATE 7-27-89
PAGE 12-9
BY Carol Flores
VOID PARTS 18553