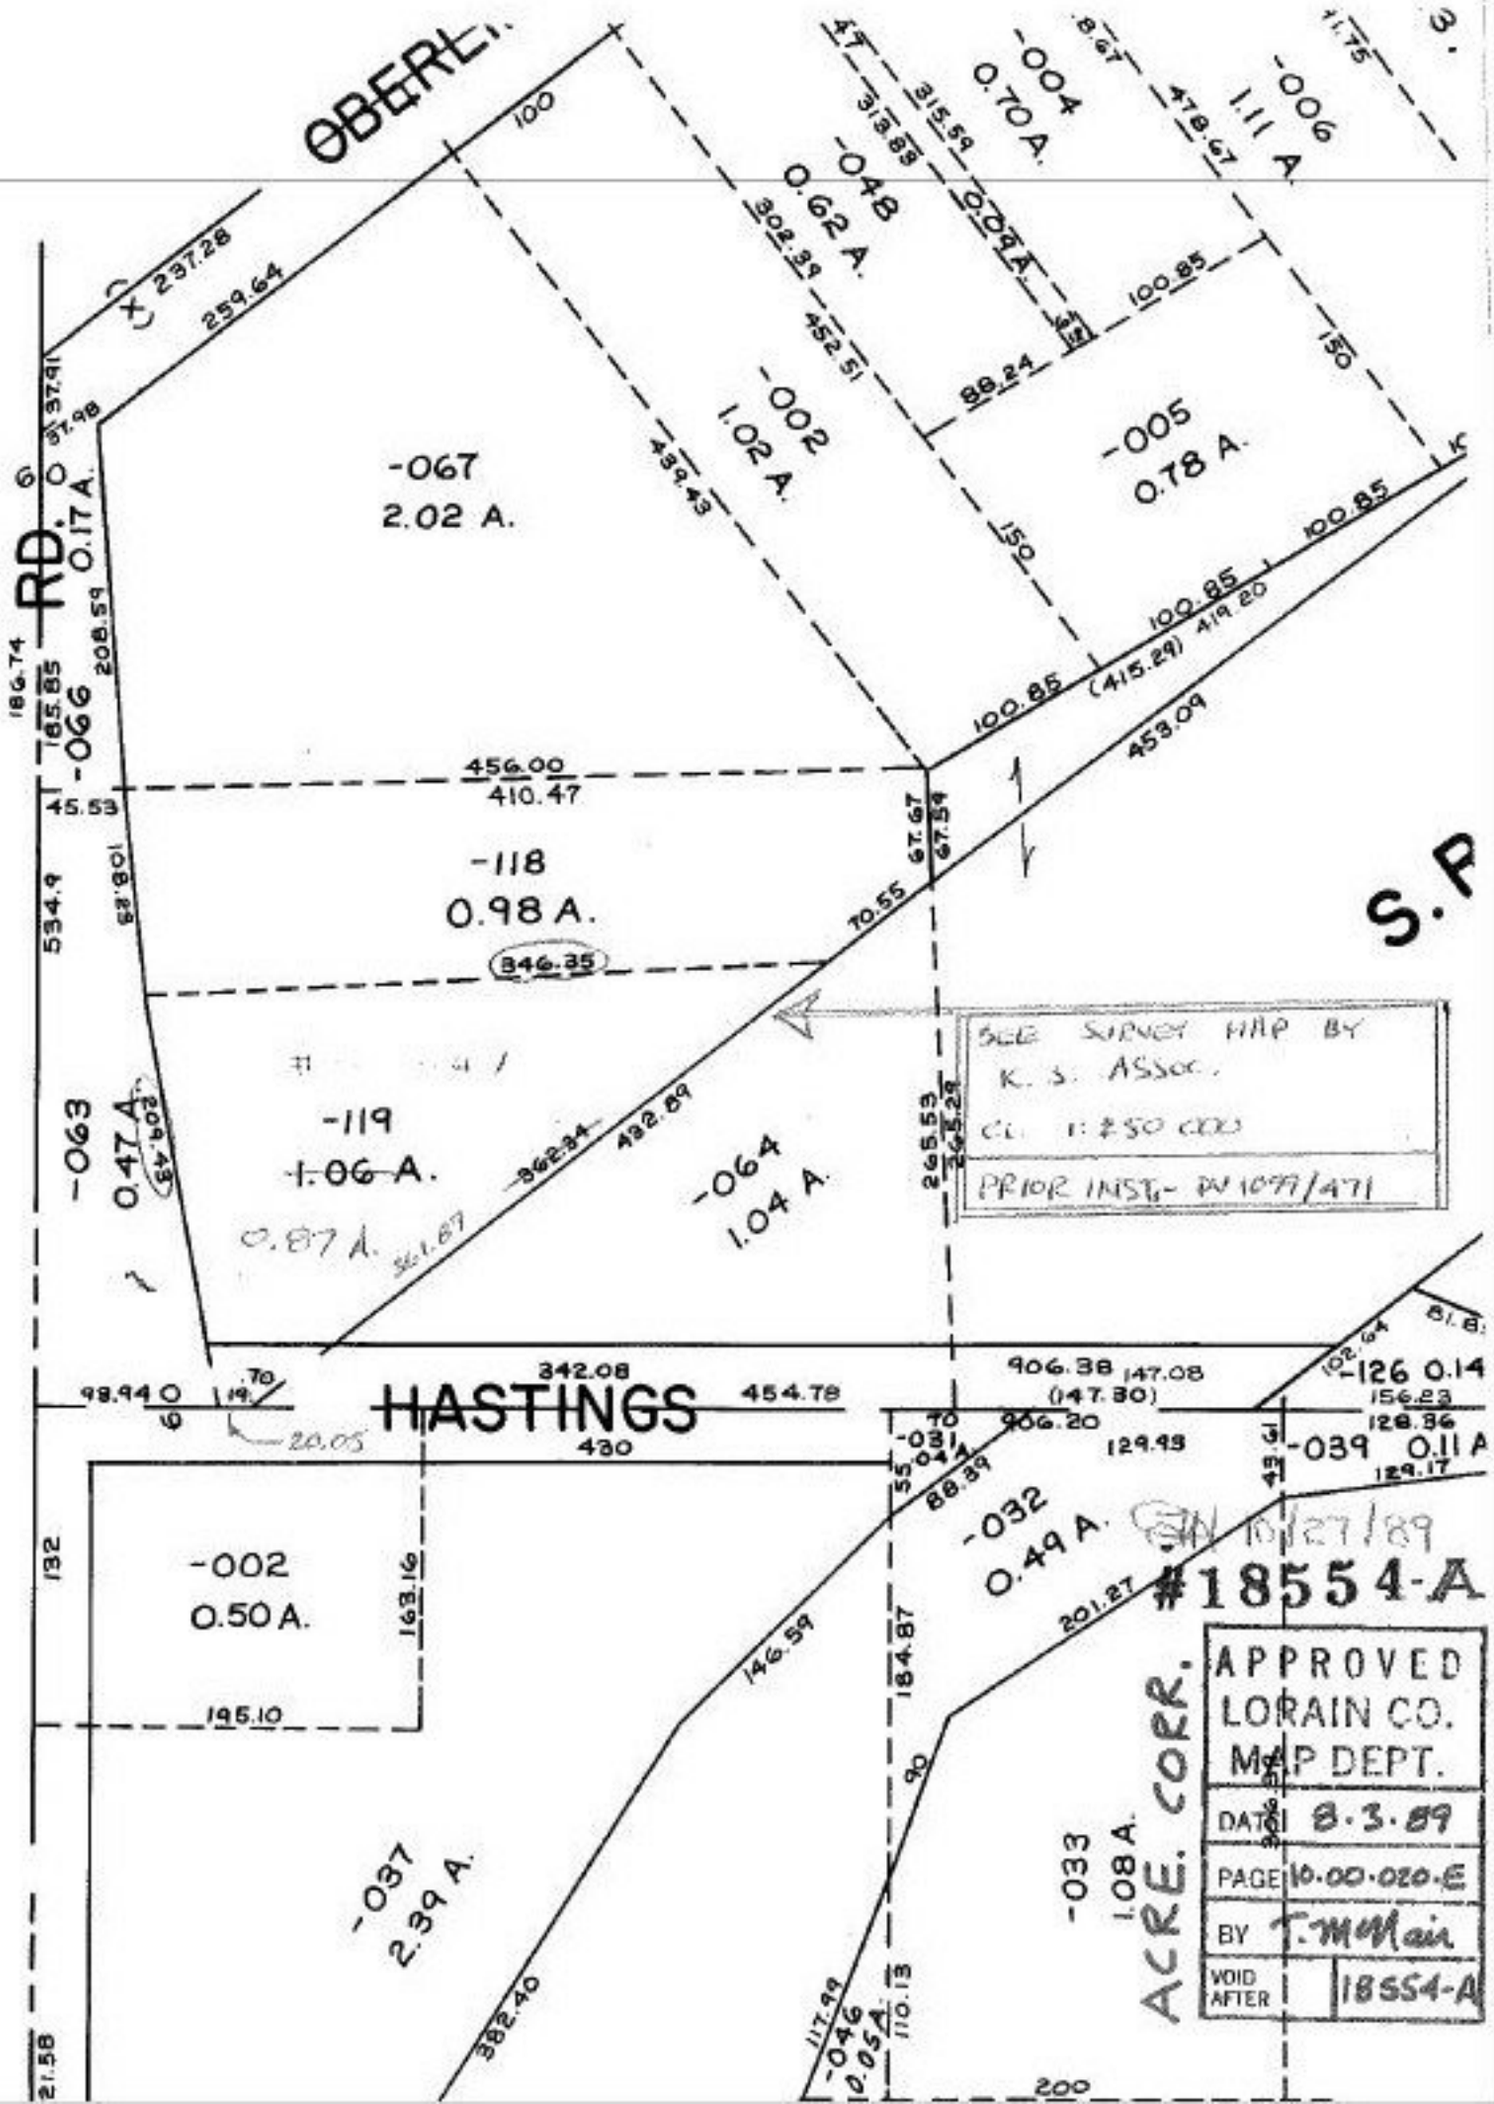
OBERL
RD.
HASTINGS
S.P
-067
2.02 A.
-002
1.02 A.
-004
0.70 A.
-006
1.11 A.
-048
0.62 A.
-005
0.78 A.
-066
0.17 A.
-118
0.98 A.
-119
1.06 A.
0.87 A.
-063
0.47 A.
-064
1.04 A.
-002
0.50 A.
-037
2.39 A.
-032
0.49 A.
-033
1.08 A.
-126 0.14
-039 0.11 A
SEE SURVEY MAP BY
K. S. ASSOC.
CL. 1:250 000
PRIOR INST.- DV 1077/471
#18554-A
APPROVED
LORAIN CO.
MAP DEPT.
DATE 8.3.89
PAGE 10.00.020.E
BY T. McMain
VOID AFTER 18554-A
ACRE. CORR.