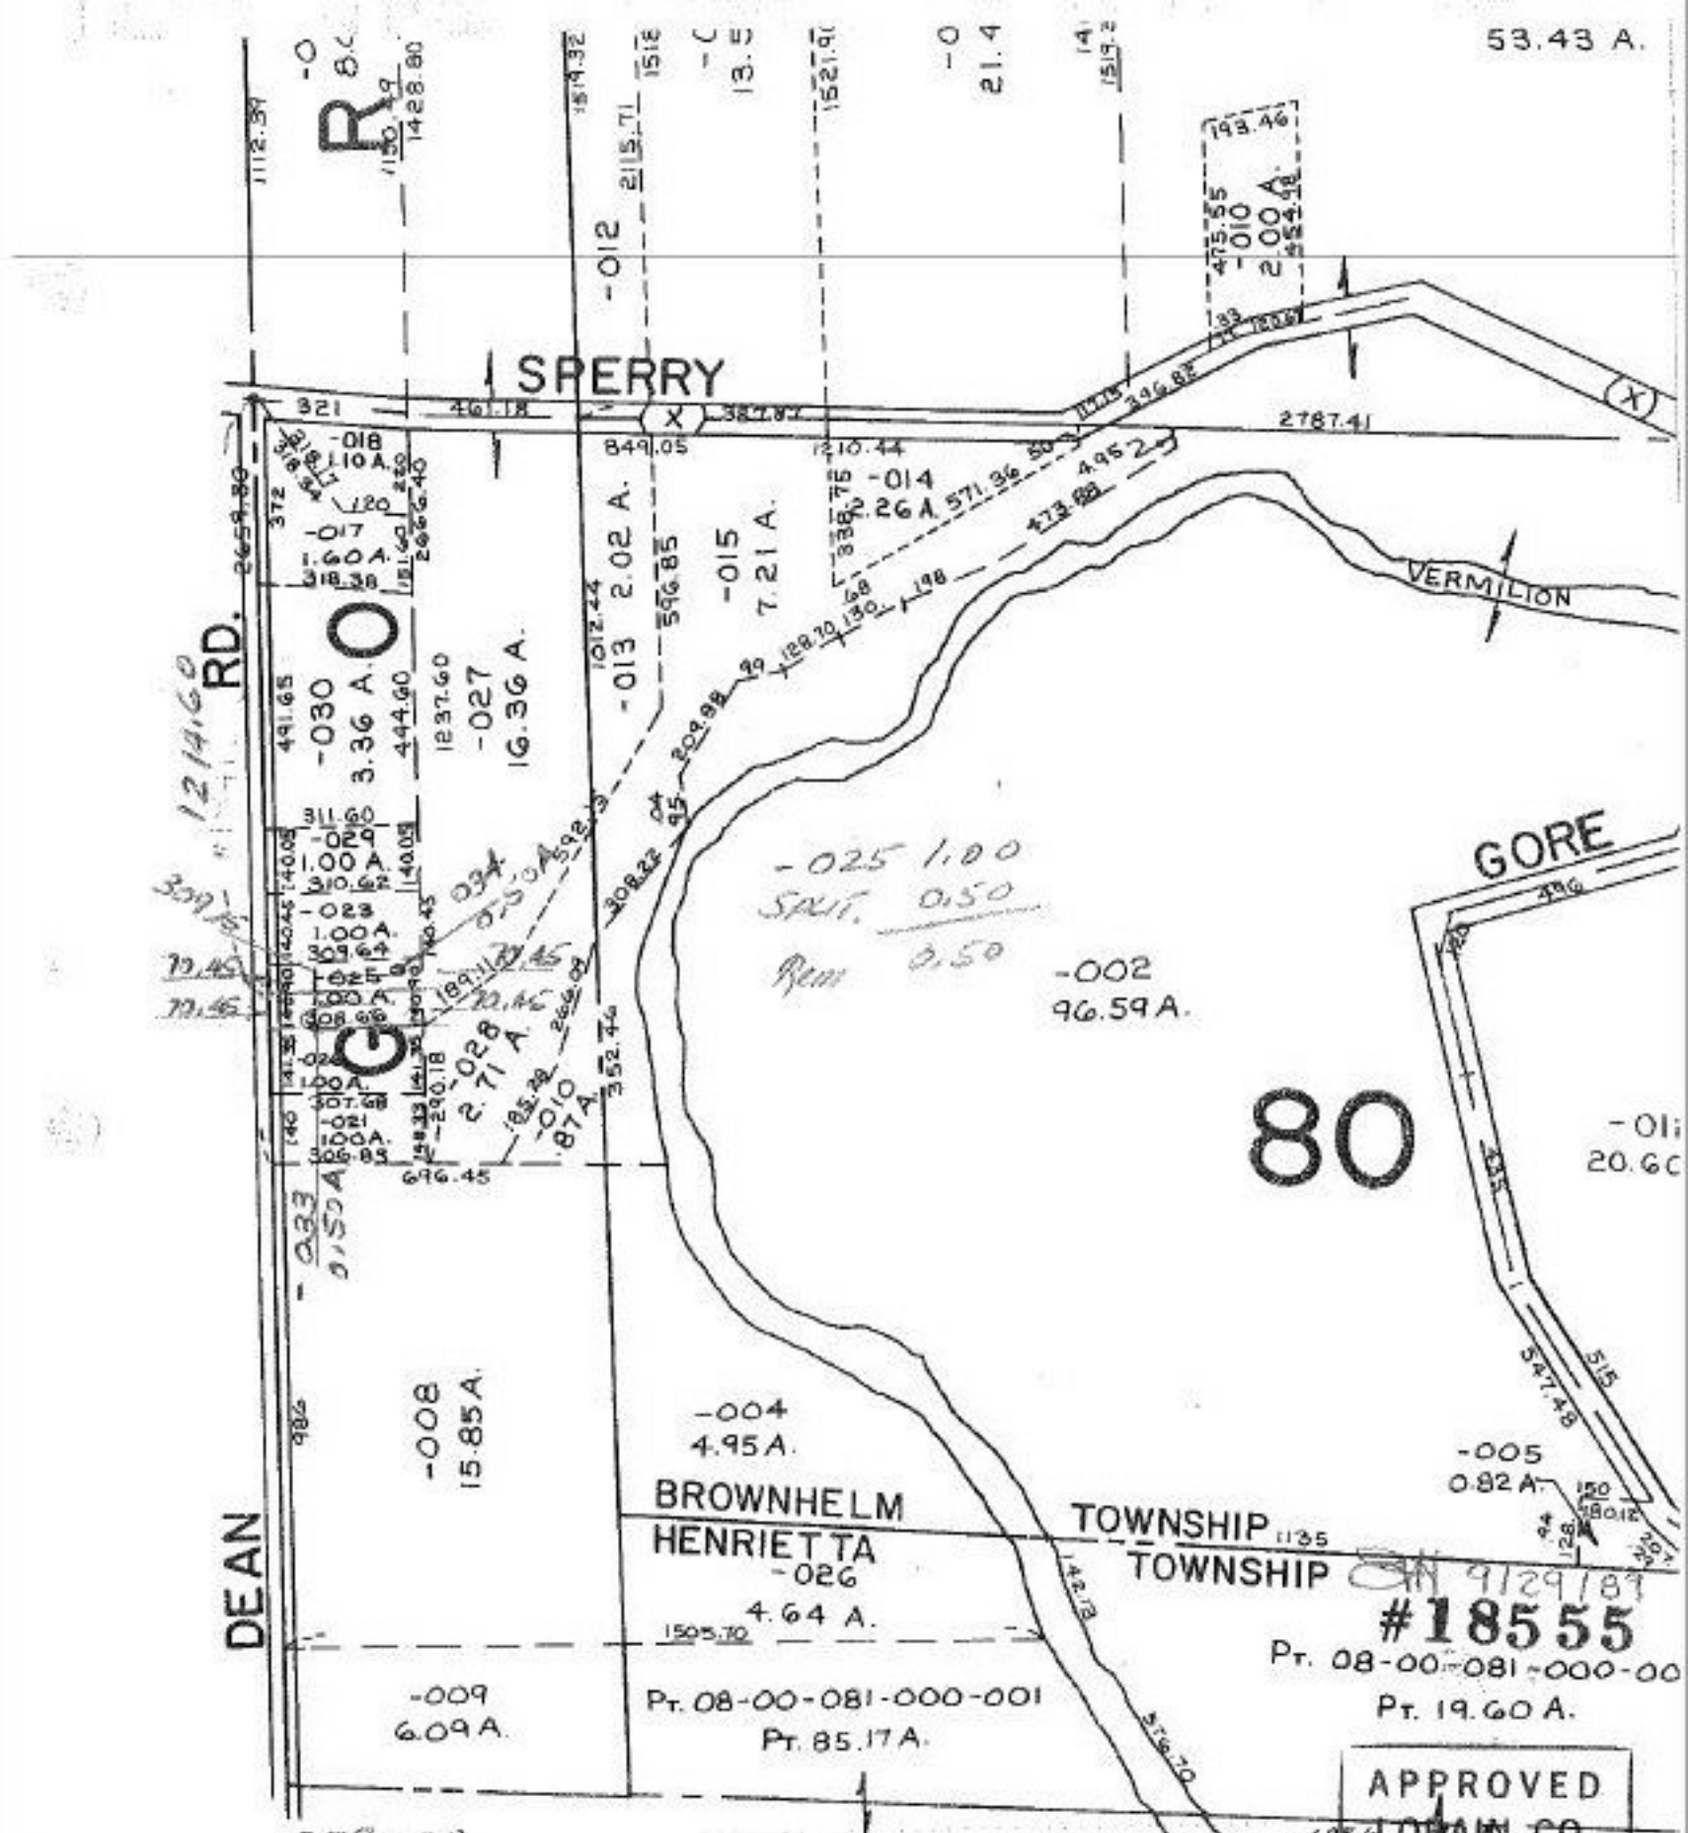

372.00
491.65
1144.15
70.45 SPLIT PARCEL
1214.60

01-20-026-000-
PRIOR INST. 1236/303
SURVEYED BY: PATRICK A. McGANNON
C=1:333,333. REG. SURVEYOR

APPROVED
LORAIN CO.
MAP DEPT.
DATE 8-3-89
PAGE 1-I
BY Carolyn Francis
VOID AFTER # 18555