SEE 4-I

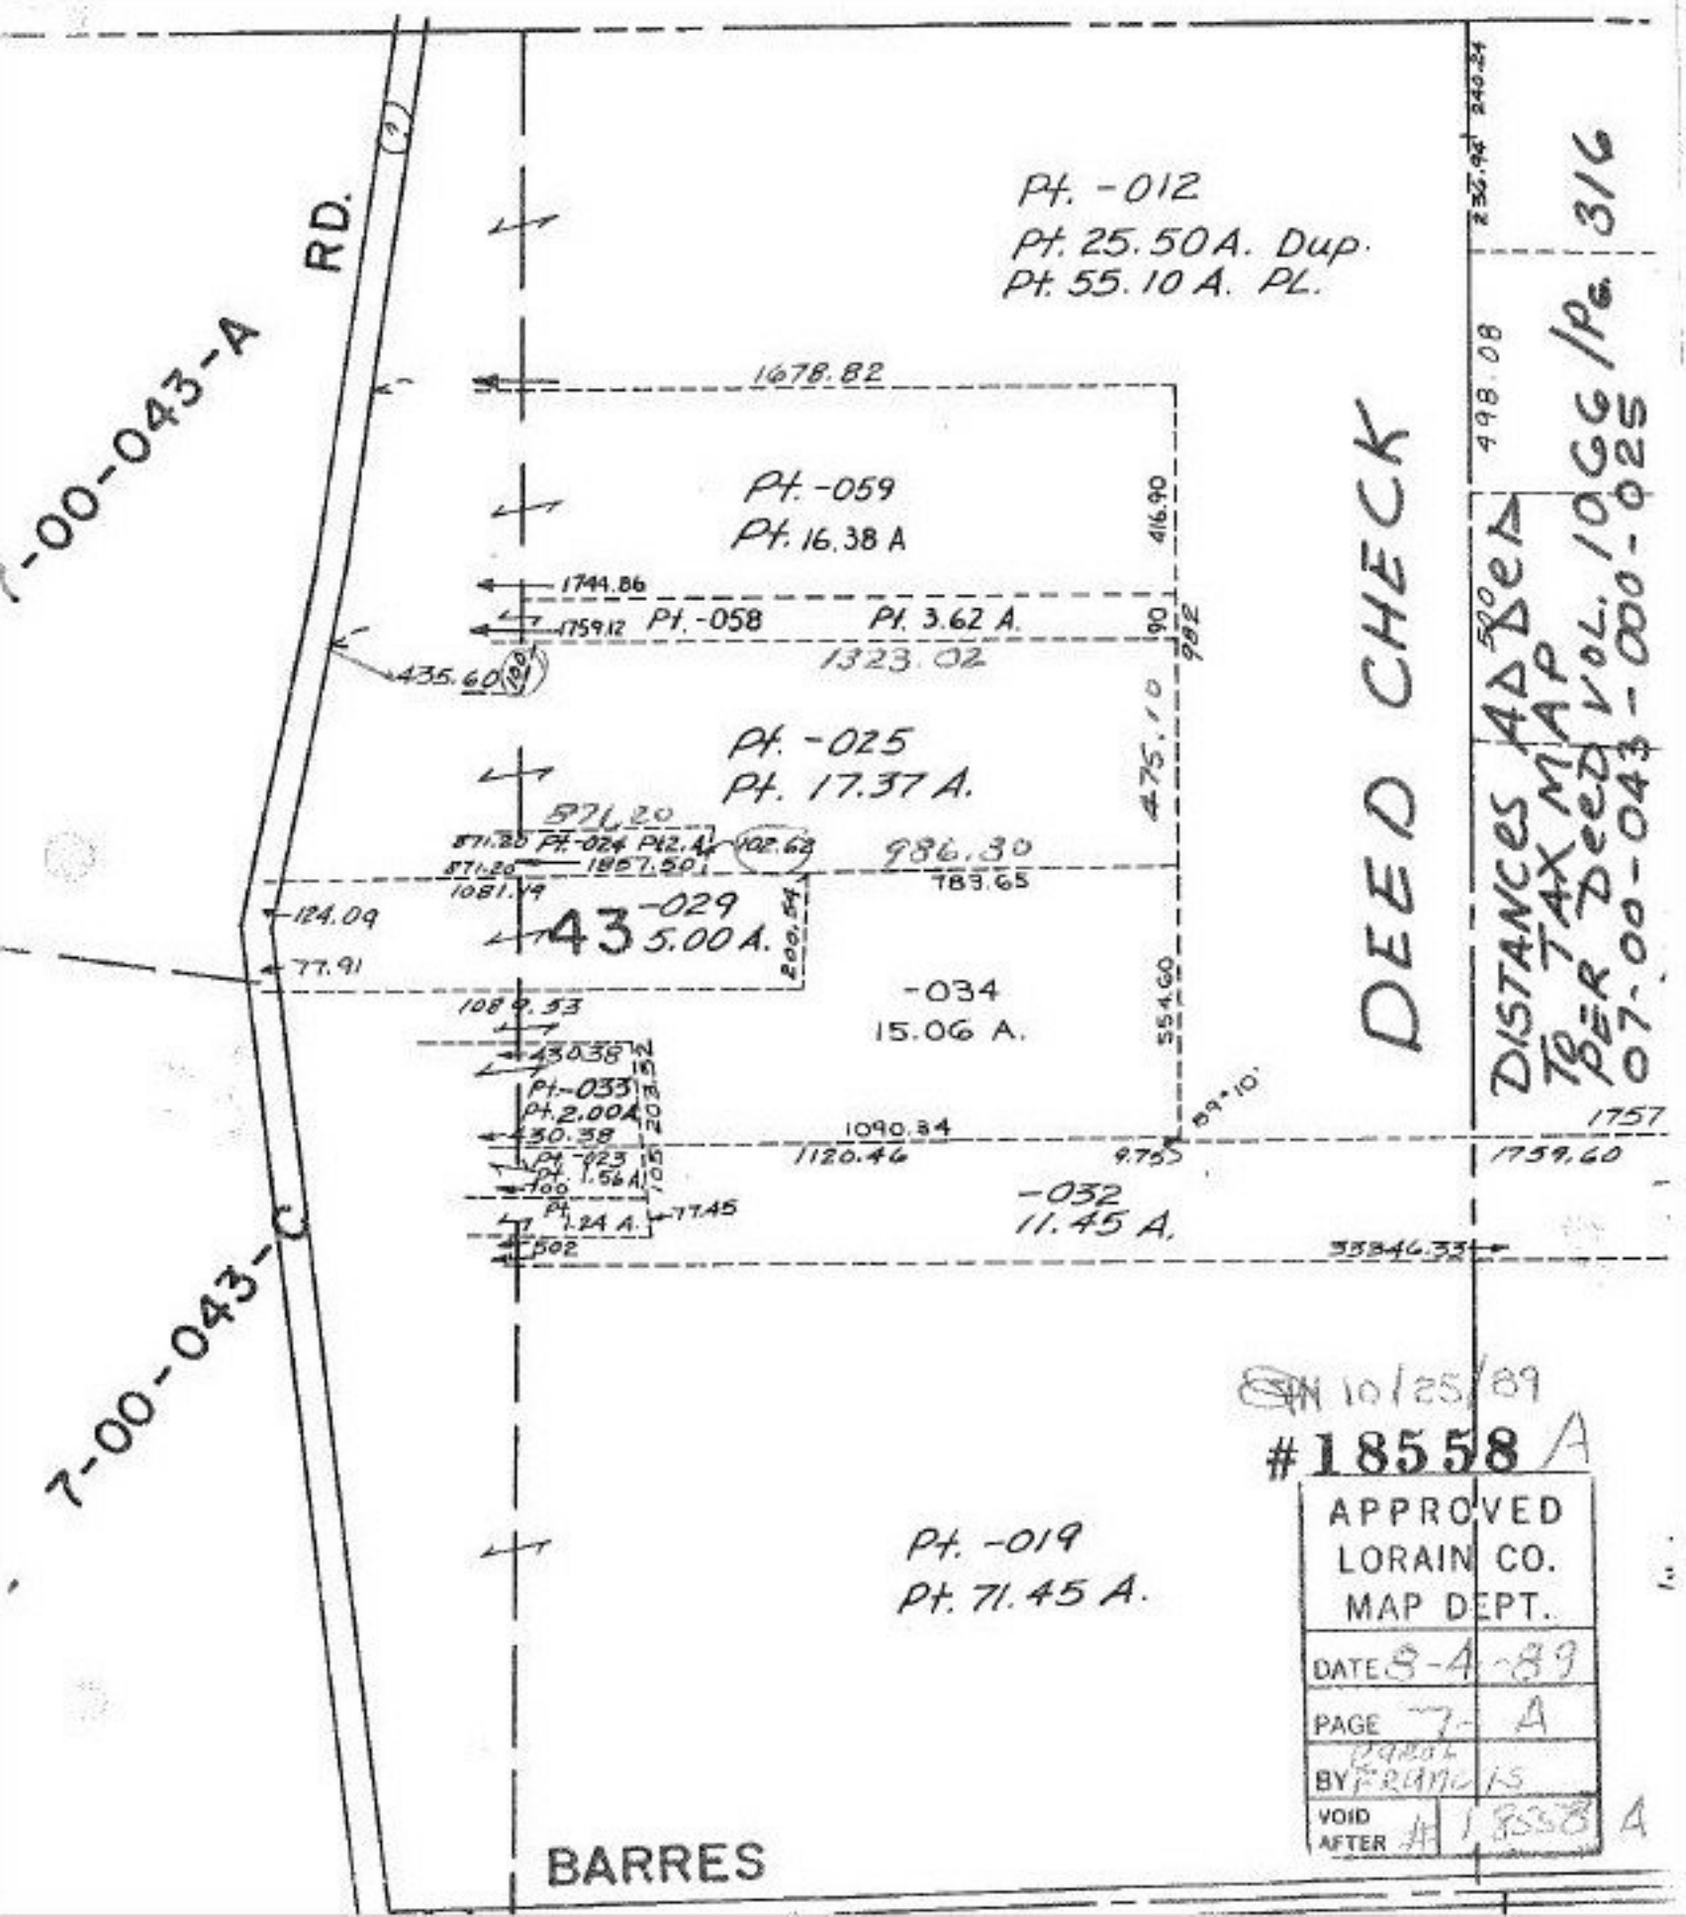

SN 10/25/89

#18558 A

APPROVED
LORAIN CO.
MAP DEPT.

DATE 8-4-89

PAGE 7- A

BY PARCEL IS

VOID AFTER AH 18558 A