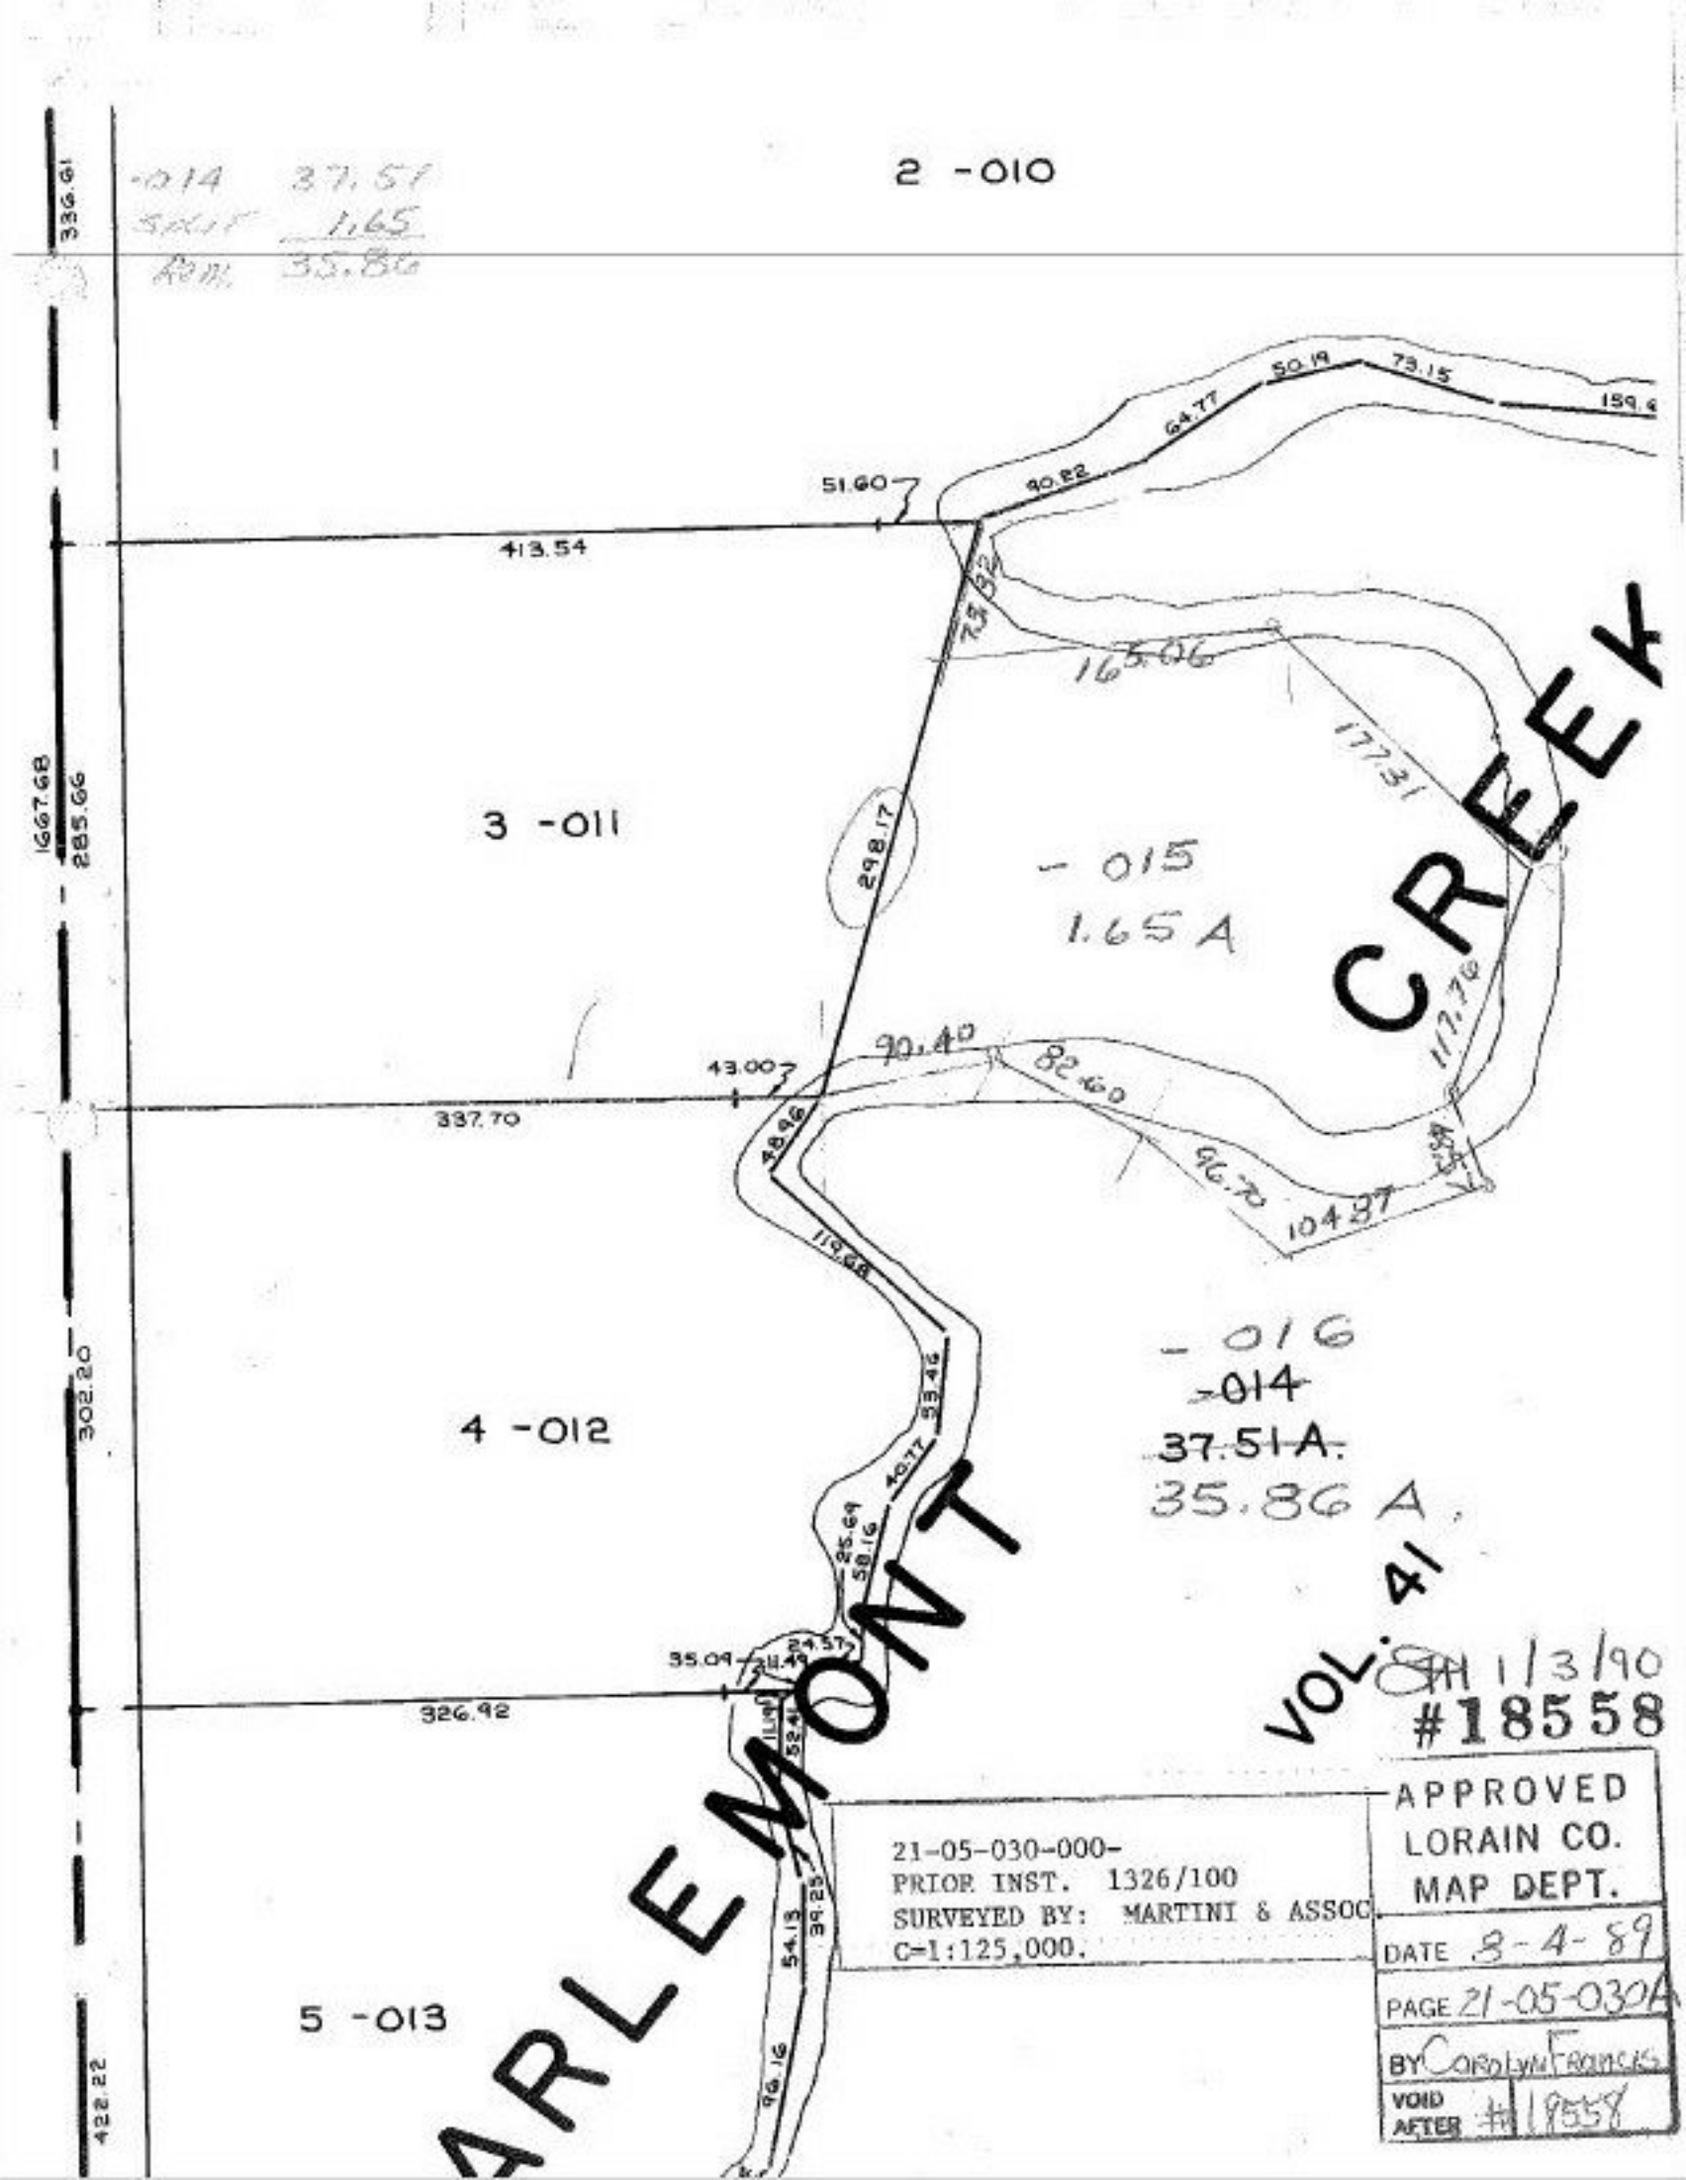
-014 37.51
SAVE 1.65
REM. 35.86
2 -010
336.61
51.60
90.82
64.77
50.19
73.15
159.6
413.54
73.82
165.06
177.31
1667.68
285.66
3 -011
298.17
-015
1.65A
CREEK
112.76
43.00
90.40
82.60
337.70
48.46
96.70
104.87
119.88
-016
-014
37.51A.
35.86A.
302.20
4 -012
33.46
40.77
25.69
58.16
35.09
24.37
326.92
52.41
54.13
39.25
96.16
422.22
5 -013
MARLEMONT
VOL. 41
1/3/90
#18558
21-05-030-000-
PRIOR INST. 1326/100
SURVEYED BY: MARTINI & ASSOC.
C=1:125,000.
APPROVED
LORAIN CO.
MAP DEPT.
DATE 8-4-89
PAGE 21-05-030A
BY Carolyn Francis
VOID AFTER #18558