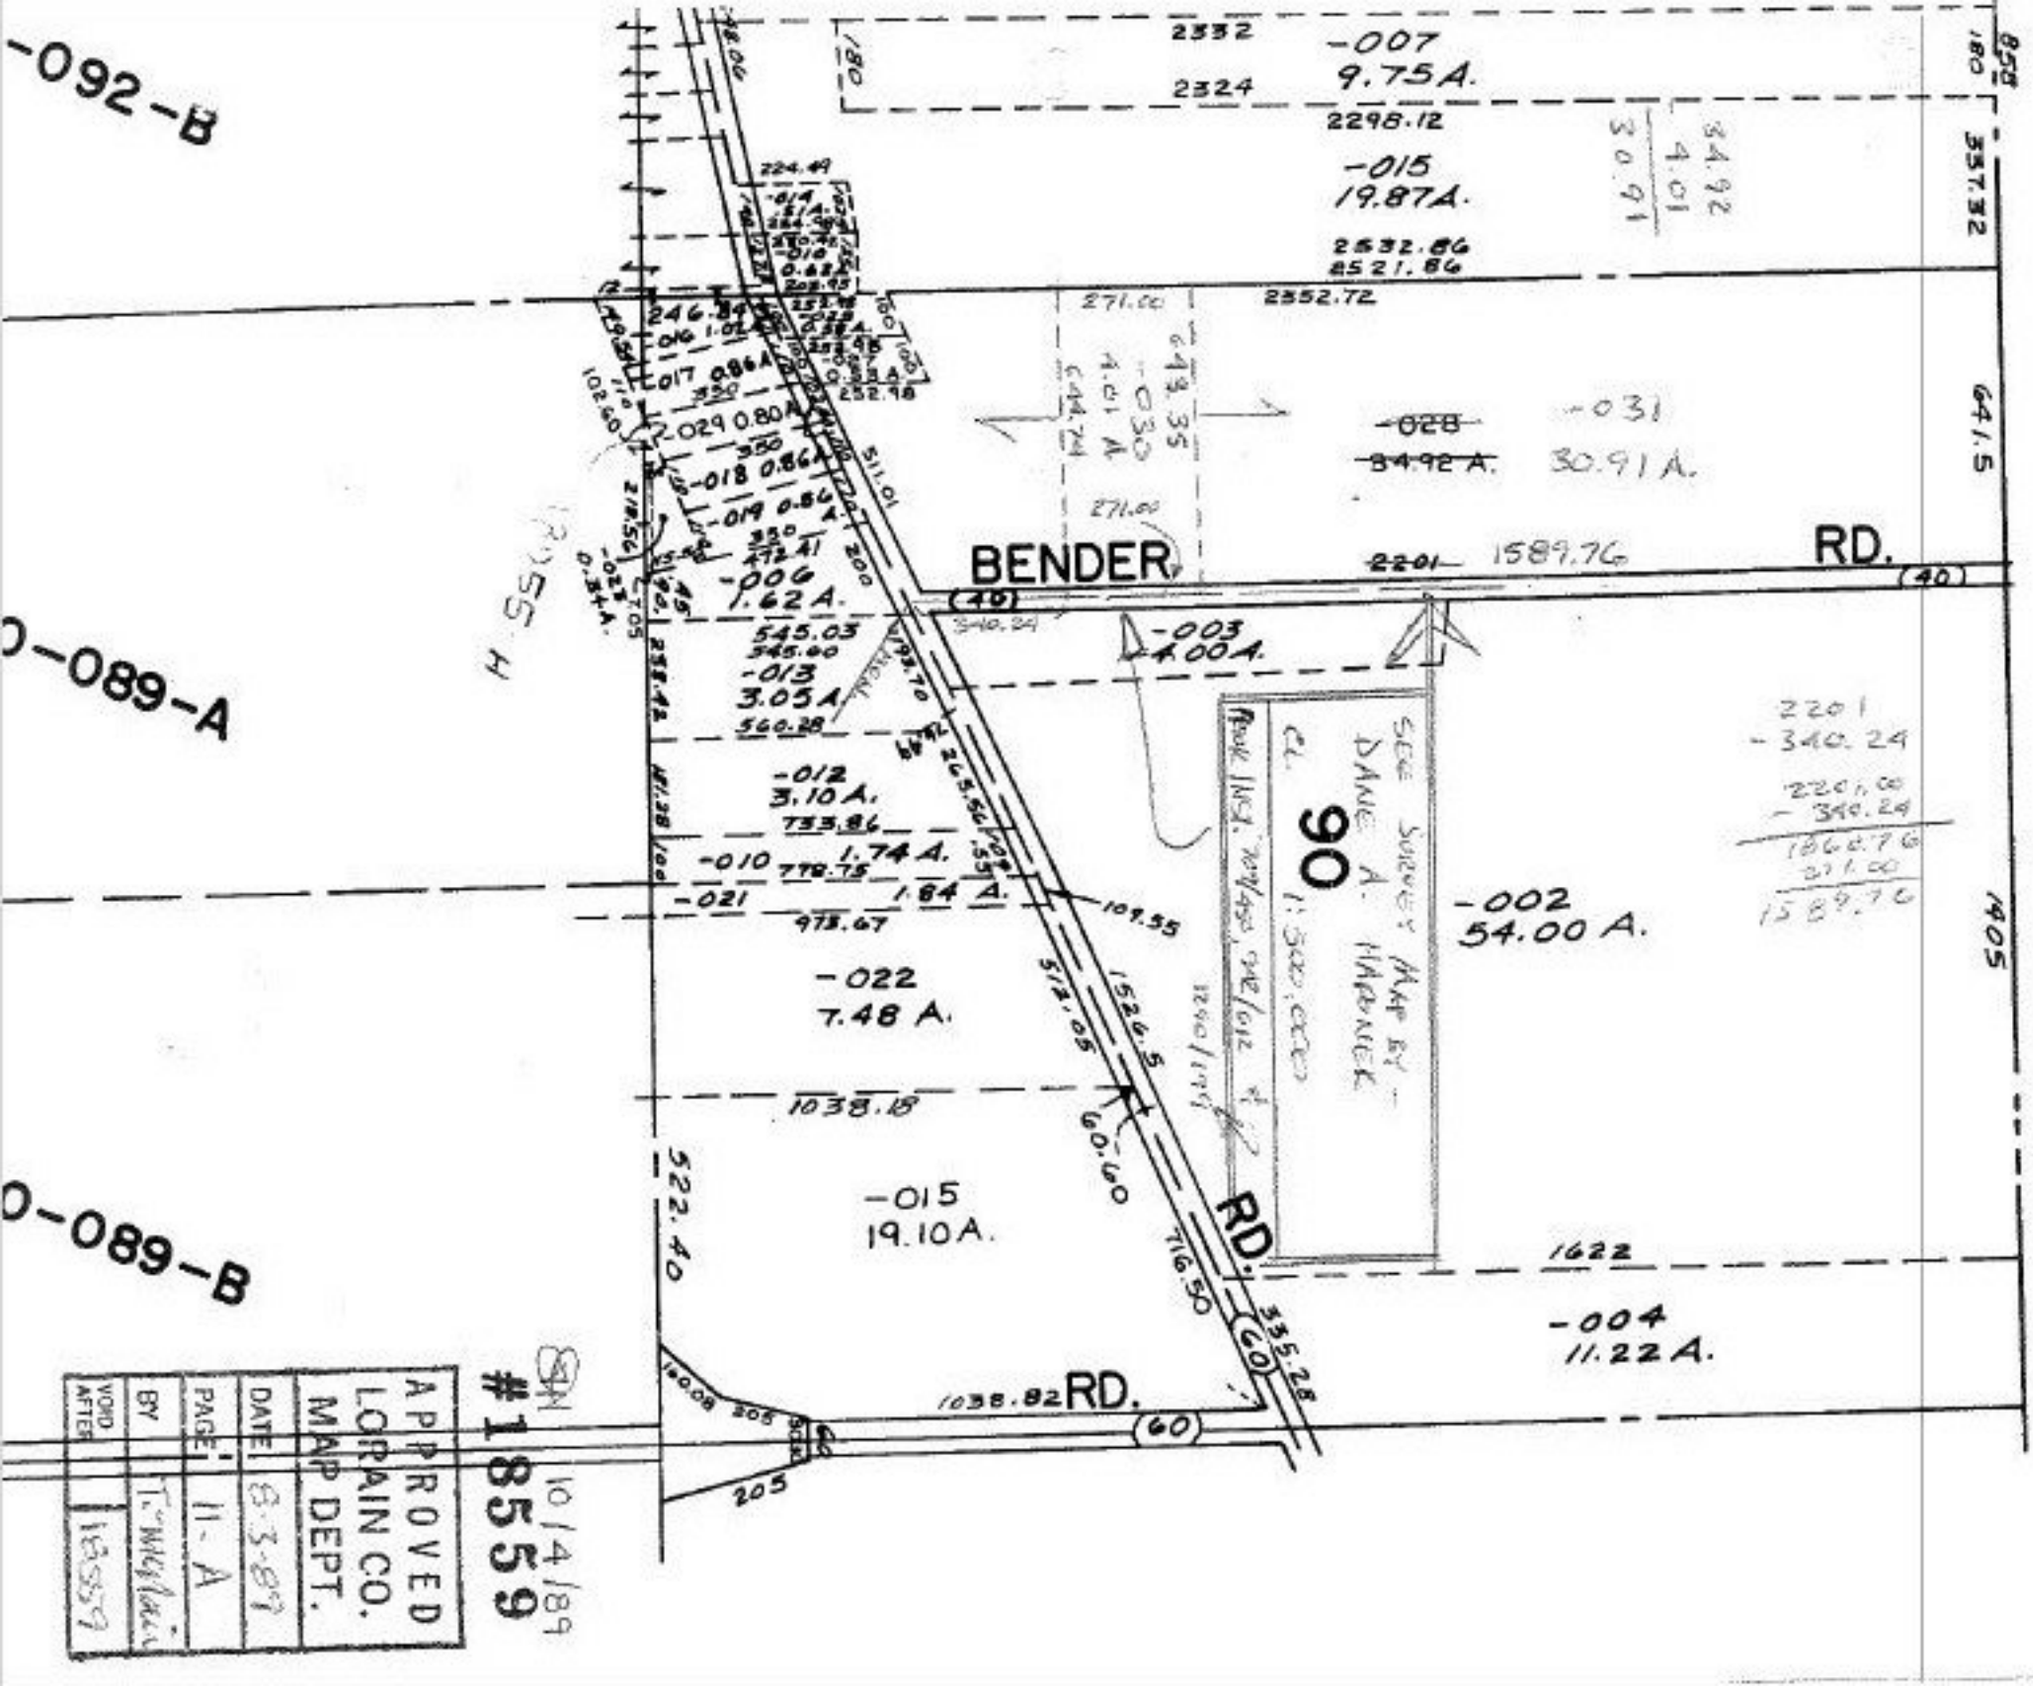
-092-B
-089-A
-089-B
BENDER
RD.
(40)
-007
9.75A.
2332
2324
2298.12
-015
19.87A.
2532.86
2521.86
2352.72
-028
34.92 A.
-031
30.91 A.
2201
1589.76
-003
4.00A.
-006
1.62 A.
-013
3.05A
-012
3.10 A.
-010
1.74 A.
-021
1.84 A.
-022
7.48 A.
-015
19.10A.
-002
54.00 A.
-004
11.22 A.
90
DANIEL A. HARNECK
Deed Inst. 207450, 242/612 & 1290/109
SEE SURVEY MAP BY
1622
1405
641.5
1038.82 RD.
(60)
522.40
1526.5
512.05
716.50
335.28
1038.18
973.67
770.75
733.86
560.28
545.03
345.00
340.24
271.00
205
#18559
10/4/89
APPROVED
LORAIN CO.
MAP DEPT.
DATE 8-3-89
PAGE 11-A
BY T. McWilliams
VOID AFTER 18559