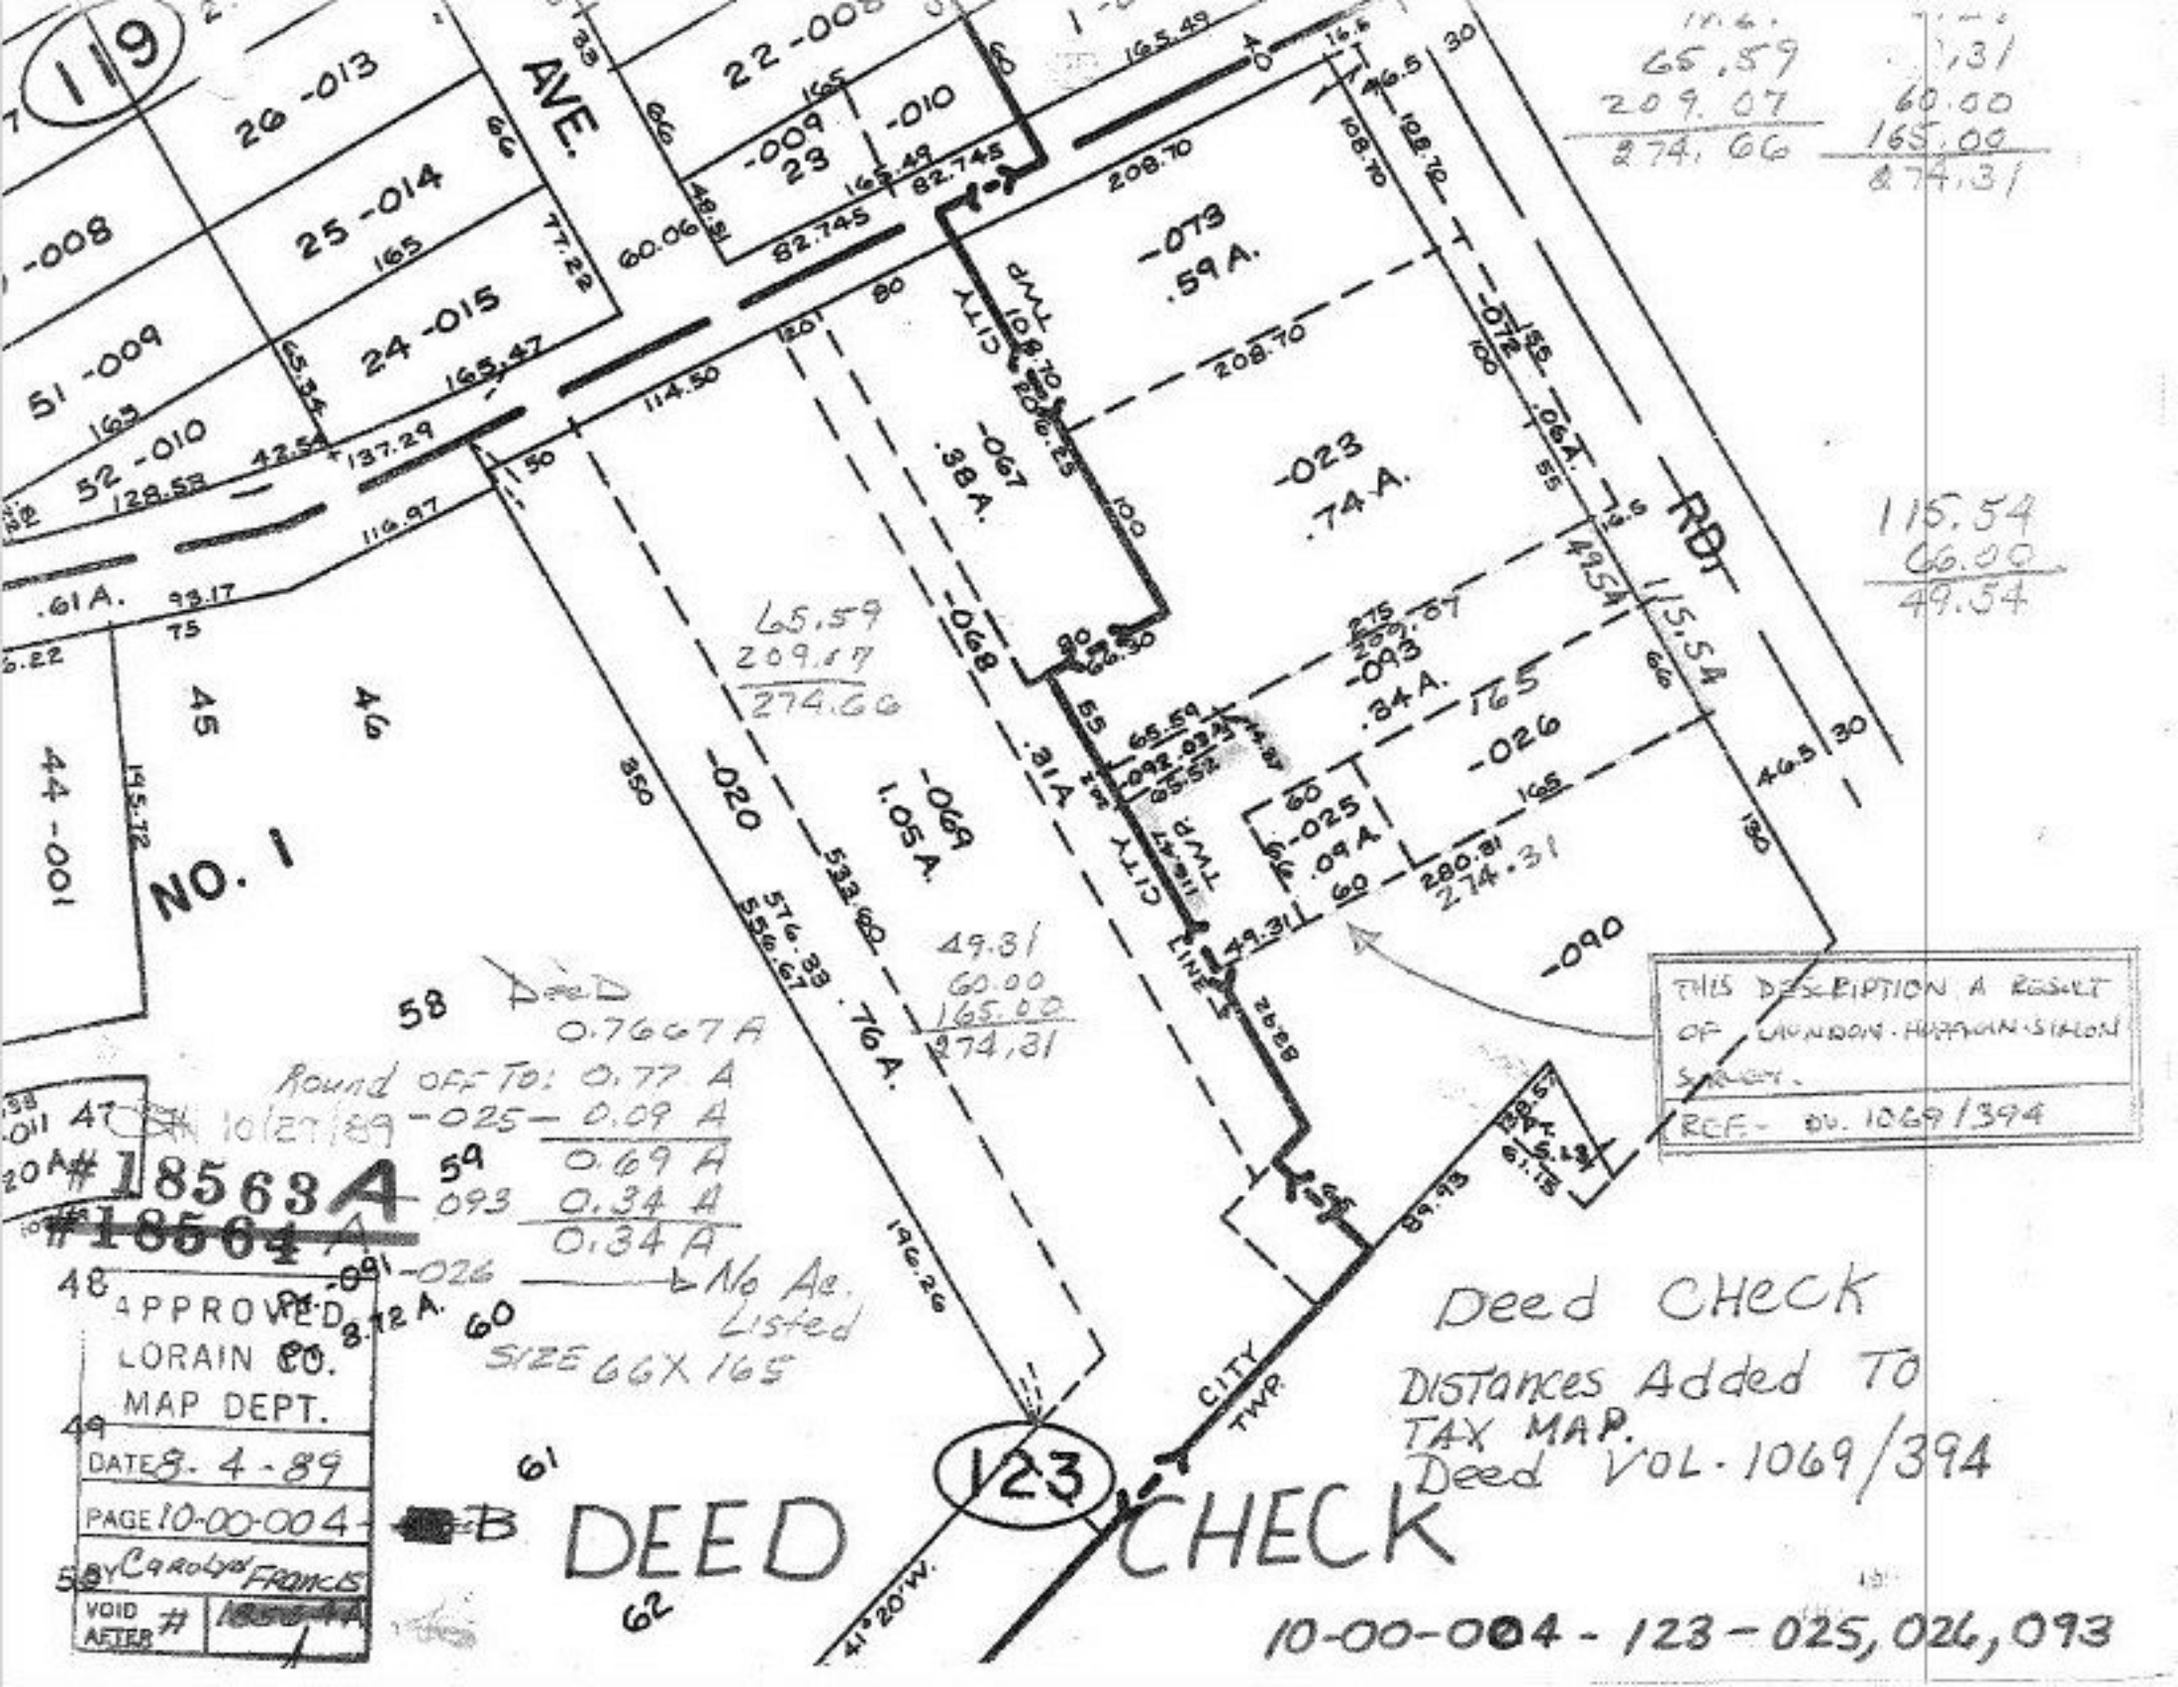
119
AVE.
26 -013
25 -014
24 -015
22 -008
-009
23
-010
-008
51 -009
52 -010
-073
.59 A.
-072
-067
.38 A.
-068
.31 A
-069
1.05 A.
-020
.76 A.
-023
.74 A.
-093
.34 A.
-026
-025
.09 A
-090
-091
8.72 A.
44 -001
45
46
NO. 1
58
59
60
61
62
123
RD.
CITY TWP.
CITY TWP
LINE
65.59
209.07
274.66
49.31
60.00
165.00
274.31
115.54
66.00
49.54
280.81
274.31
533.60
576.33
550.67
146.26
89.93
208.70
82.745
165.49
114.50
137.29
114.97
128.58
42.54
65.34
165.47
93.17
195.72
350
41°20'W.
DEED 0.7667 A
Round off to: 0.77 A
10/27/89 -025- 0.09 A
0.69 A
093 0.34 A
0.34 A
No Ac. Listed
Size 66 X 165
#18563 A
#18564 A
APPROVED
LORAIN CO.
MAP DEPT.
DATE 8-4-89
PAGE 10-00-004
BY Carolyn Frances
VOID AFTER #
THIS DESCRIPTION A RESULT OF CAUNDAY-HUFFMAN-SIMON SURVEY.
REF- DV. 1069/394
Deed Check
Distances Added To Tax Map.
Deed Vol. 1069/394
DEED CHECK
10-00-004 - 123 - 025, 026, 093