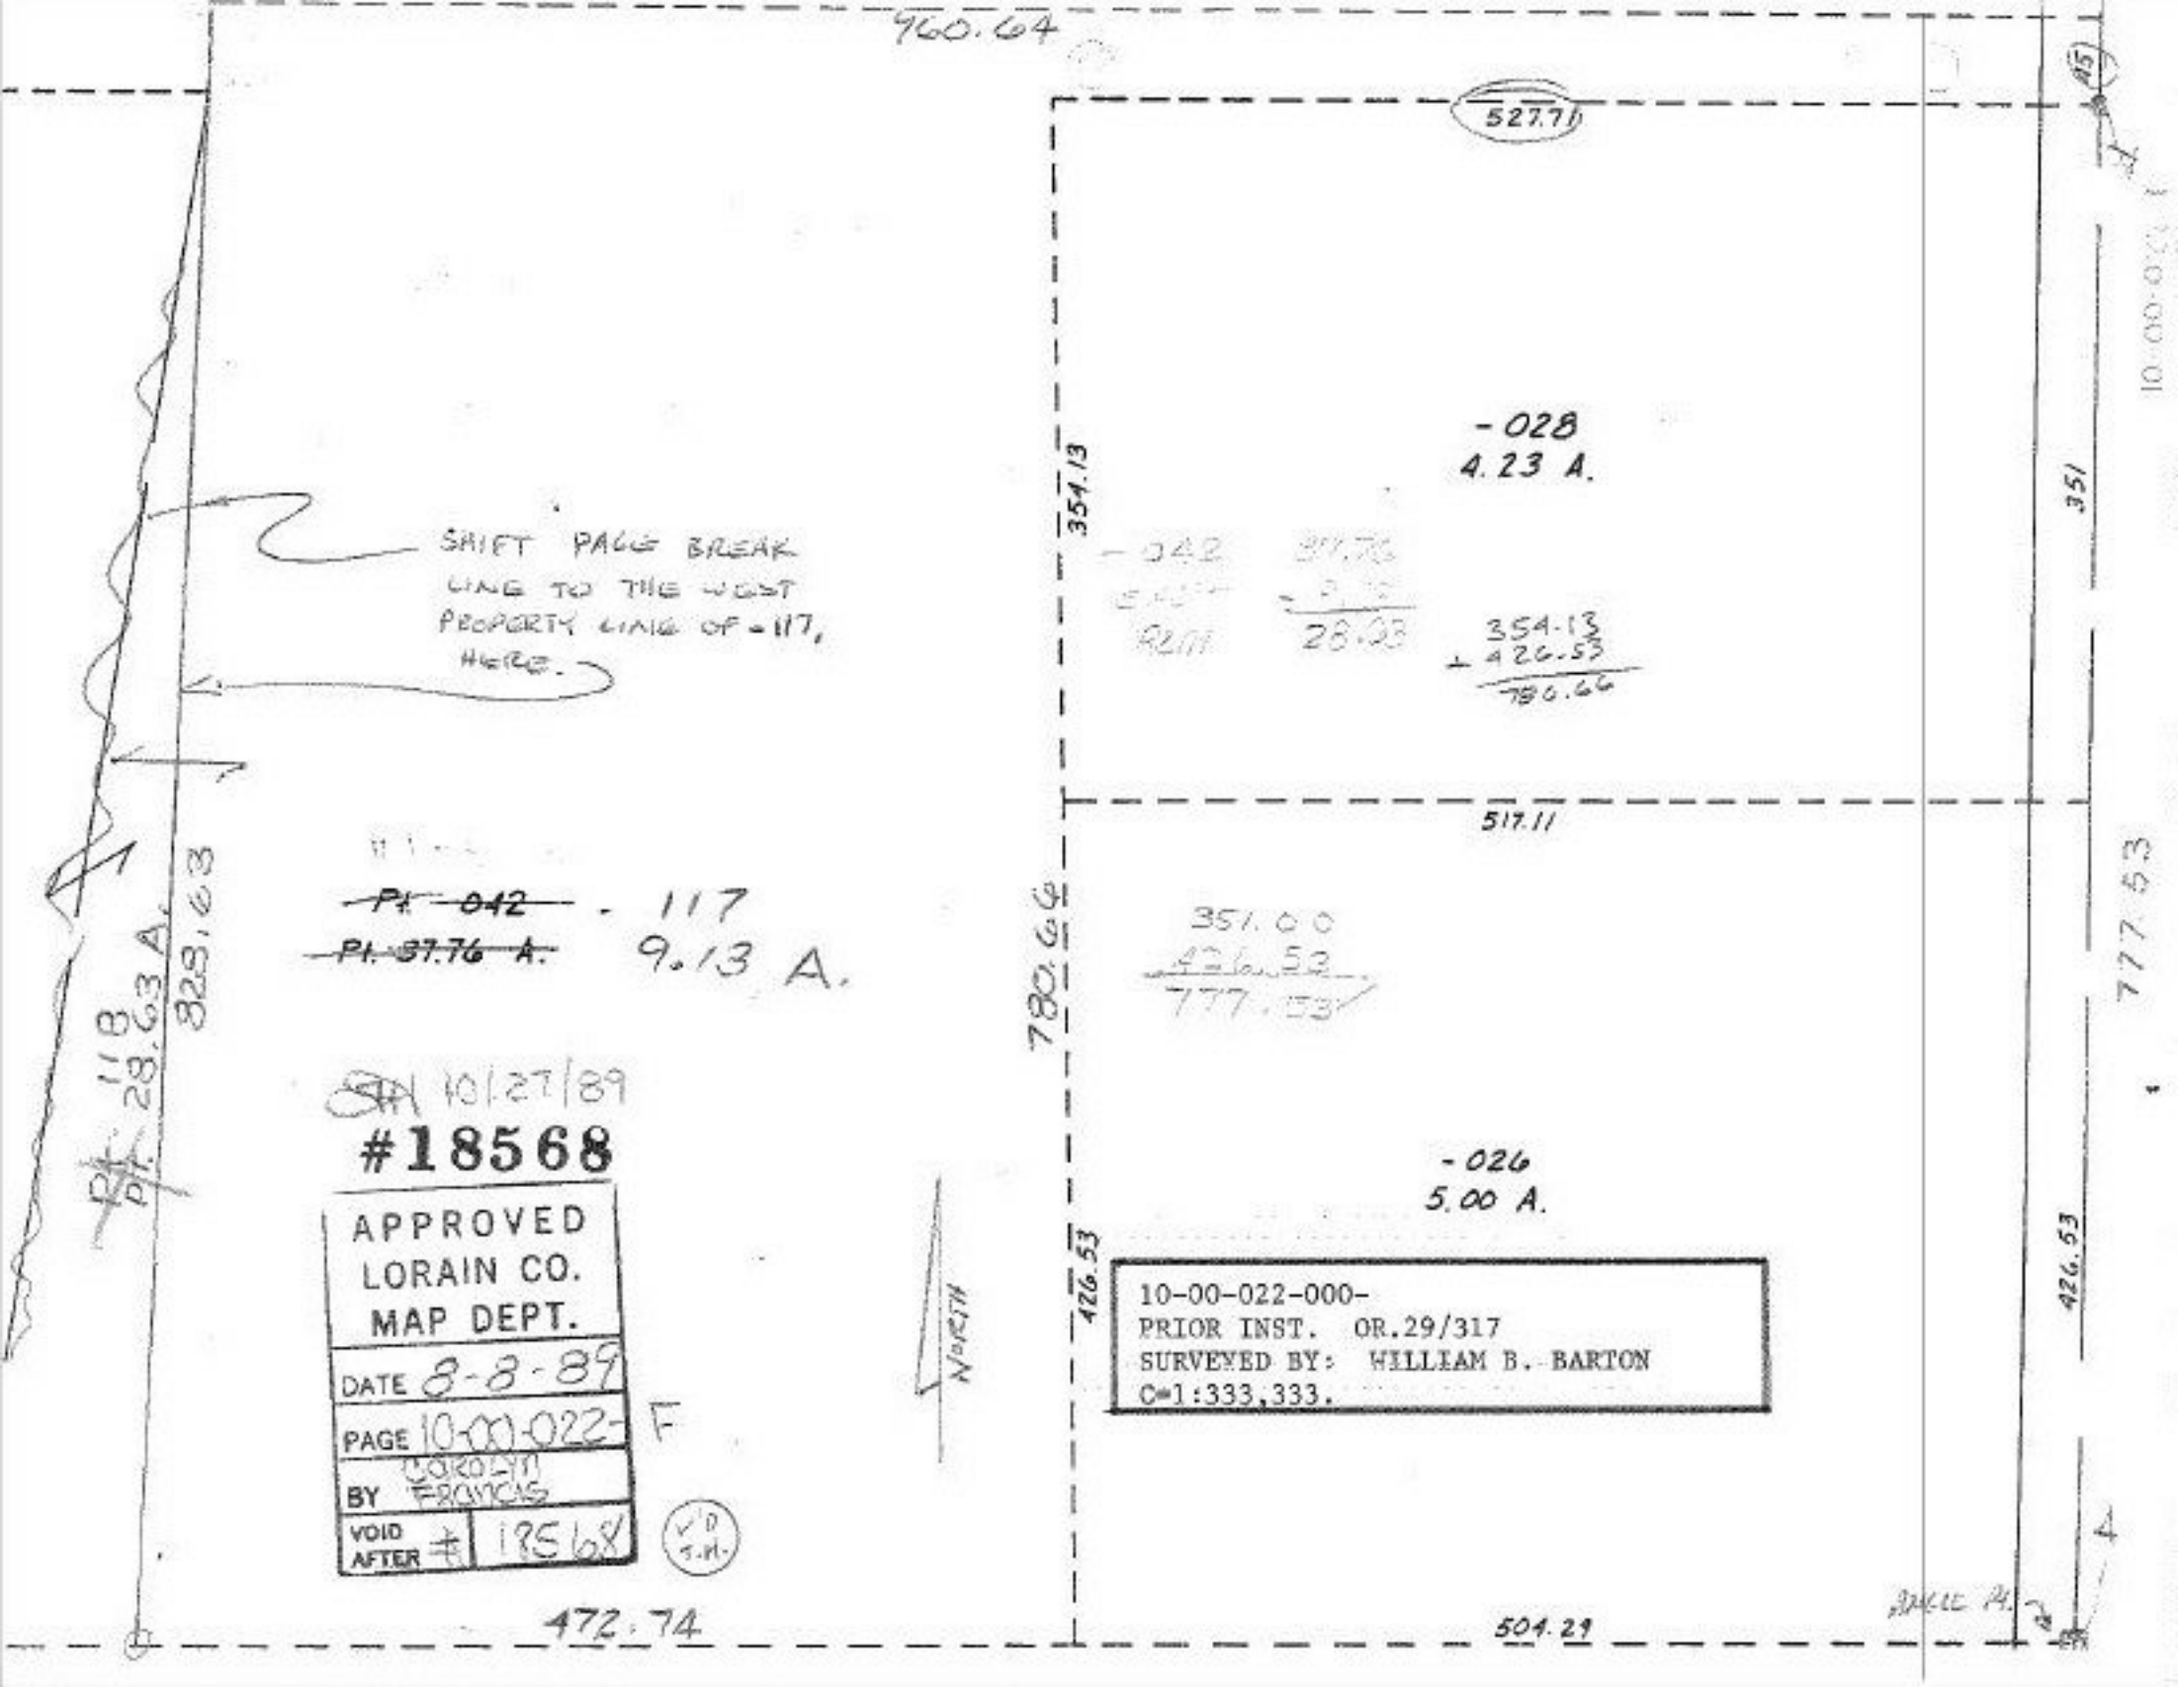

960.64
527.71
45
10-00-022
-028
4.23 A.
354.13
351
SHIFT PAGE BREAK LINE TO THE WEST PROPERTY LINE OF -117, HERE.
-042
28.03
354.13
+ 426.53
780.66
517.11
~~Pt. 042~~ - 117
~~Pt. 37.76 A.~~ 9.13 A.
351.00
426.53
777.53
780.66
777.53
828.63
Pt. 118
Pt. 28.63 A.
10/27/89
#18568
APPROVED
LORAIN CO.
MAP DEPT.
DATE 8-8-89
PAGE 10-00-022- F
BY CAROLYN FRANCIS
VOID AFTER # 18568
NORTH
-026
5.00 A.
426.53
426.53
10-00-022-000-
PRIOR INST. OR.29/317
SURVEYED BY: WILLIAM B. BARTON
C=1:333,333.
472.74
504.29