


DRIVE 1857

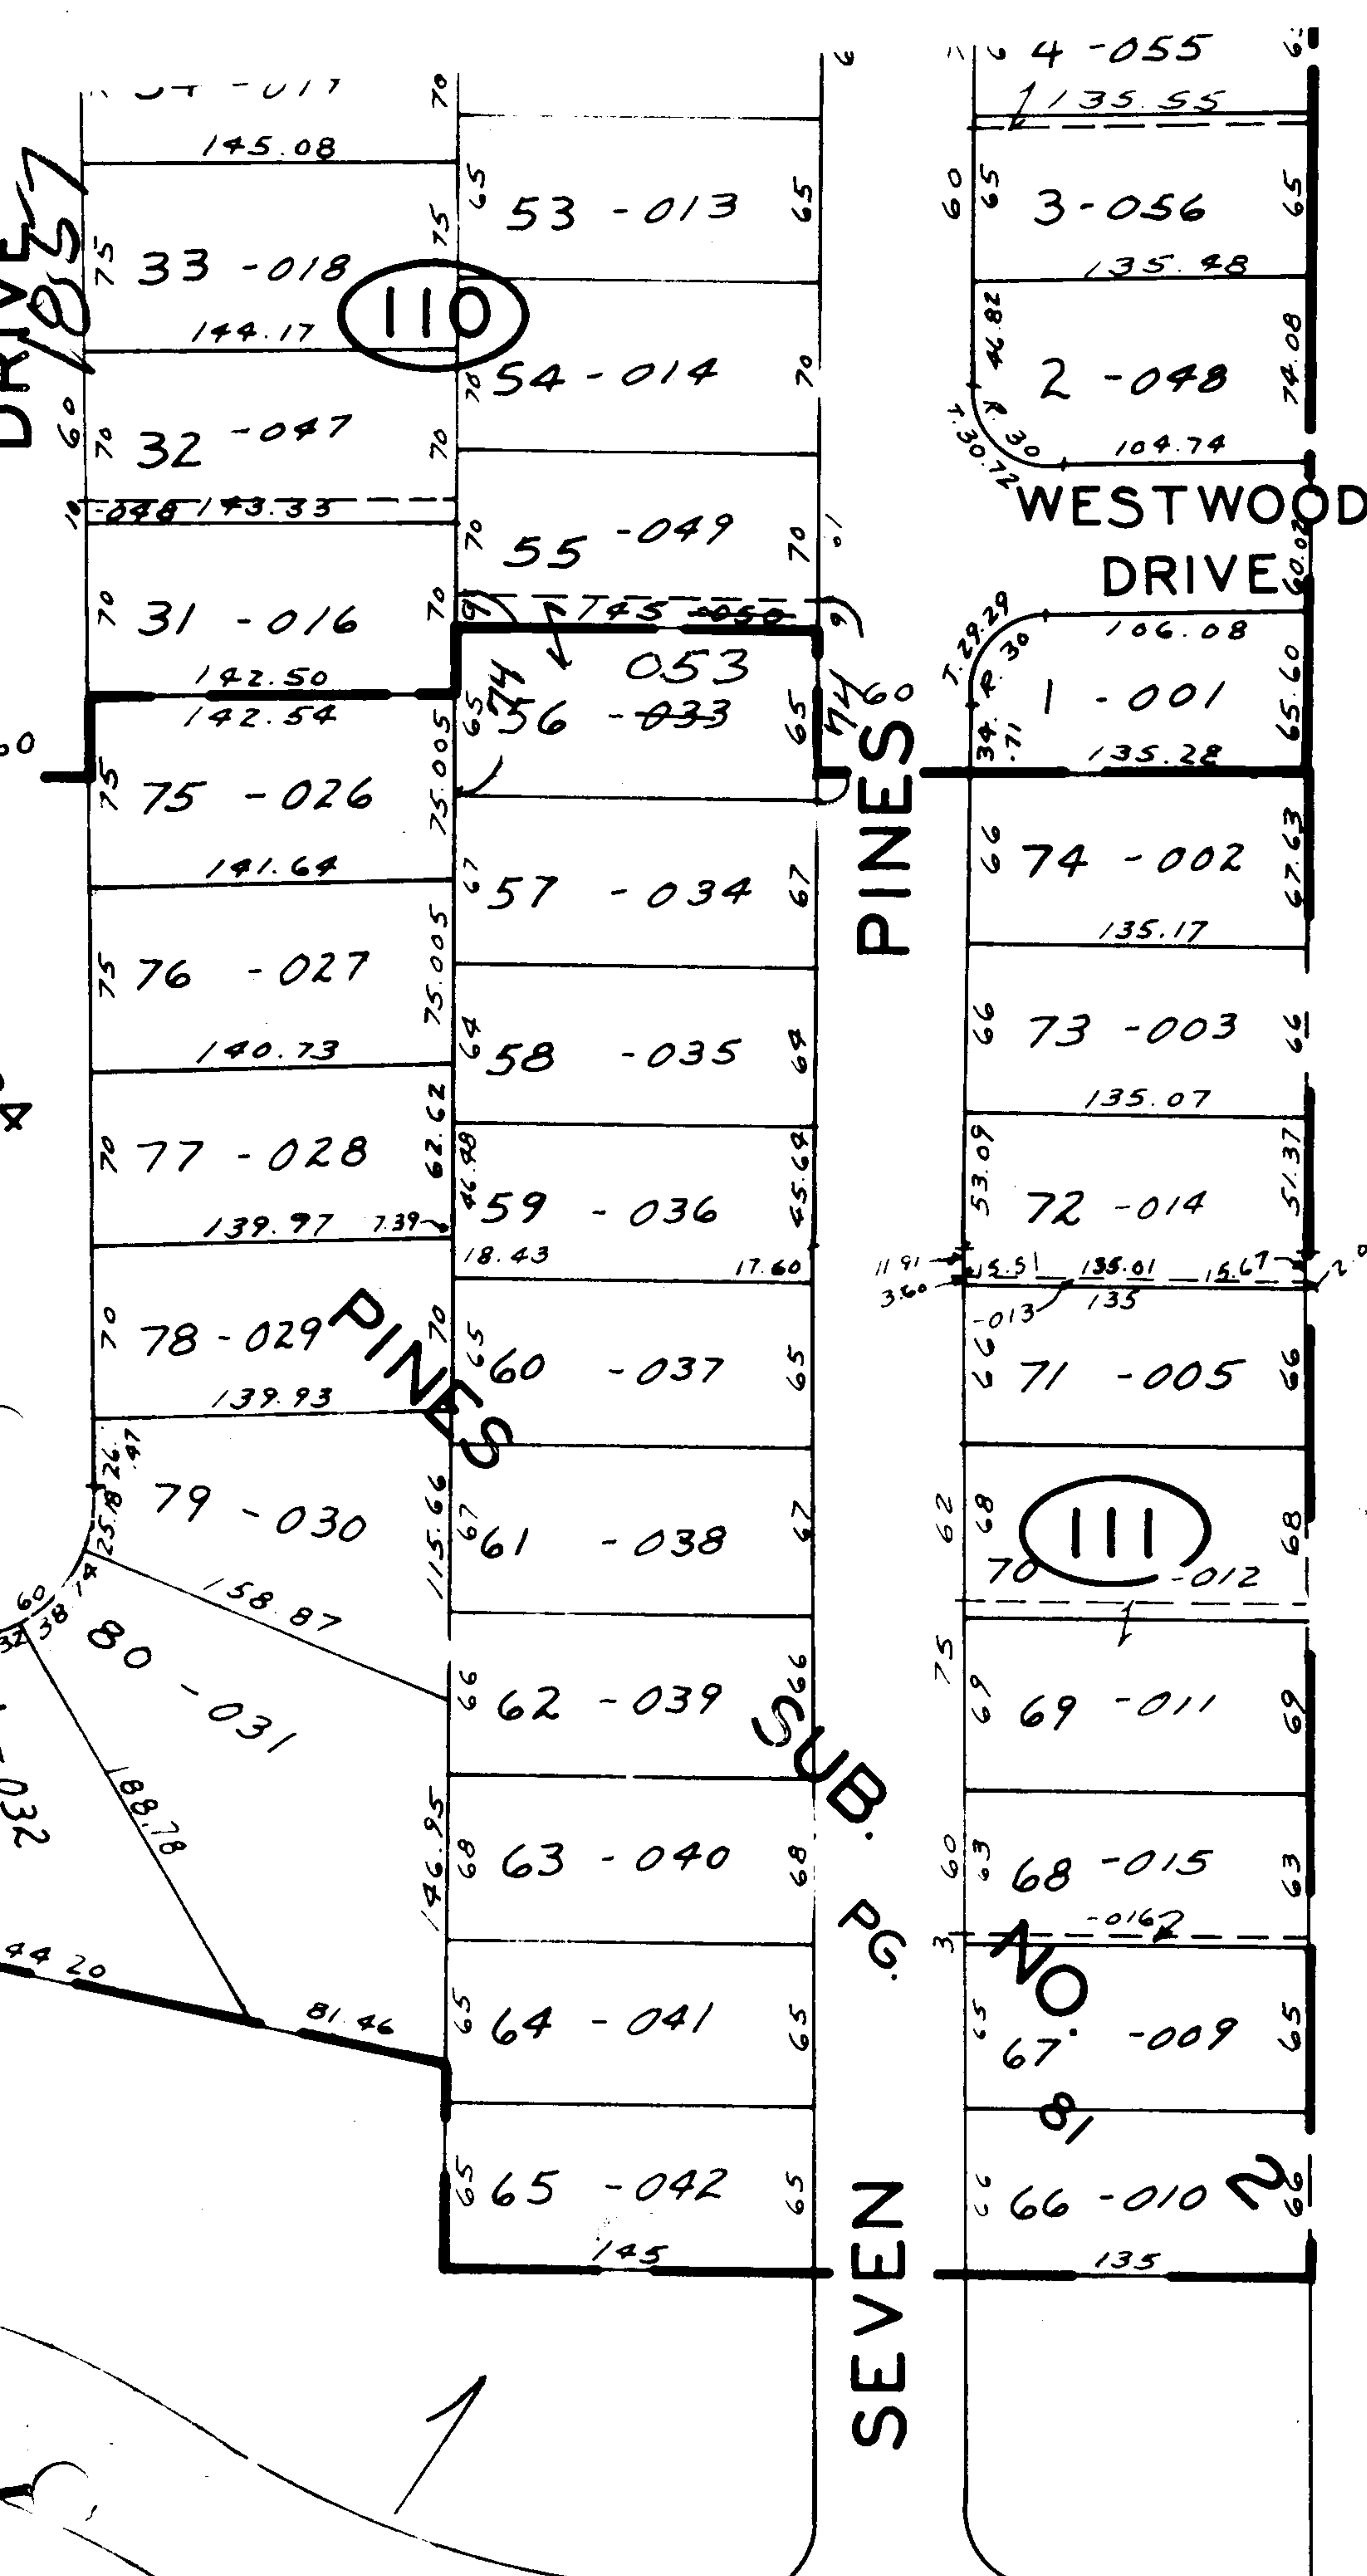

1857

[Signature]

#1857
APPROVED
 LORAIN CO.
 MAP DEPT.
 DATE 6-12-68
 02-02-004B
 BY Lw Ha 4

2-02-005-A

2-02-004B

BLVD.