



1857

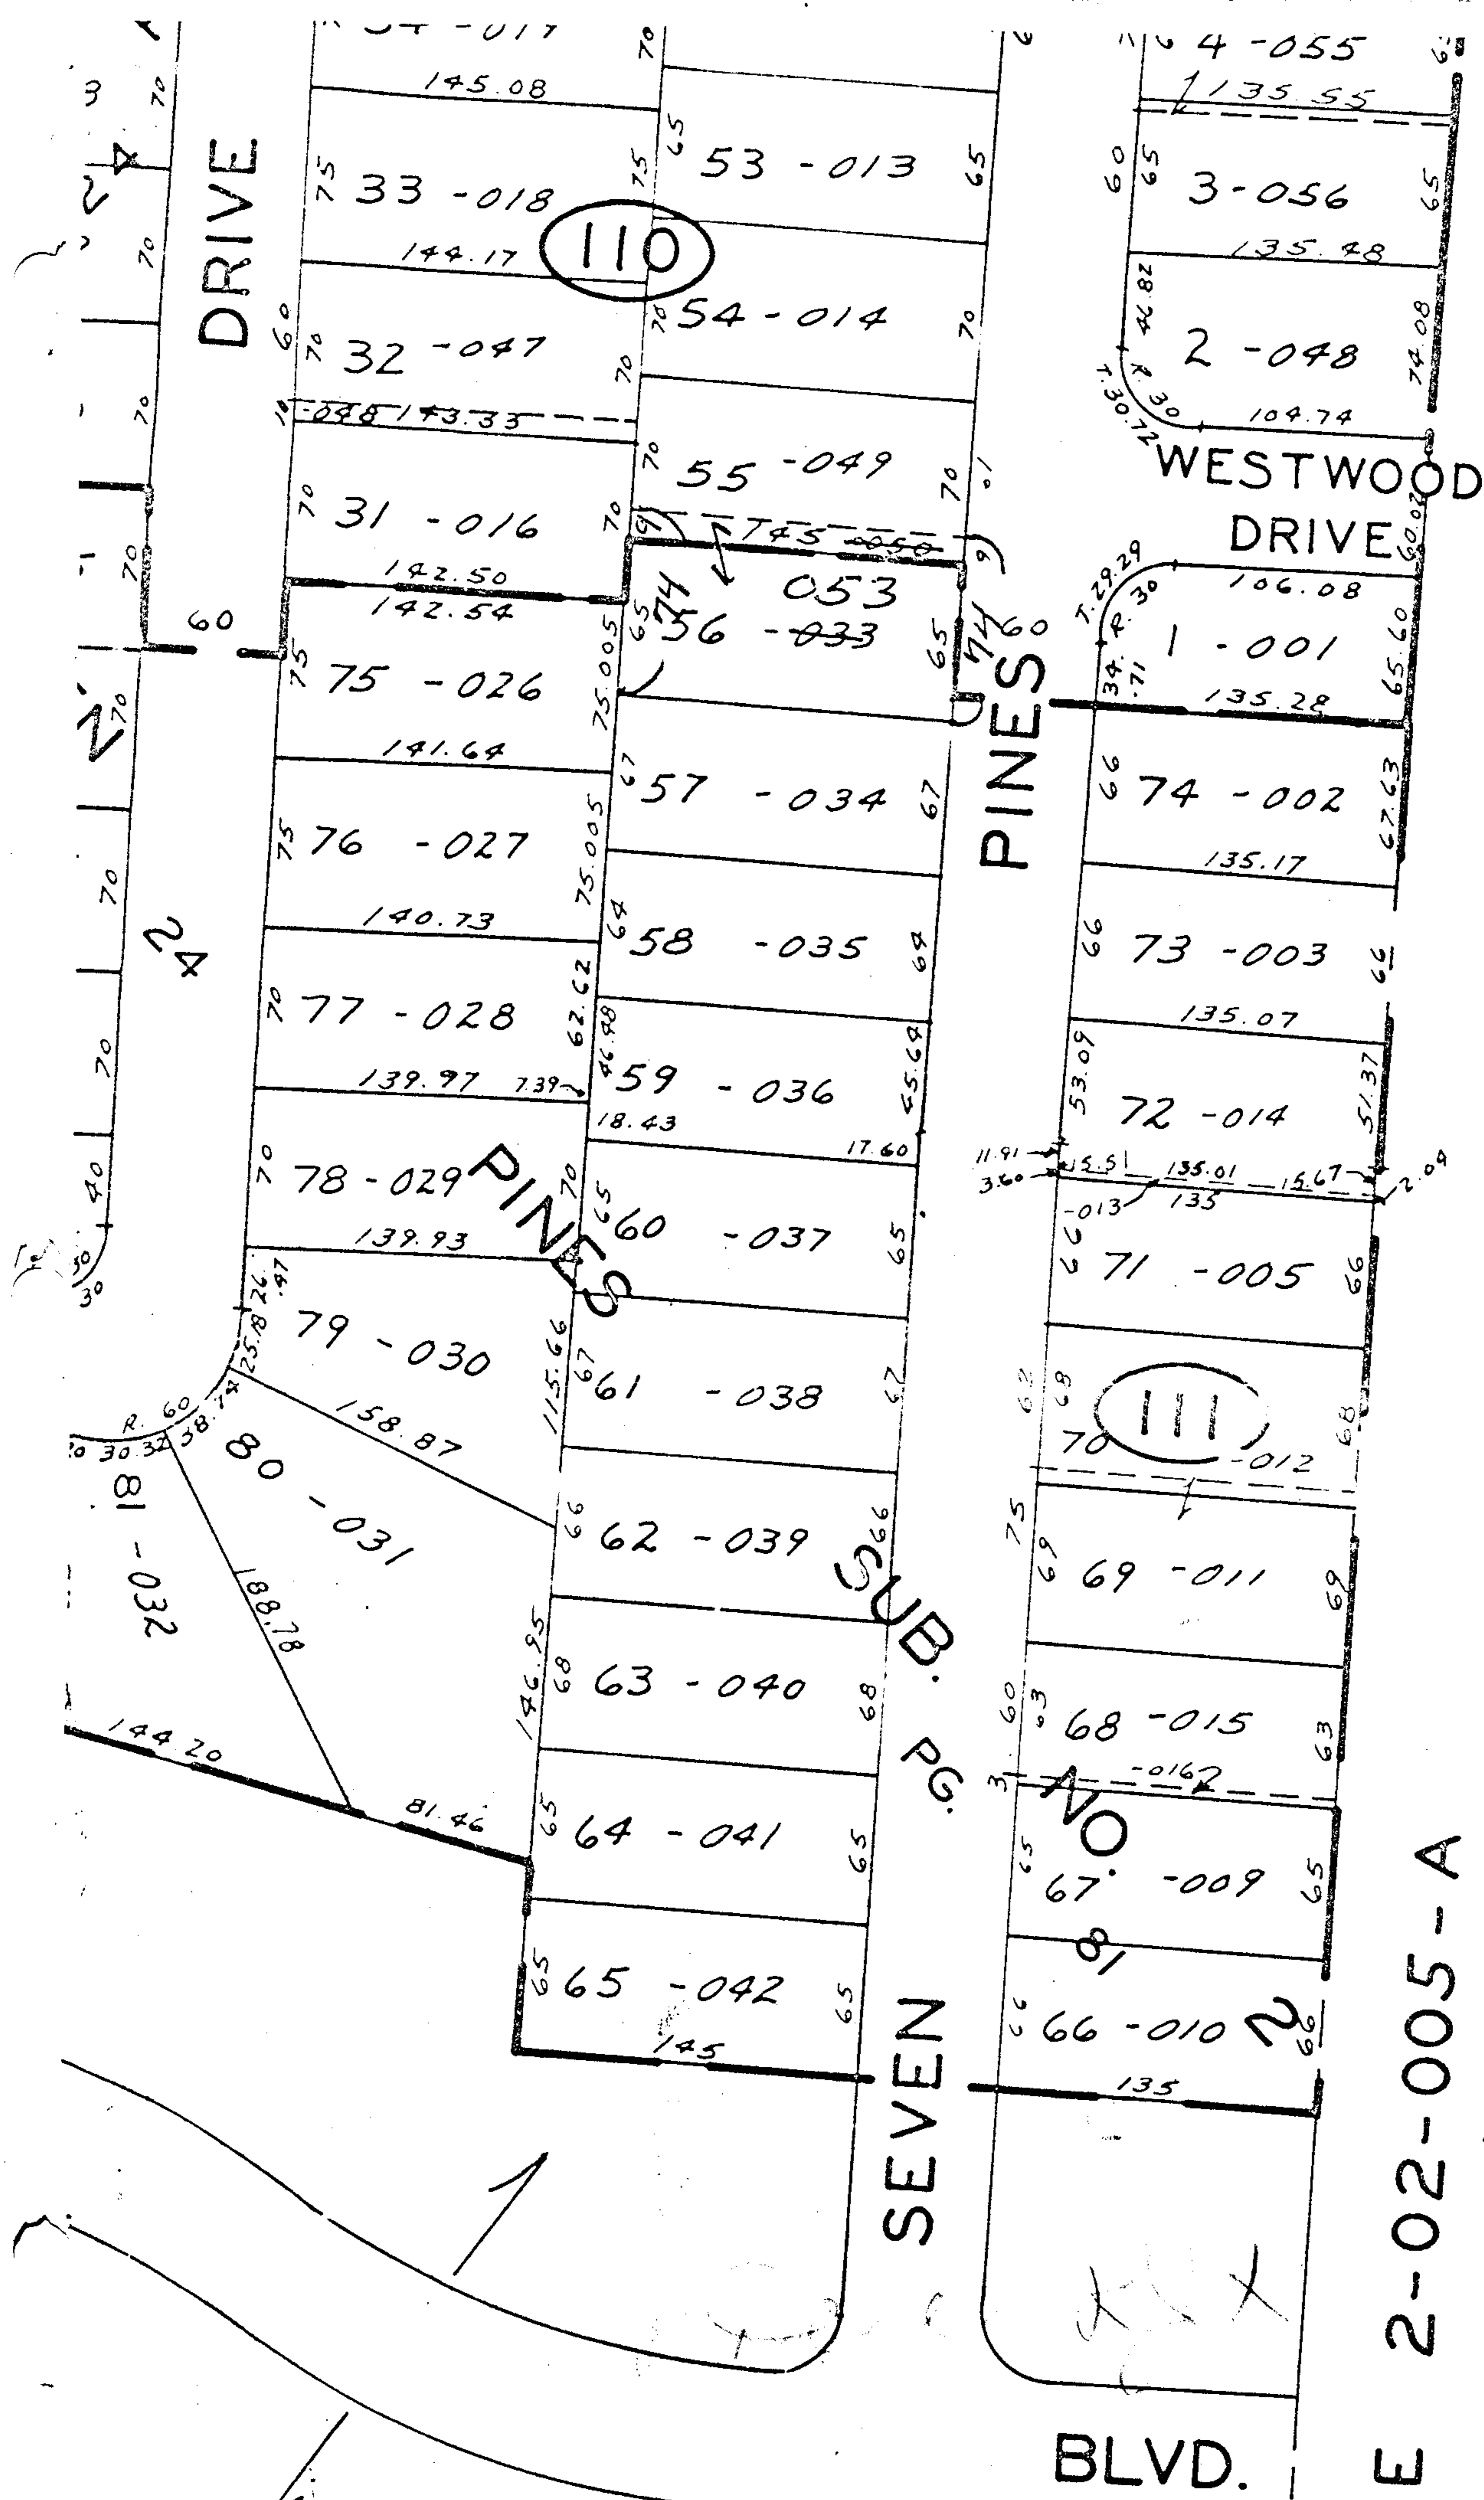

2-02-005-A

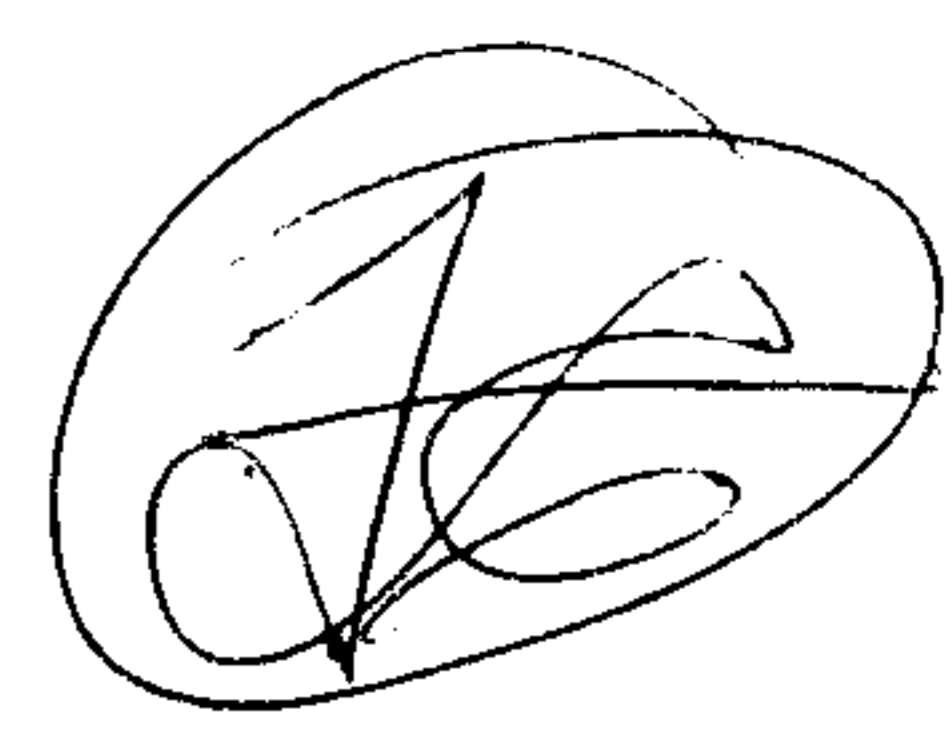

1857
 APPROVED
 LORAIN CO.
 MAP DEPT.
 DATE 6-12-68
 02-02-004B
 BY L.H. Ha 4

7-14-86

R.K.

2-02-004B

BLVD.