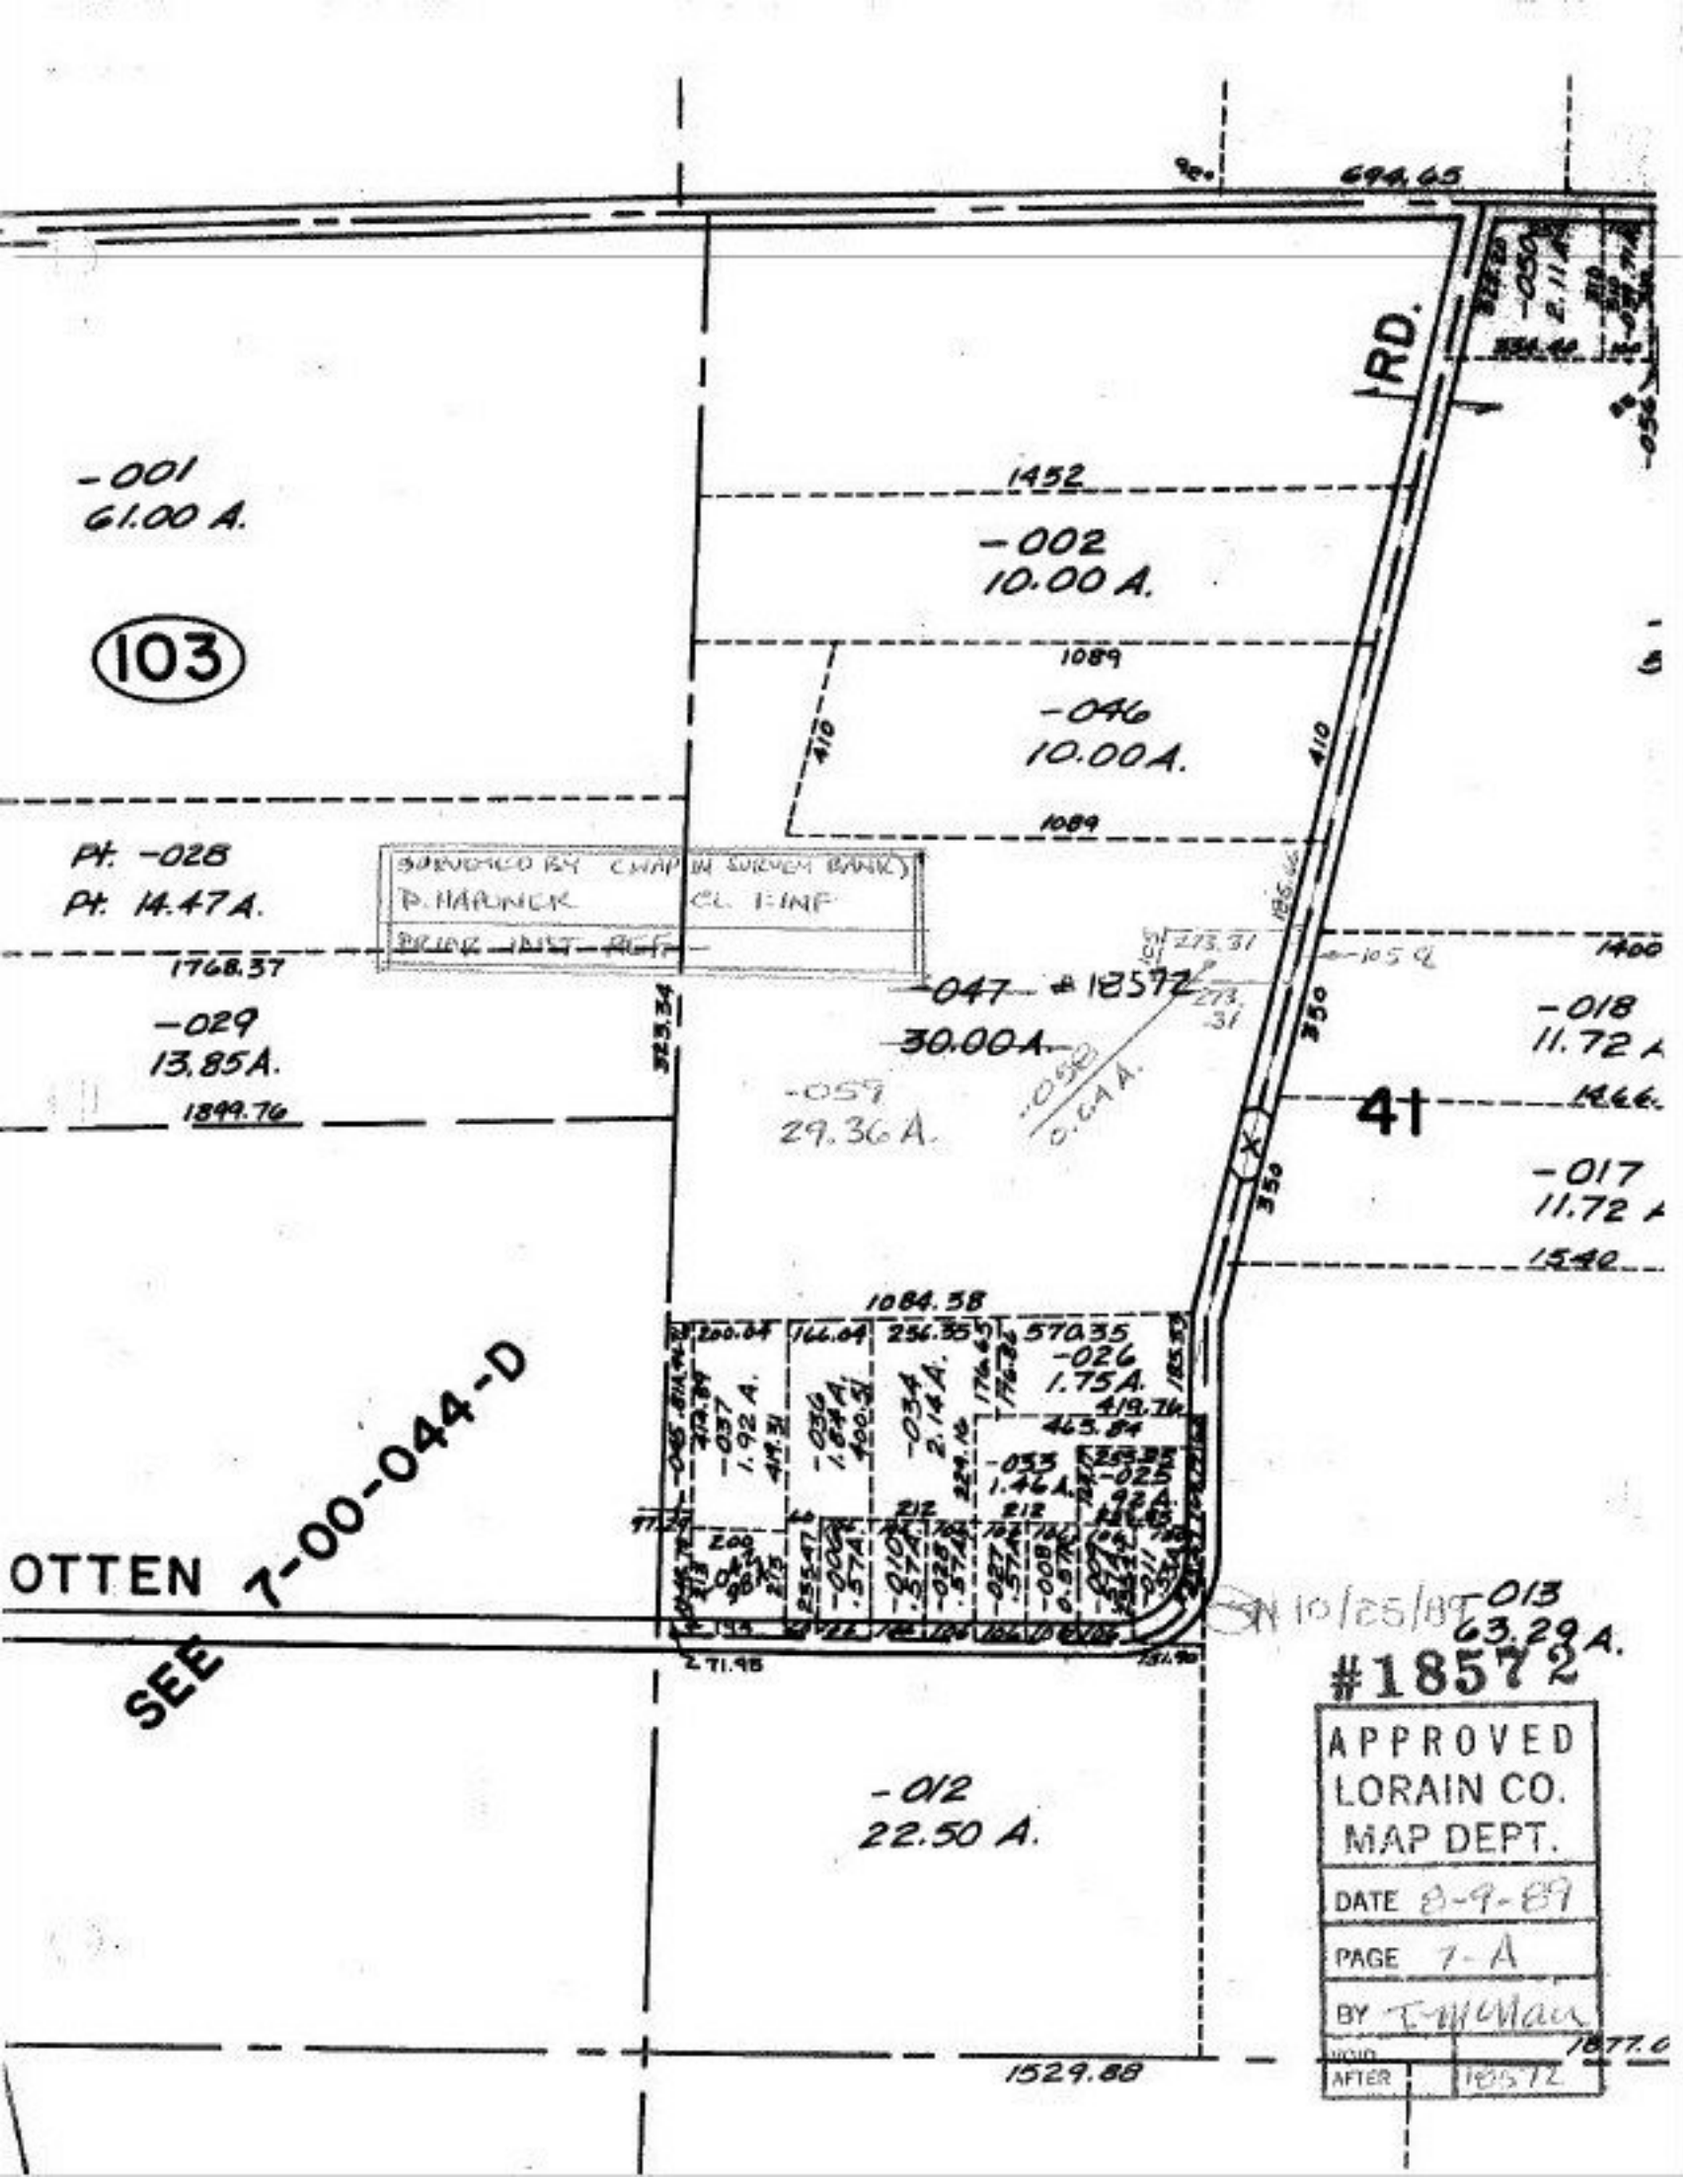
694.65
RD.
-001
61.00 A.
103
1452
-002
10.00 A.
1089
-046
10.00 A.
410
410
1089
Pt. -028
Pt. 14.47 A.
SURVEYED BY CHAPIN SURVEY BANK
P. HARDNER
CL. FENCE
1768.37
-029
13.85 A.
1899.76
323.34
-047 #18572
30.00 A.
273.31
273.31
-059
29.36 A.
.058
0.64 A.
350
350
-018
11.72 A
41
-017
11.72 A
1540
1084.58
200.04
144.04
256.35
570.35
-026
1.75 A.
419.74
463.84
-037
1.92 A.
-036
1.64 A.
-034
2.14 A.
-033
1.46 A.
-025
.92 A.
SEE 7-00-044-D
OTTEN
271.98
-012
22.50 A.
1529.88
10/25/87
013
63.29 A.
#18572
APPROVED
LORAIN CO.
MAP DEPT.
DATE 8-9-89
PAGE 7-A
BY T. McMan
VOID AFTER 18572