#15383

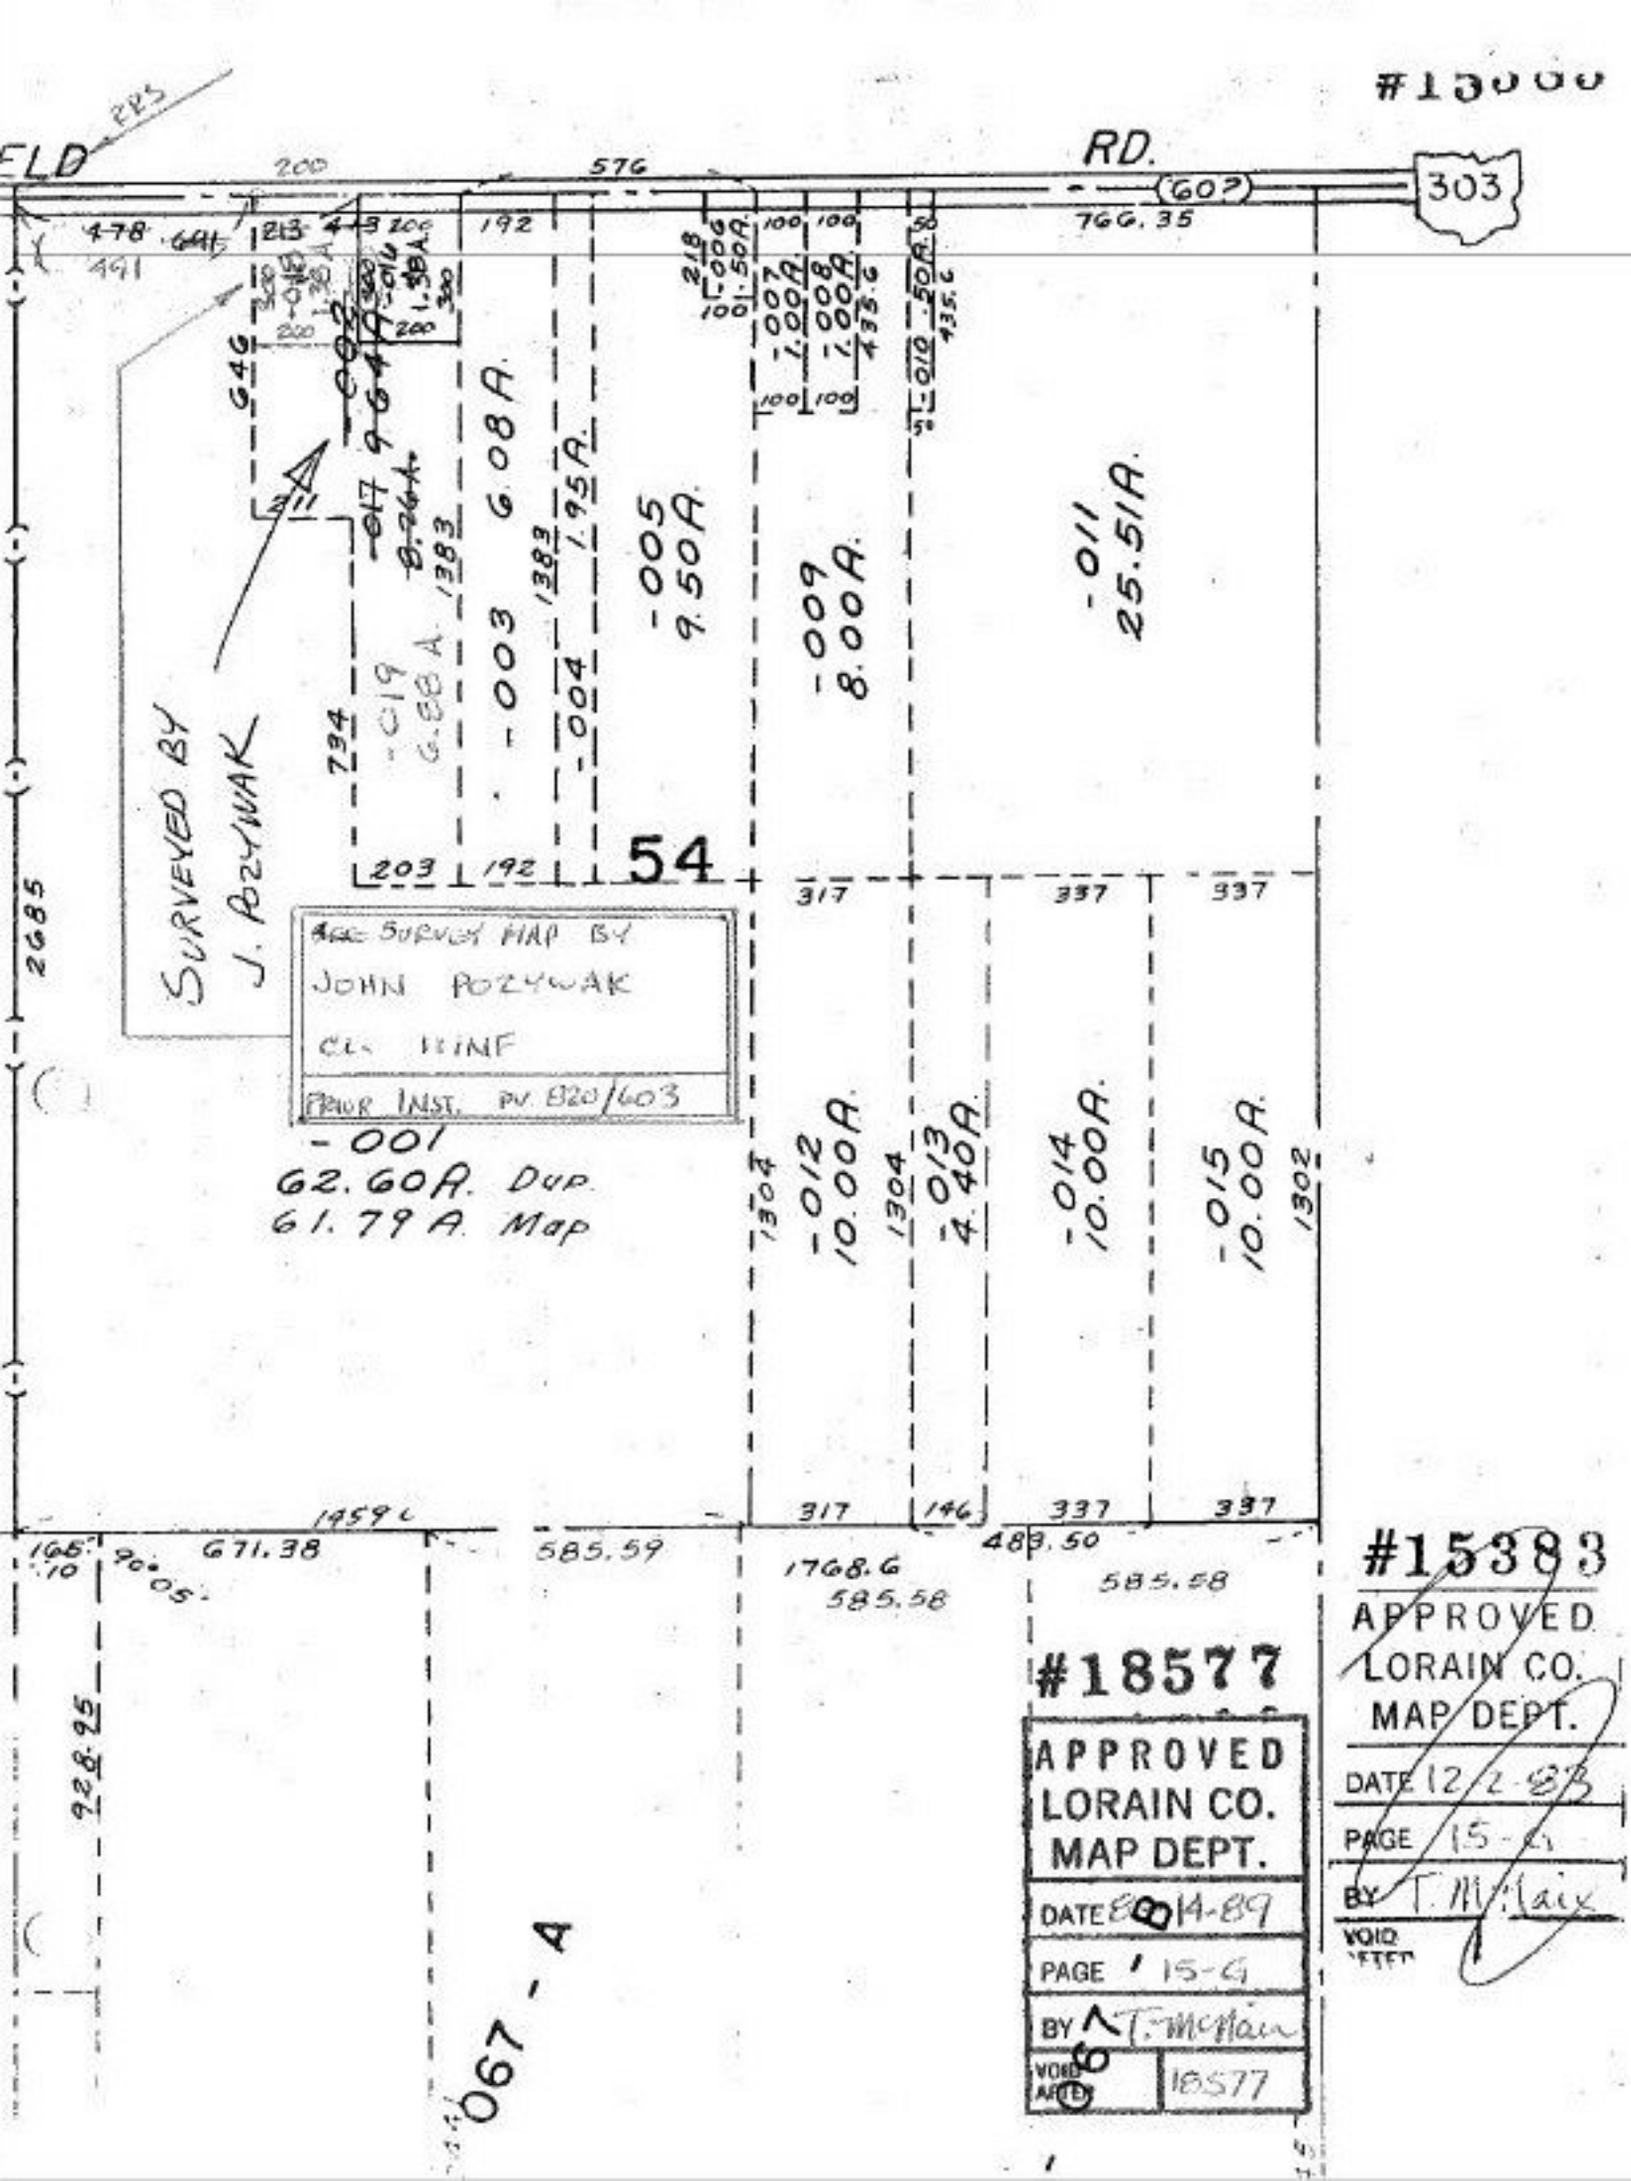

#15383
APPROVED
LORAIN CO.
MAP DEPT.
DATE 12/2-88
PAGE 15-G
BY T. McClain
VOID

#18577
APPROVED
LORAIN CO.
MAP DEPT.
DATE 8/14-89
PAGE 15-G
BY T. McClain
VOID AFTER 18577