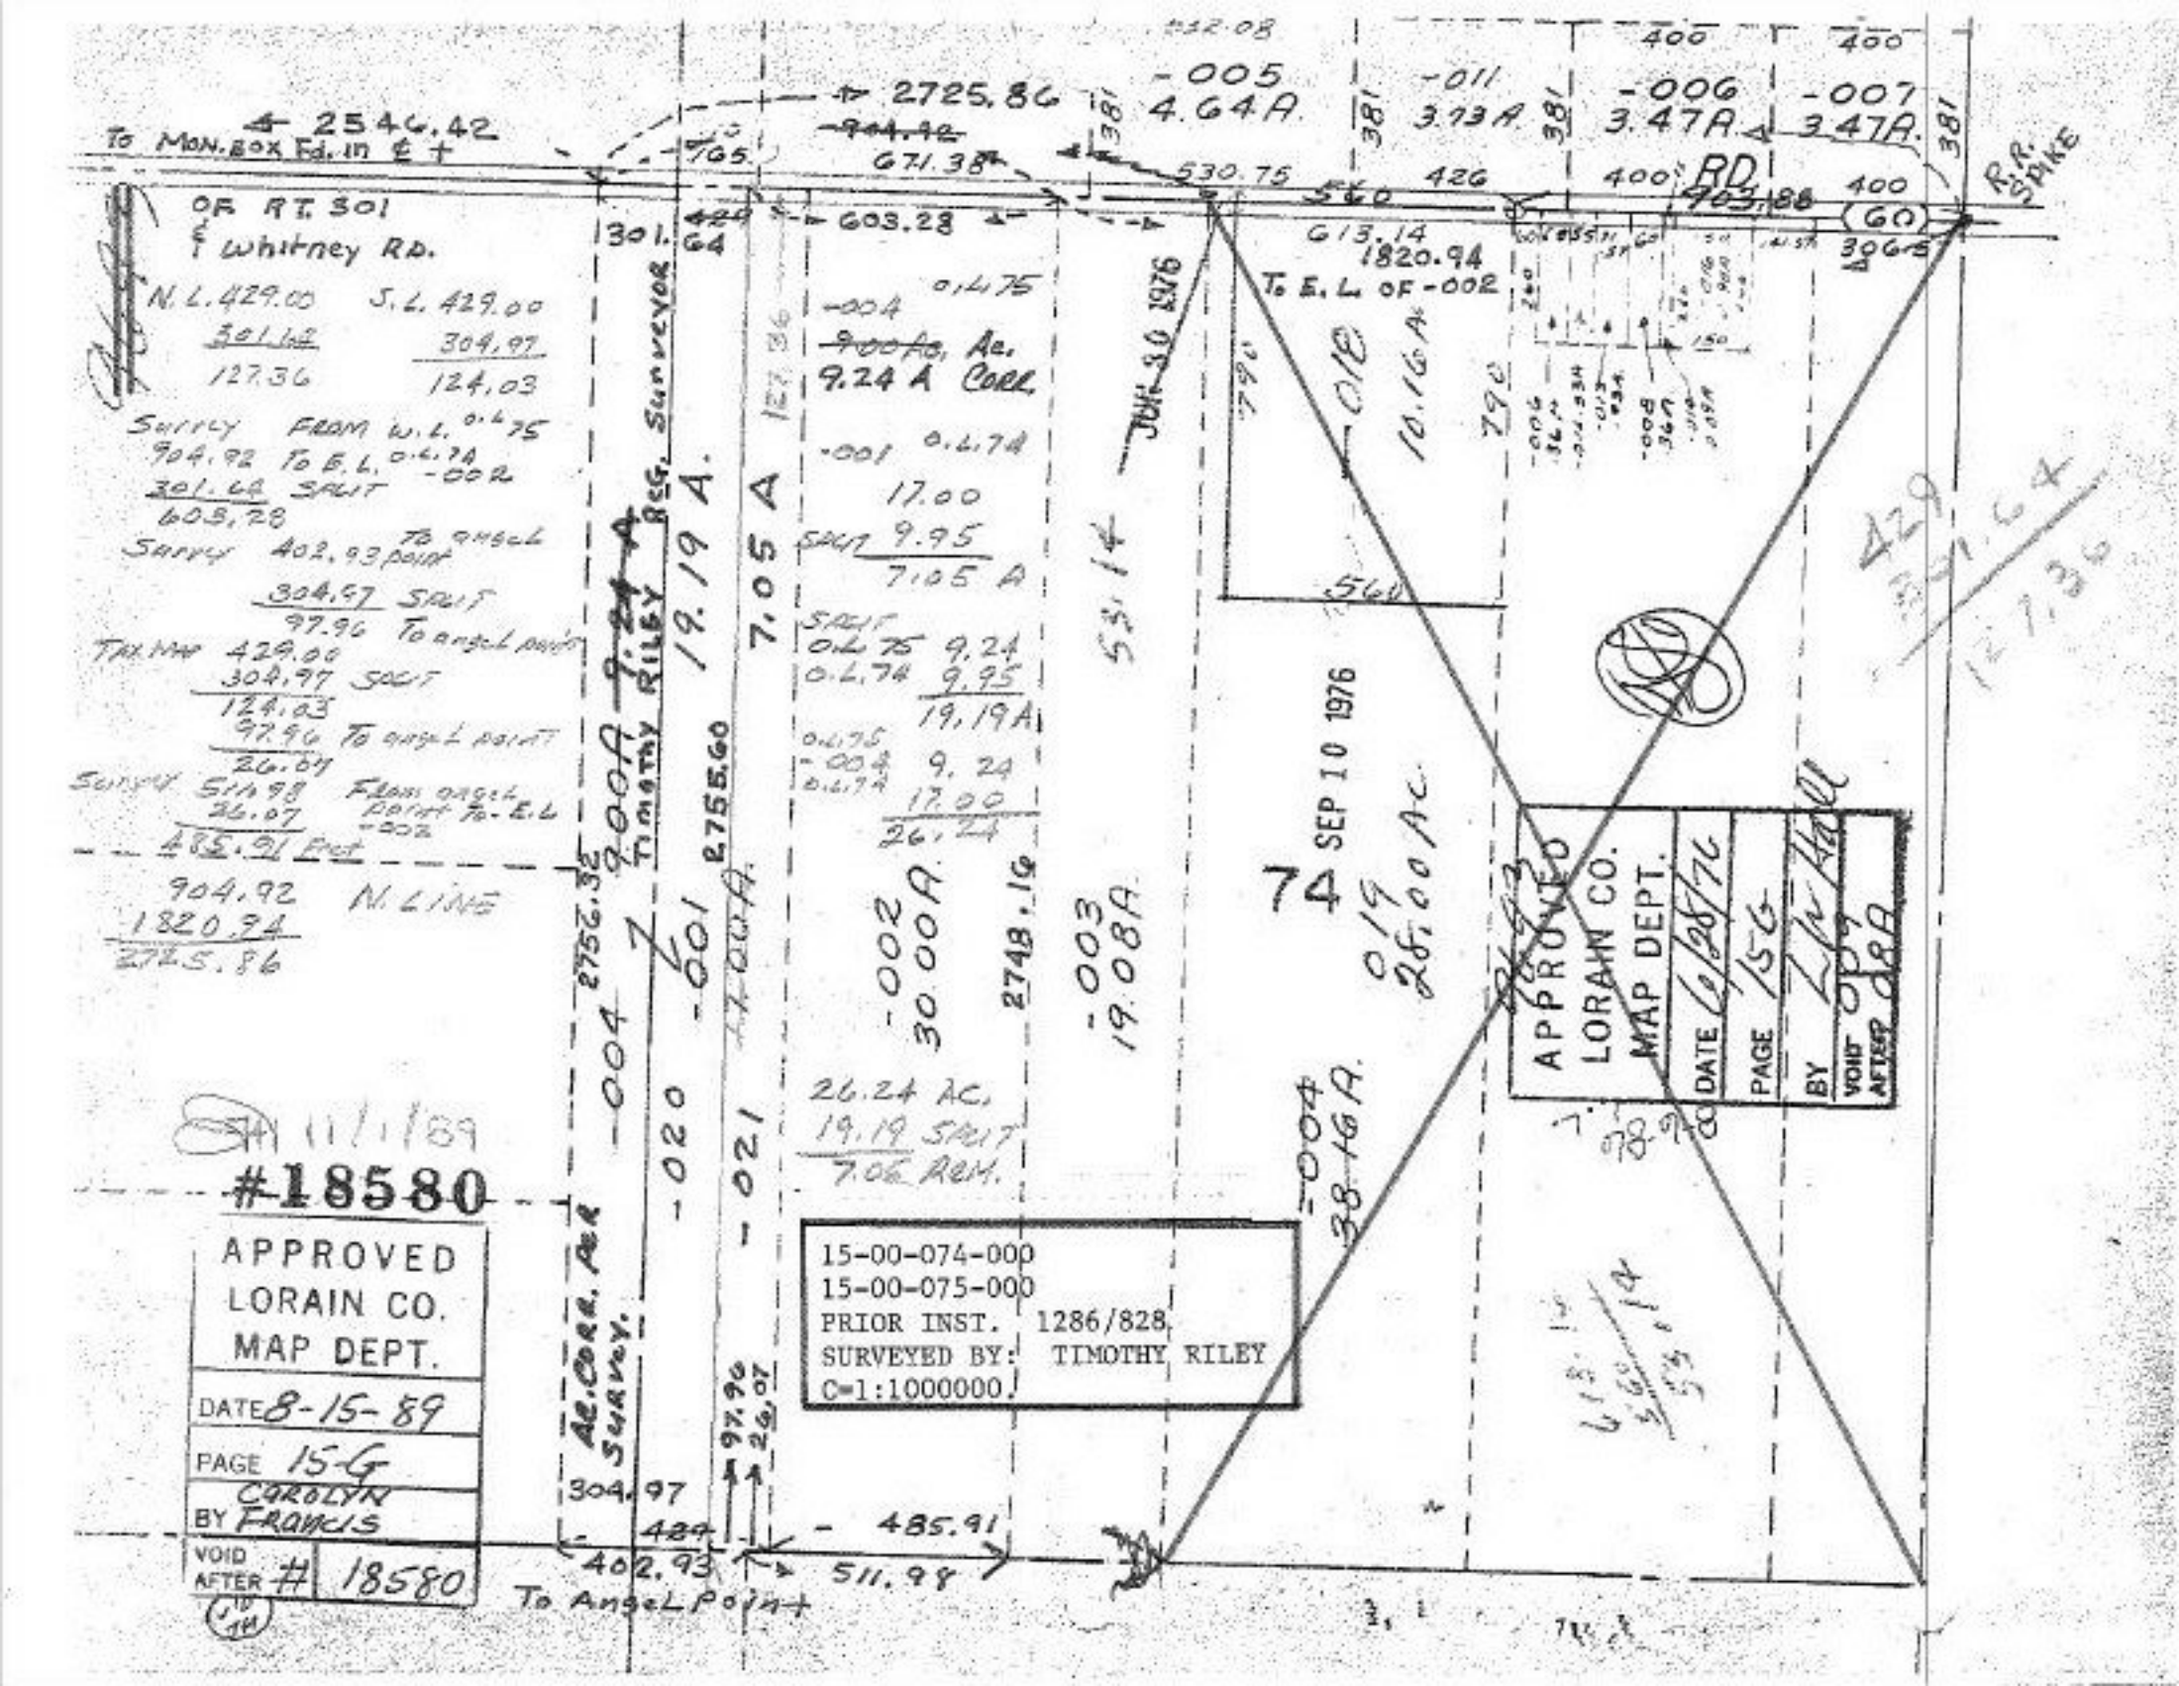

To Mon. Box Fd. in ℄ +
2546.42
2725.86
-005
4.64A.
-011
3.73A.
-006
3.47A.
-007
3.47A.
RD
903.88
R.R. SPIKE
OF RT. 301
& Whitney RD.
N.L. 429.00
301.64
127.36
S.L. 429.00
304.97
124.03
Survey From W.L. 0.L.75
904.92 To E.L. 0.L.74 -002
301.64 Split
603.28
Survey 402.93 To angel point
304.97 Split
97.96 To angel point
Tax Map 429.00
304.97 Split
124.03
97.96 To angel point
26.07
Survey 511.98 From angel point to E.L. -002
26.07
485.91 Feet
904.92 N. Line
1820.94
2725.86
301.64
603.28
671.38
530.75
613.14
1820.94
To E.L. of -002
-004
9.24 A Corr.
17.00
9.95
7.05 A
9.24
9.95
19.19A
9.24
17.00
26.24
Timothy Riley Reg. Surveyor
19.19 A.
7.05 A
2755.60
2756.32
2748.16
-002
30.00A.
-003
19.08A.
-004
38.16A.
-018
10.16A.
-019
28.00 Ac.
74
SEP 10 1976
JUN 30 1976
26.24 Ac.
19.19 Split
7.05 Rem.
Ac. Corr. Per Survey.
304.97
402.93
485.91
511.98
To Angel Point
APPROVED
LORAIN CO.
MAP DEPT.
DATE 6/28/76
PAGE 15G
BY
VOID AFTER
#18580
APPROVED
LORAIN CO.
MAP DEPT.
DATE 8-15-89
PAGE 15-G
BY Carolyn Francis
VOID AFTER # 18580
15-00-074-000
15-00-075-000
PRIOR INST. 1286/828
SURVEYED BY: TIMOTHY RILEY
C=1:1000000.