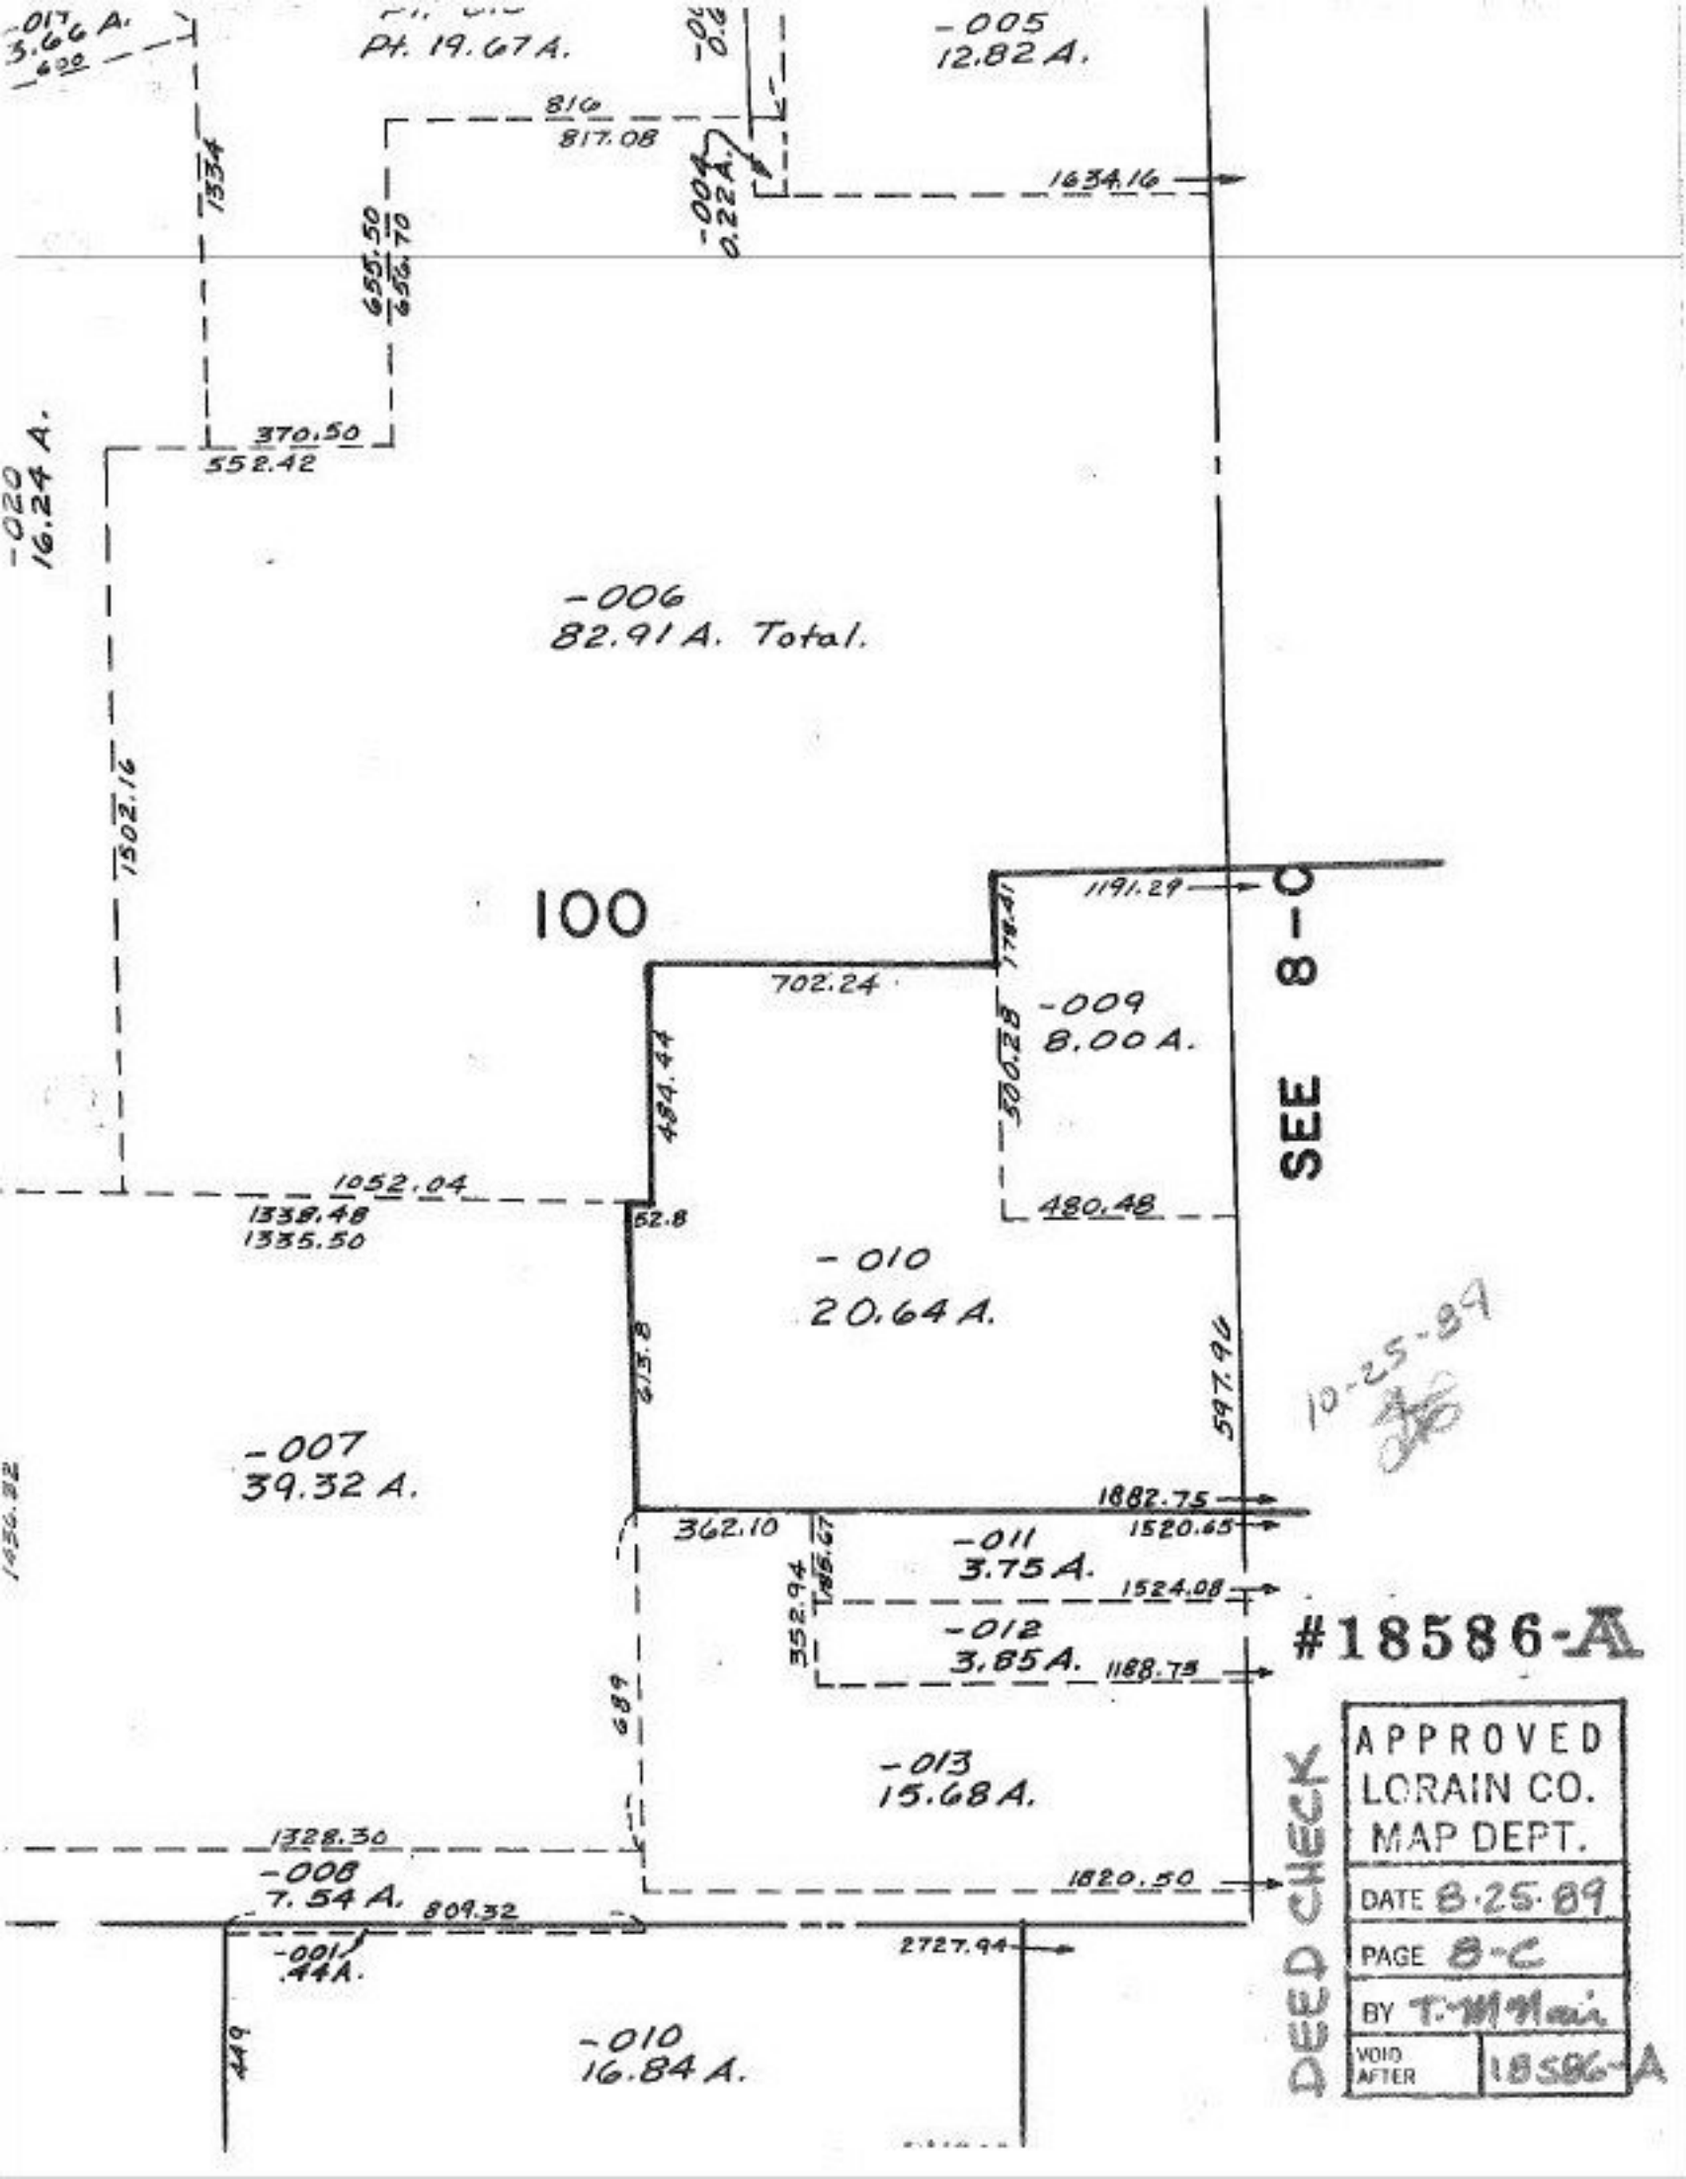
-017
3.66 A.
602
Pt. 19.67 A.
-005
12.82 A.
810
817.08
1334
655.50
656.70
-004
0.22 A.
1634.16
370.50
552.42
-020
16.24 A.
1502.16
-006
82.91 A. Total.
100
1191.29
178.41
702.24
-009
8.00 A.
484.44
300.28
SEE 8-C
1052.04
1338.48
1335.50
480.48
52.8
-010
20.64 A.
213.8
597.96
10-25-89
-007
39.32 A.
1882.75
1520.65
362.10
185.67
-011
3.75 A.
352.94
1524.08
-012
3.65 A.
1188.78
#18586-A
689
-013
15.68 A.
1328.30
-008
7.54 A.
809.32
1820.50
-001
.44 A.
2727.94
449
-010
16.84 A.
APPROVED
LORAIN CO.
MAP DEPT.
DATE 8-25-89
PAGE 8-C
BY T. Williams
VOID AFTER
18586-A
DED CHECK