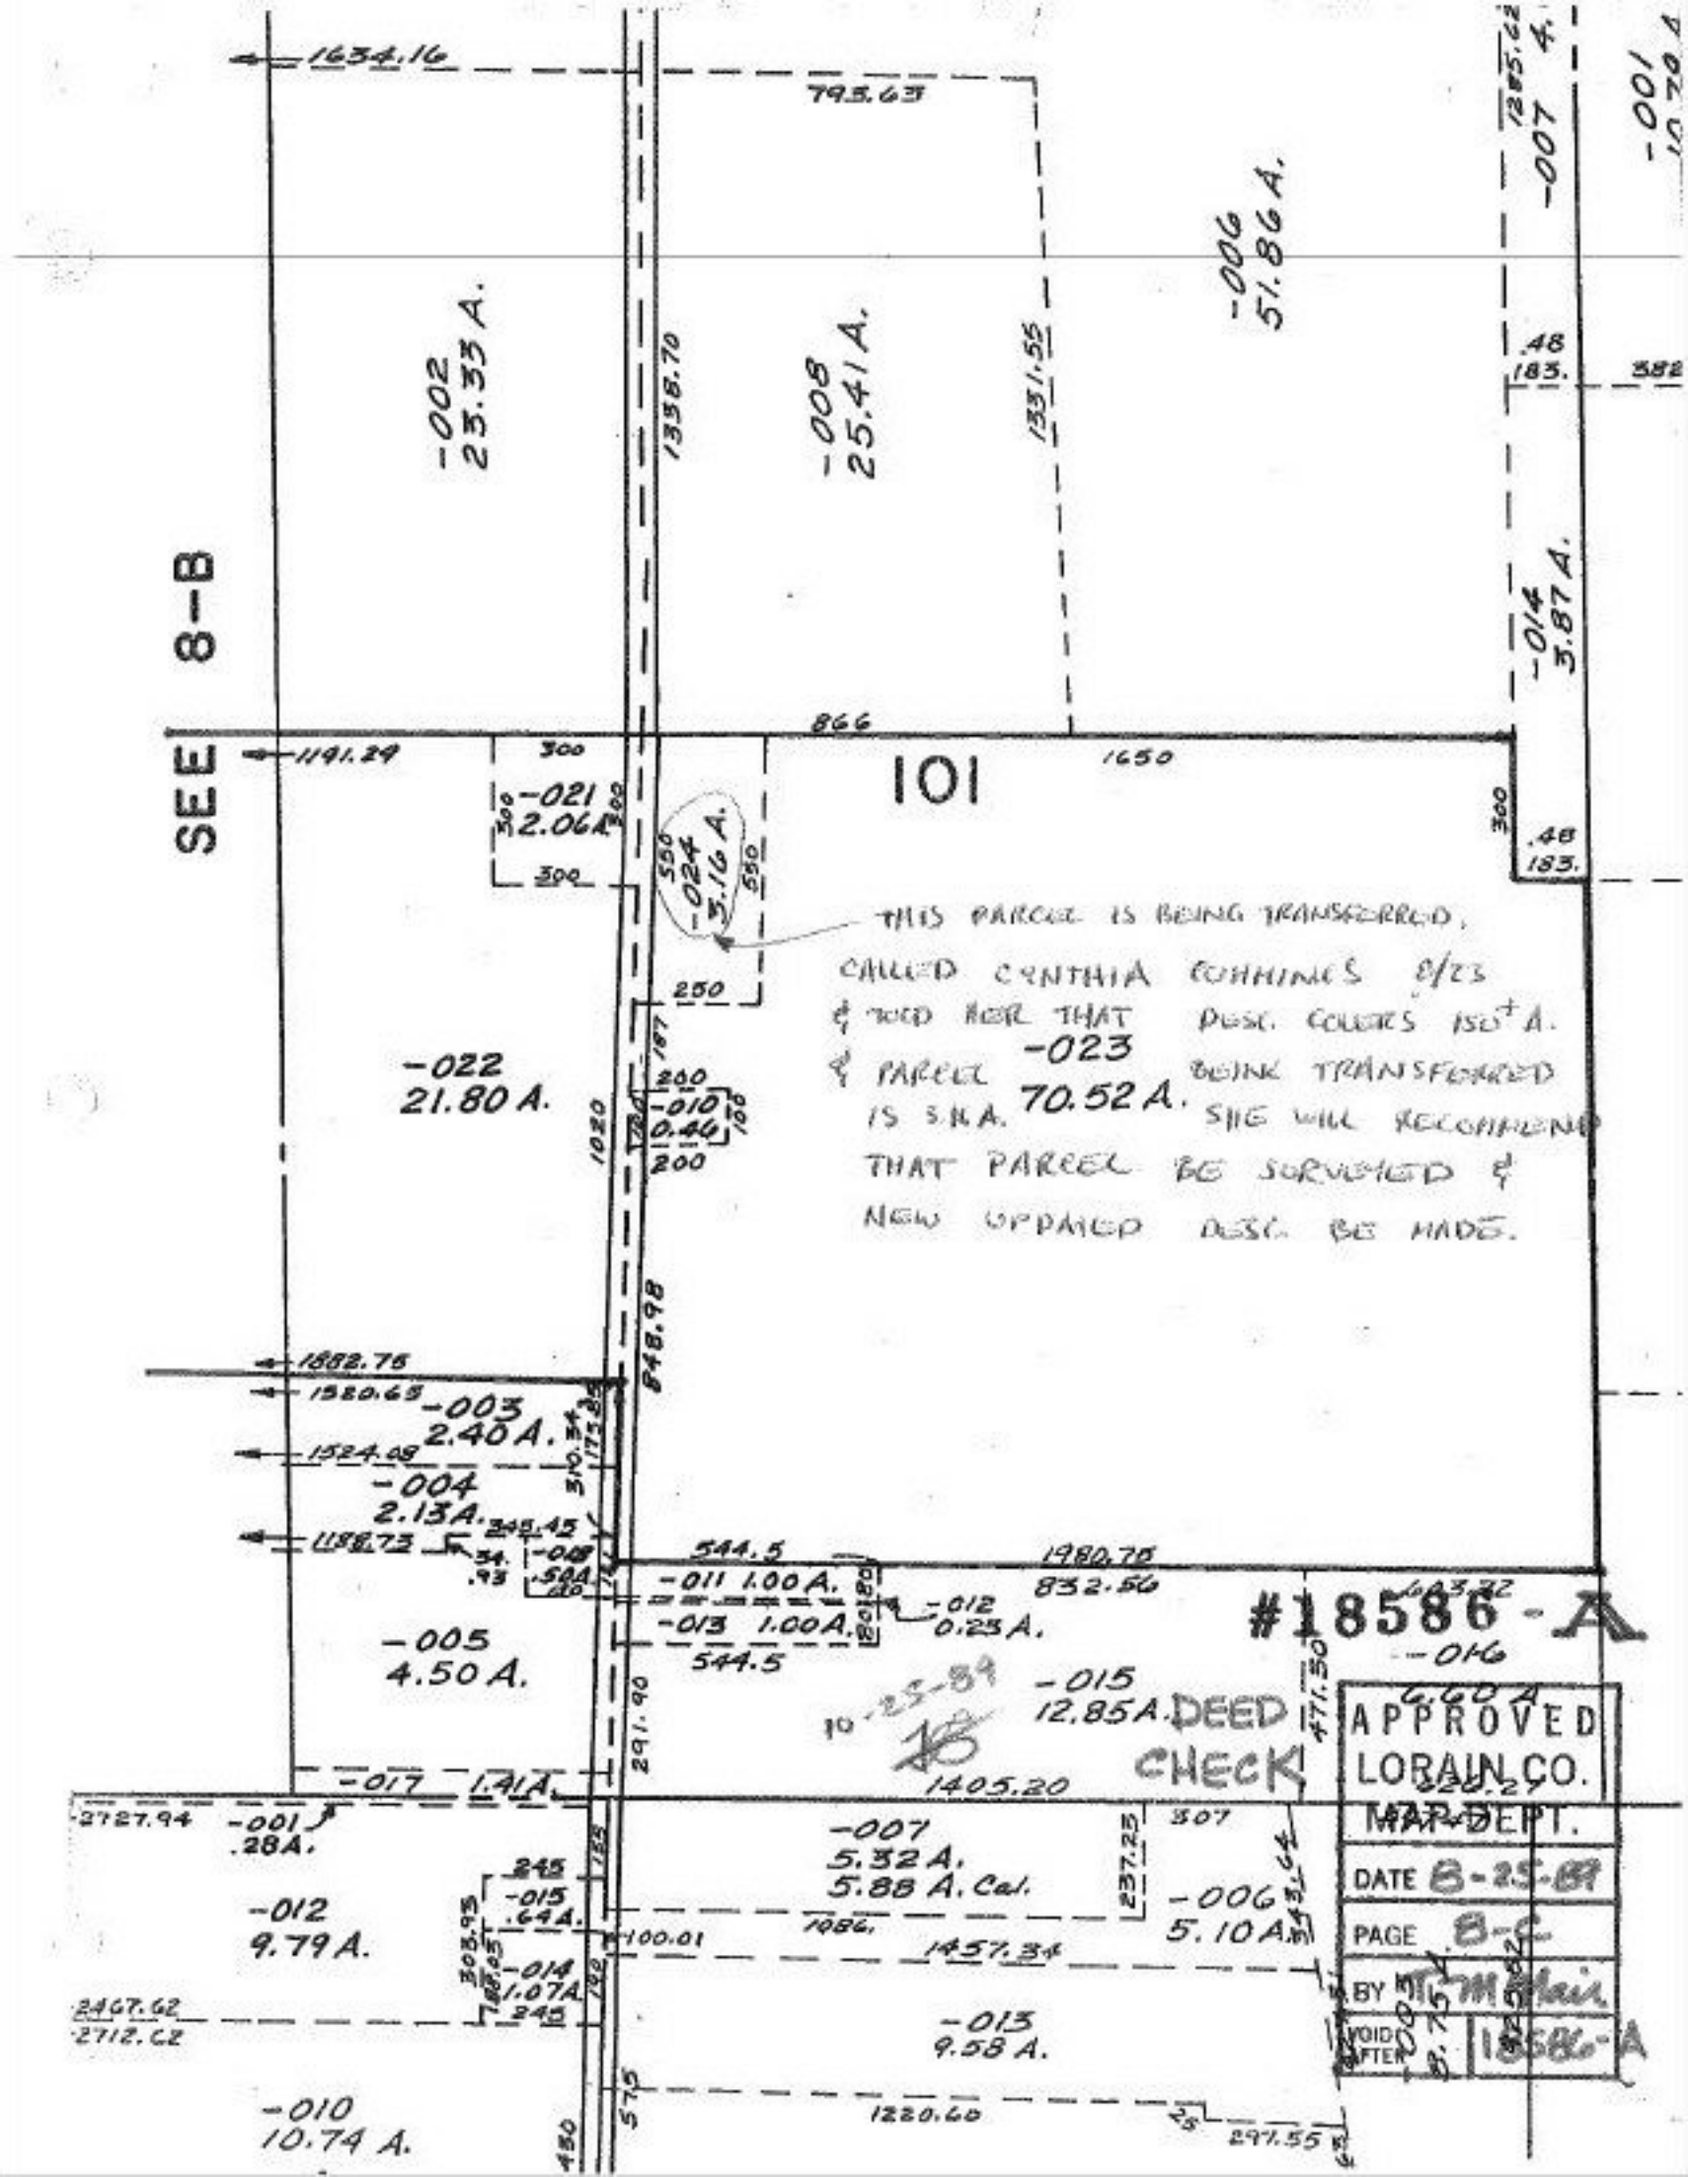
SEE 8-B
101
1634.16
795.63
-002
23.33 A.
1358.70
-008
25.41 A.
1331.55
-006
51.86 A.
-014
3.87 A.
866
1650
1191.29
300
-021
2.06 A.
-024
3.16 A.
THIS PARCEL IS BEING TRANSFERRED, CALLED CYNTHIA FOHRINGS 8/23 & DEED FOR THAT DESC. COVERS 150+ A. & PARCEL IS S.N.A. -023 70.52 A. BEING TRANSFERRED SHE WILL RECOMMEND THAT PARCEL BE SURVEYED & NEW UPDATED DESC. BE MADE.
-022
21.80 A.
1020
-010
0.46
848.98
1882.76
1520.65
-003
2.40 A.
1524.08
-004
2.13 A.
1188.72
544.5
1980.78
832.56
-011 1.00 A.
-013 1.00 A.
-012
0.23 A.
-005
4.50 A.
544.5
-015
12.85 A. DEED CHECK
10-25-89
1405.20
-016
660 A
-017 1.41 A.
291.90
2727.94
-001
.28 A.
-007
5.32 A.
5.88 A. Cal.
-006
5.10 A.
-012
9.79 A.
-015
.64 A.
-014
1.07 A.
-013
9.58 A.
-010
10.74 A.
1220.60
297.55
#18586-A
APPROVED
LORAIN CO.
MAP DEPT.
DATE 8-25-89
PAGE 8-C
BY T.M. Weir
VOID AFTER
18586-A