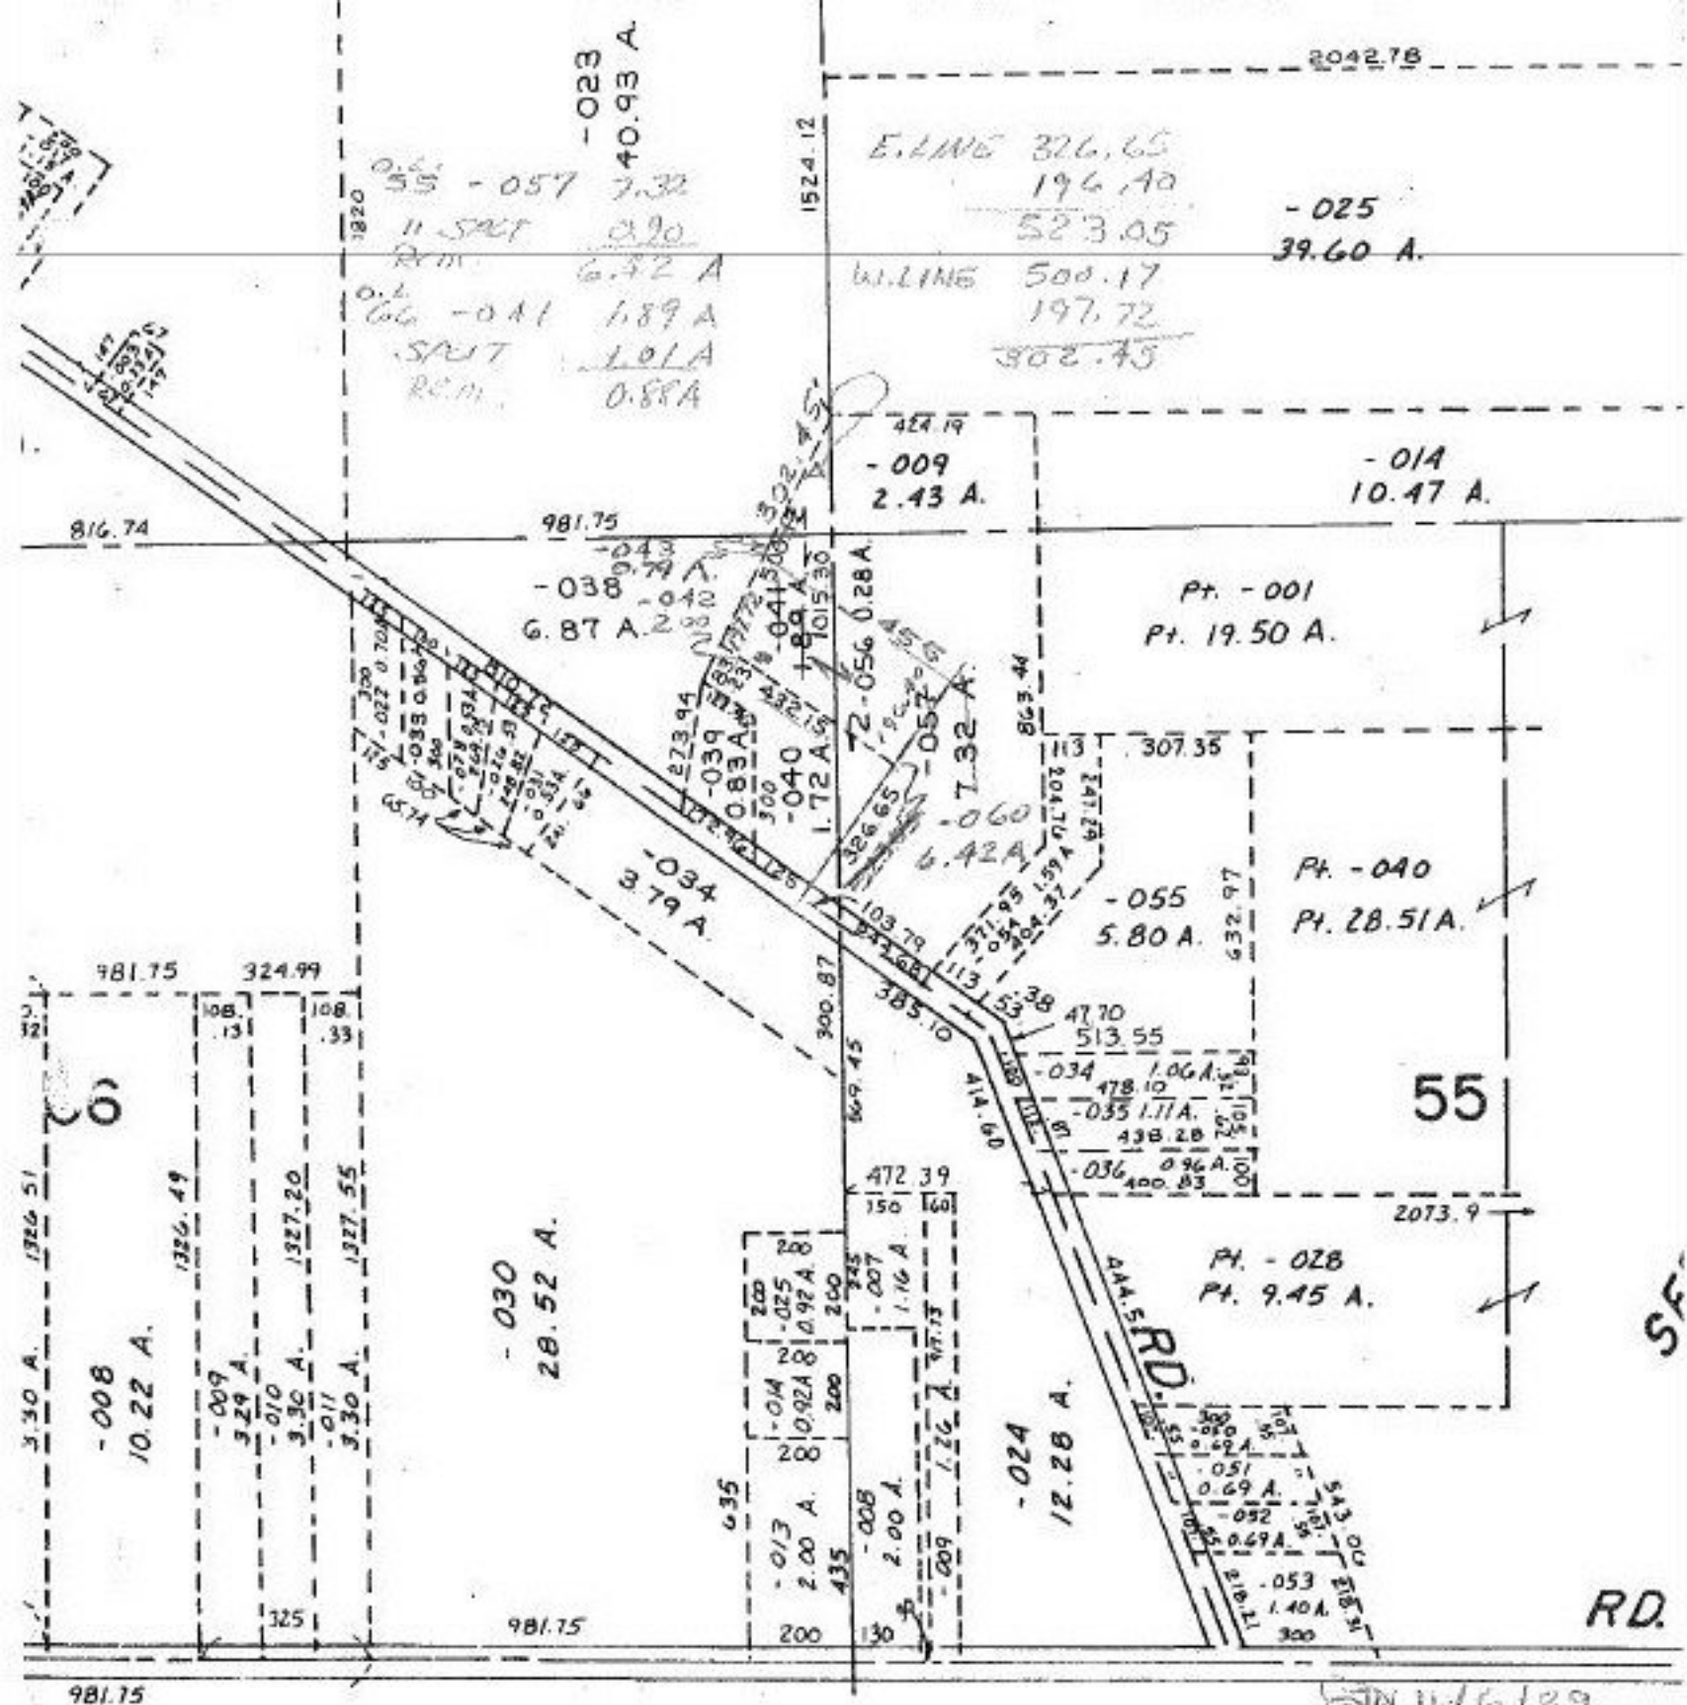

11/16/89

#18588

51 THRU 55
66 = 75

11-00-066-000-
11-00-055-000-
PRIOR INST. 1371/66
C=1:250000.

SURVEYED BY:
JOHN R. HAMILTON
REG. SURV.

APPROVED
LORAIN CO.
MAP DEPT.
DATE 8-18-89
PAGE 11-B
BY CAROLYN FRANCIS
VOID AFTER # 18588