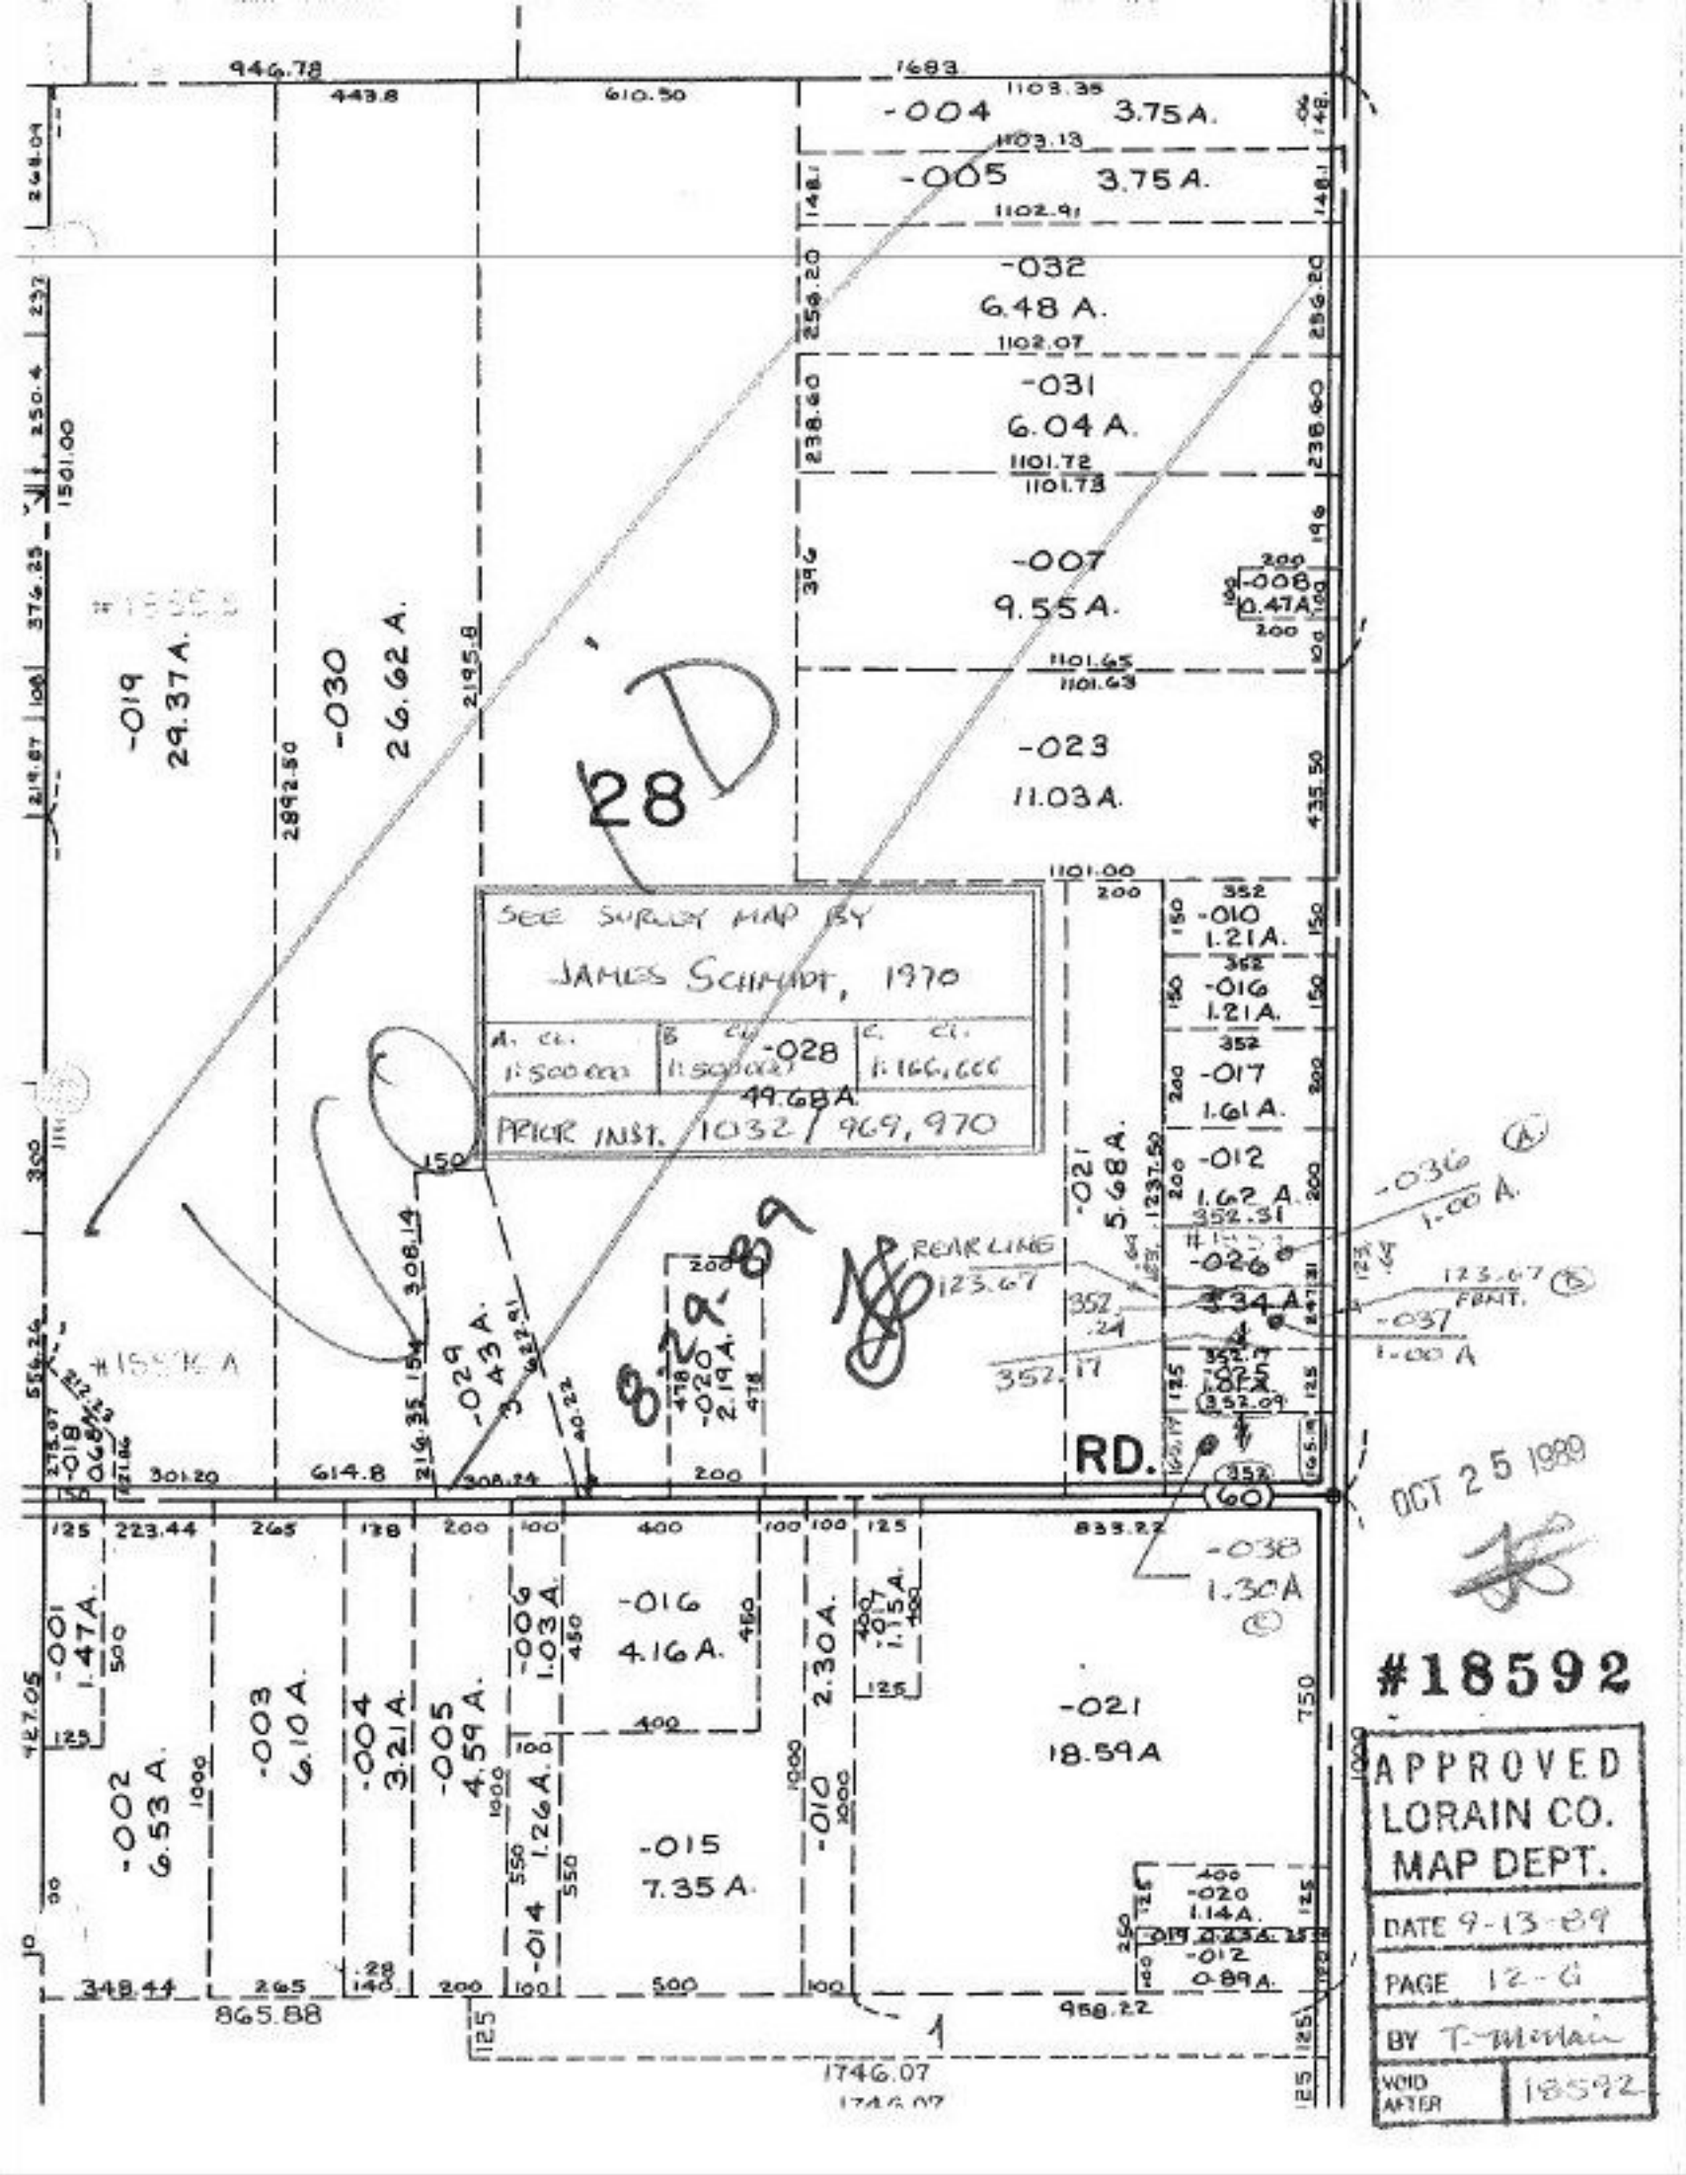
946.78
443.8
610.50
1683
-004
3.75A.
-005
3.75A.
-032
6.48 A.
-031
6.04 A.
-007
9.55A.
-008
0.47A.
-023
11.03A.
-019
29.37A.
-030
26.62 A.
2892.50
2195.8
1501.00
SEE SURVEY MAP BY
JAMES SCHMIDT, 1970
A. cl. 1:500,000
B. cl. 1:50,000
C. cl. 1:166,666
PRIOR INST. 1032 / 969, 970
-028
49.68A.
-029
.43 A.
-018
.06A.
-020
2.19A.
-021
5.68A.
-010
1.21A.
-016
1.21A.
-017
1.61A.
-012
1.62 A.
-026
.34 A.
-036
1.00 A.
-037
1.00 A.
-038
1.30A
REAR LINE
123.67
FRONT.
352.31
352.24
352.17
352.09
RD.
614.8
301.20
308.24
214.35
40.22
8-29-89
DCT 25 1989
-001
1.47A.
-002
6.53 A.
-003
6.10A.
-004
3.21A.
-005
4.59 A.
-006
1.03A.
-014
1.26A.
-016
4.16A.
-015
7.35A.
-010
2.30A.
-021
18.59A
-020
1.14A.
-012
0.89A.
865.88
958.22
1746.07
#18592
APPROVED
LORAIN CO.
MAP DEPT.
DATE 9-13-89
PAGE 12-G
BY T. Moran
VOID AFTER 18592