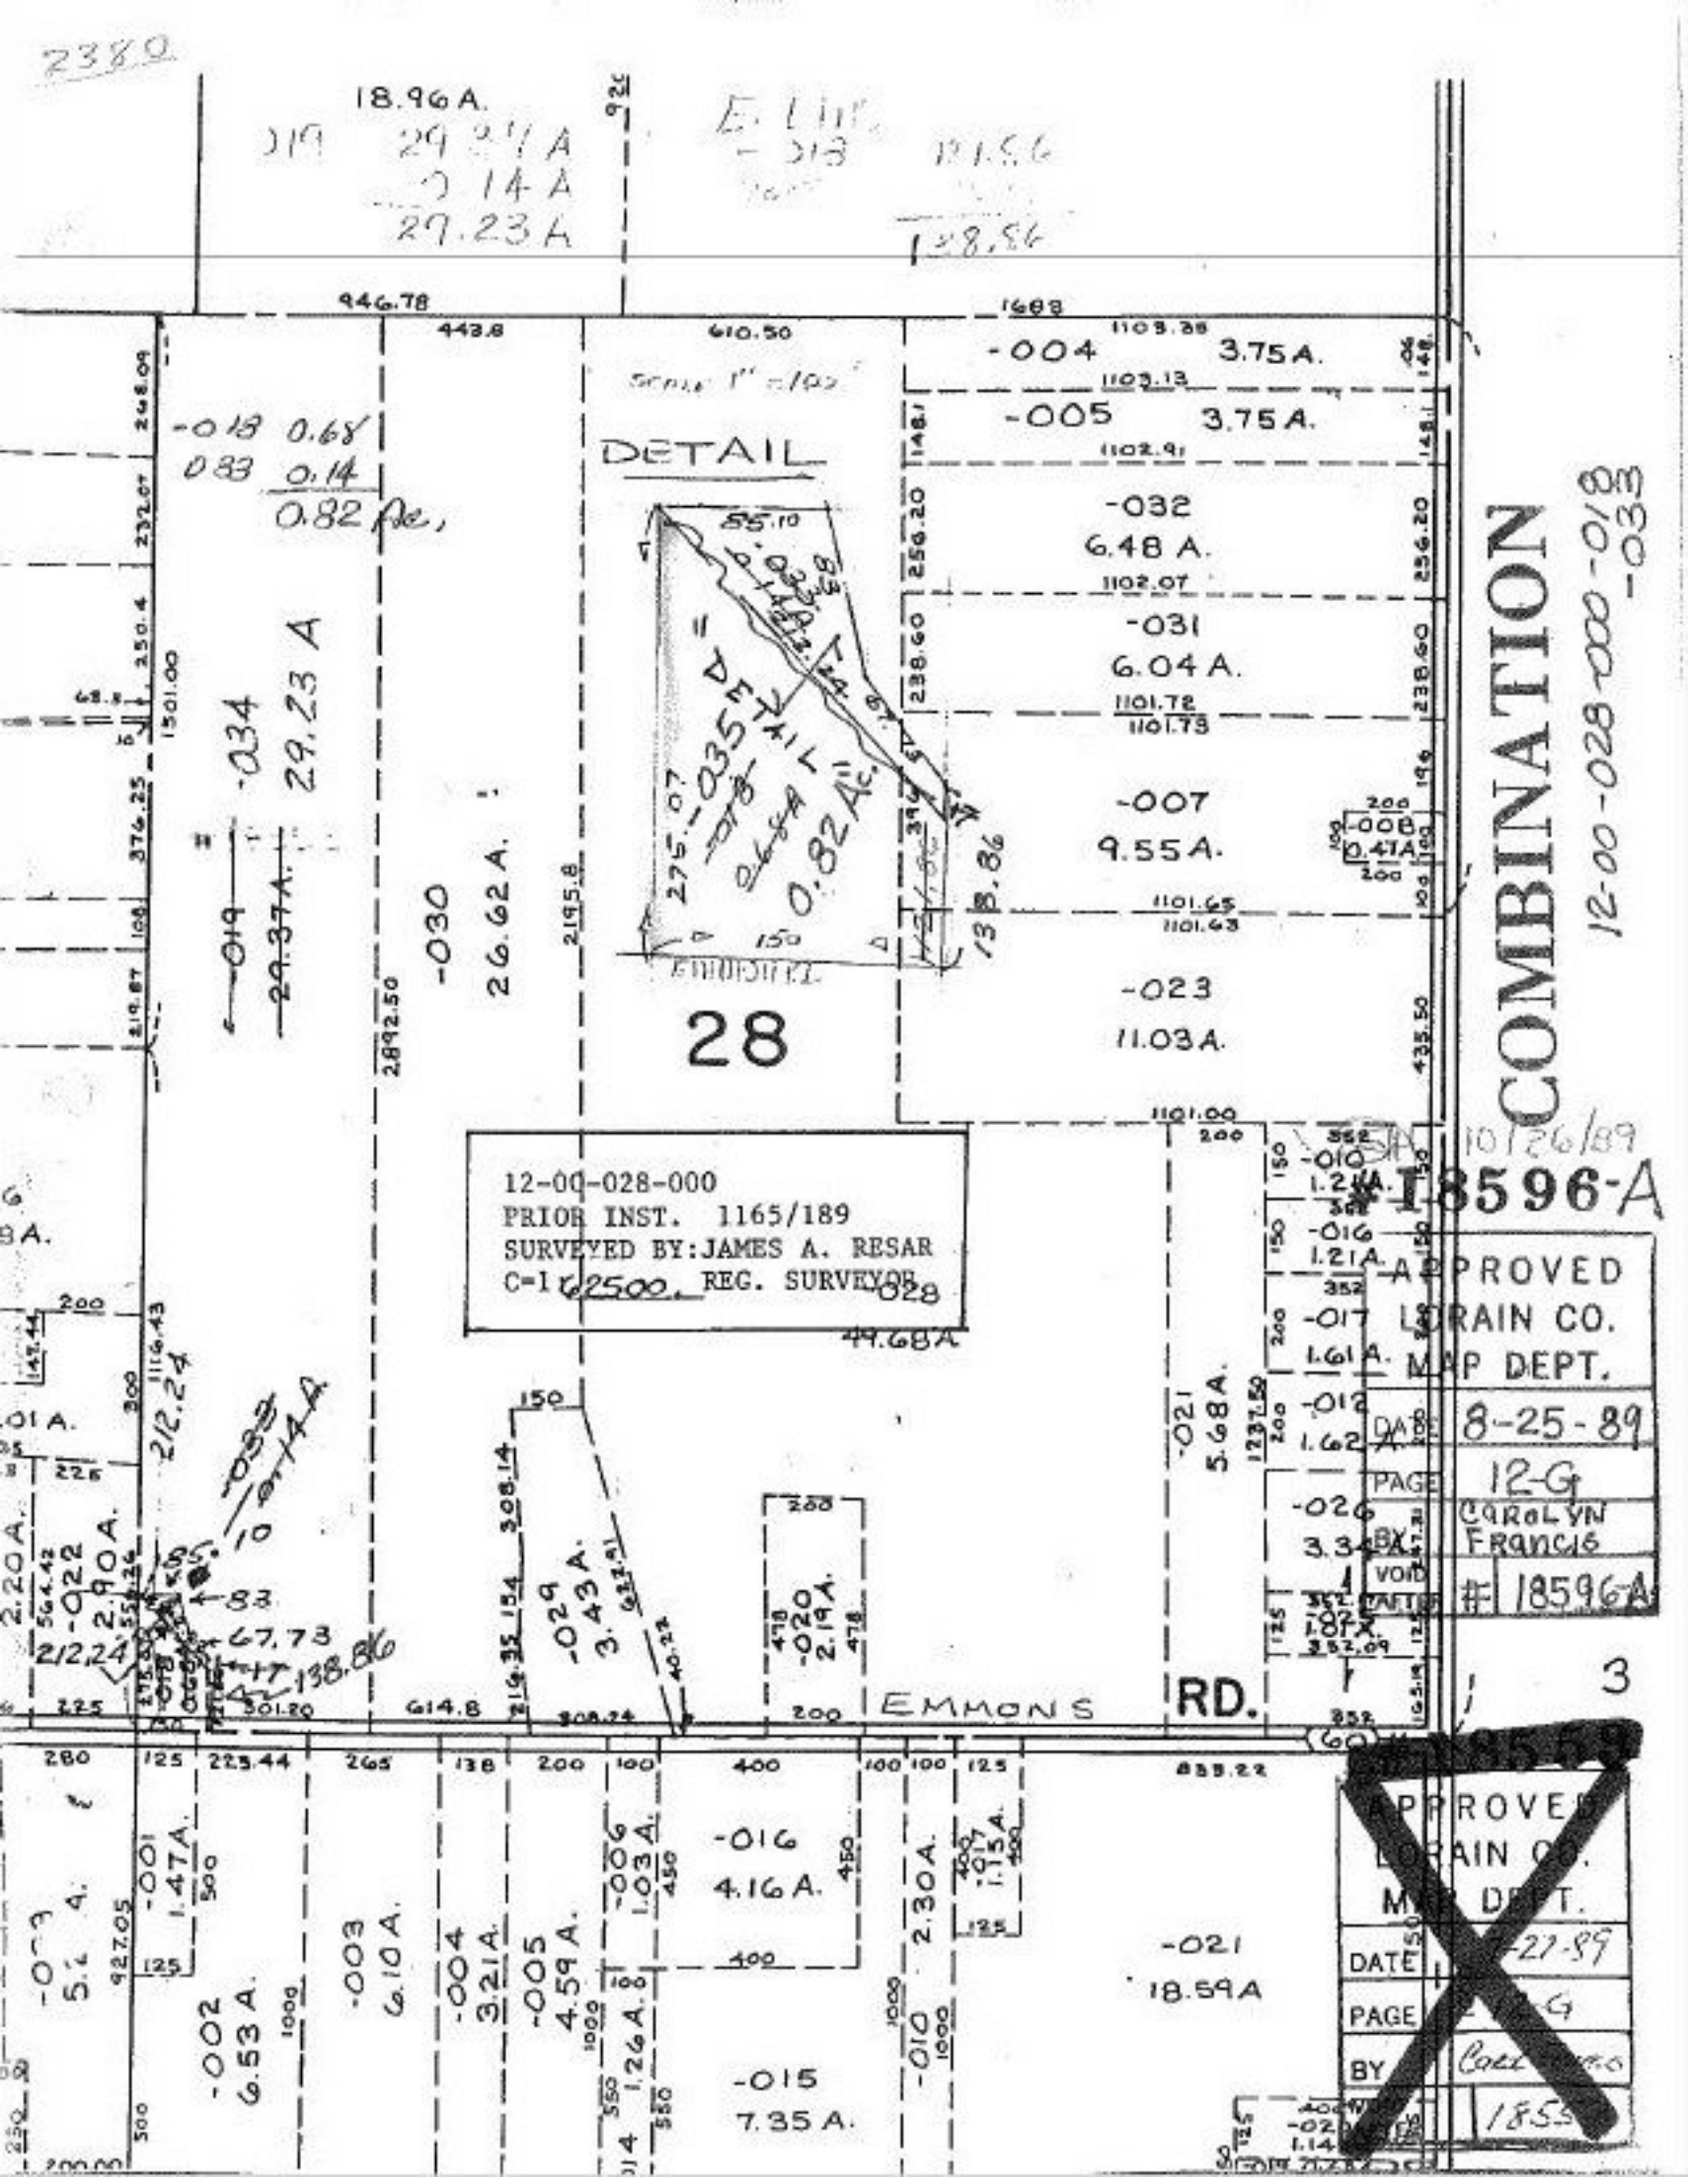
2380
18.96A.
019 29.23A
014A
29.23A
E. LINE
-018
946.78
443.8
610.50
1103.38
-004 3.75A.
1103.13
-005 3.75A.
1102.91
-032 6.48A.
1102.07
-031 6.04A.
1101.72
1101.78
-007 9.55A.
-008 0.47A.
1101.65
1101.63
-023 11.03A.
1101.00
DETAIL
SCALE 1" = 100'
0.82 Ac.
275.07
-035
-034 29.23A
-019 29.37A
-030 26.62A.
2892.50
28
-018 0.68
083 0.14
0.82 Ac.
12-00-028-000
PRIOR INST. 1165/189
SURVEYED BY: JAMES A. RESAR
C=1/2500. REG. SURVEYOR
49.68A
-028
-021 5.68A.
-010 1.21A.
-016 1.21A.
-017 1.61A.
-012 1.62A.
-026 3.34A.
-027 1.07A.
COMBINATION
12-00-028-000-018
-033
10/26/89
#18596-A
APPROVED
LORAIN CO.
MAP DEPT.
DATE 8-25-89
PAGE 12-G
BY CAROLYN FRANCIS
VOID
18596-A
-022 2.90A.
-029 3.43A.
-020 2.19A.
EMMONS RD.
614.8
-001 1.47A.
-002 6.53A.
-003 6.10A.
-004 3.21A.
-005 4.59A.
-006 1.03A.
-016 4.16A.
-015 7.35A.
-021 18.59A
-010 2.30A.
-013 1.15A.
APPROVED
LORAIN CO.
MAP DEPT.
DATE 8-27-89
PAGE 12-G
BY Carolyn Francis
