

BERLIN NORTH

203.75

75


123.75

123.75

175.5

435.62

29.90-027
- 6.54 Rem'
23.06 SPLIT

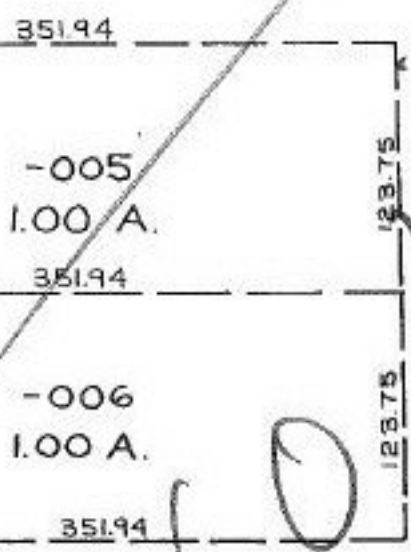

Pt. -027
Pt. 29.90A.

11-8-89

12/15/89
18597

9-00-066-A

660
-010
0.98 A.

330
-015
0.51 A.

330
-011
0.72 A.

377.70
-013
1.00 A.

66
90.75

67
65
90.75

59

19

Pt.
Pt.

TCH

16
0 A.

30

17
1 A.