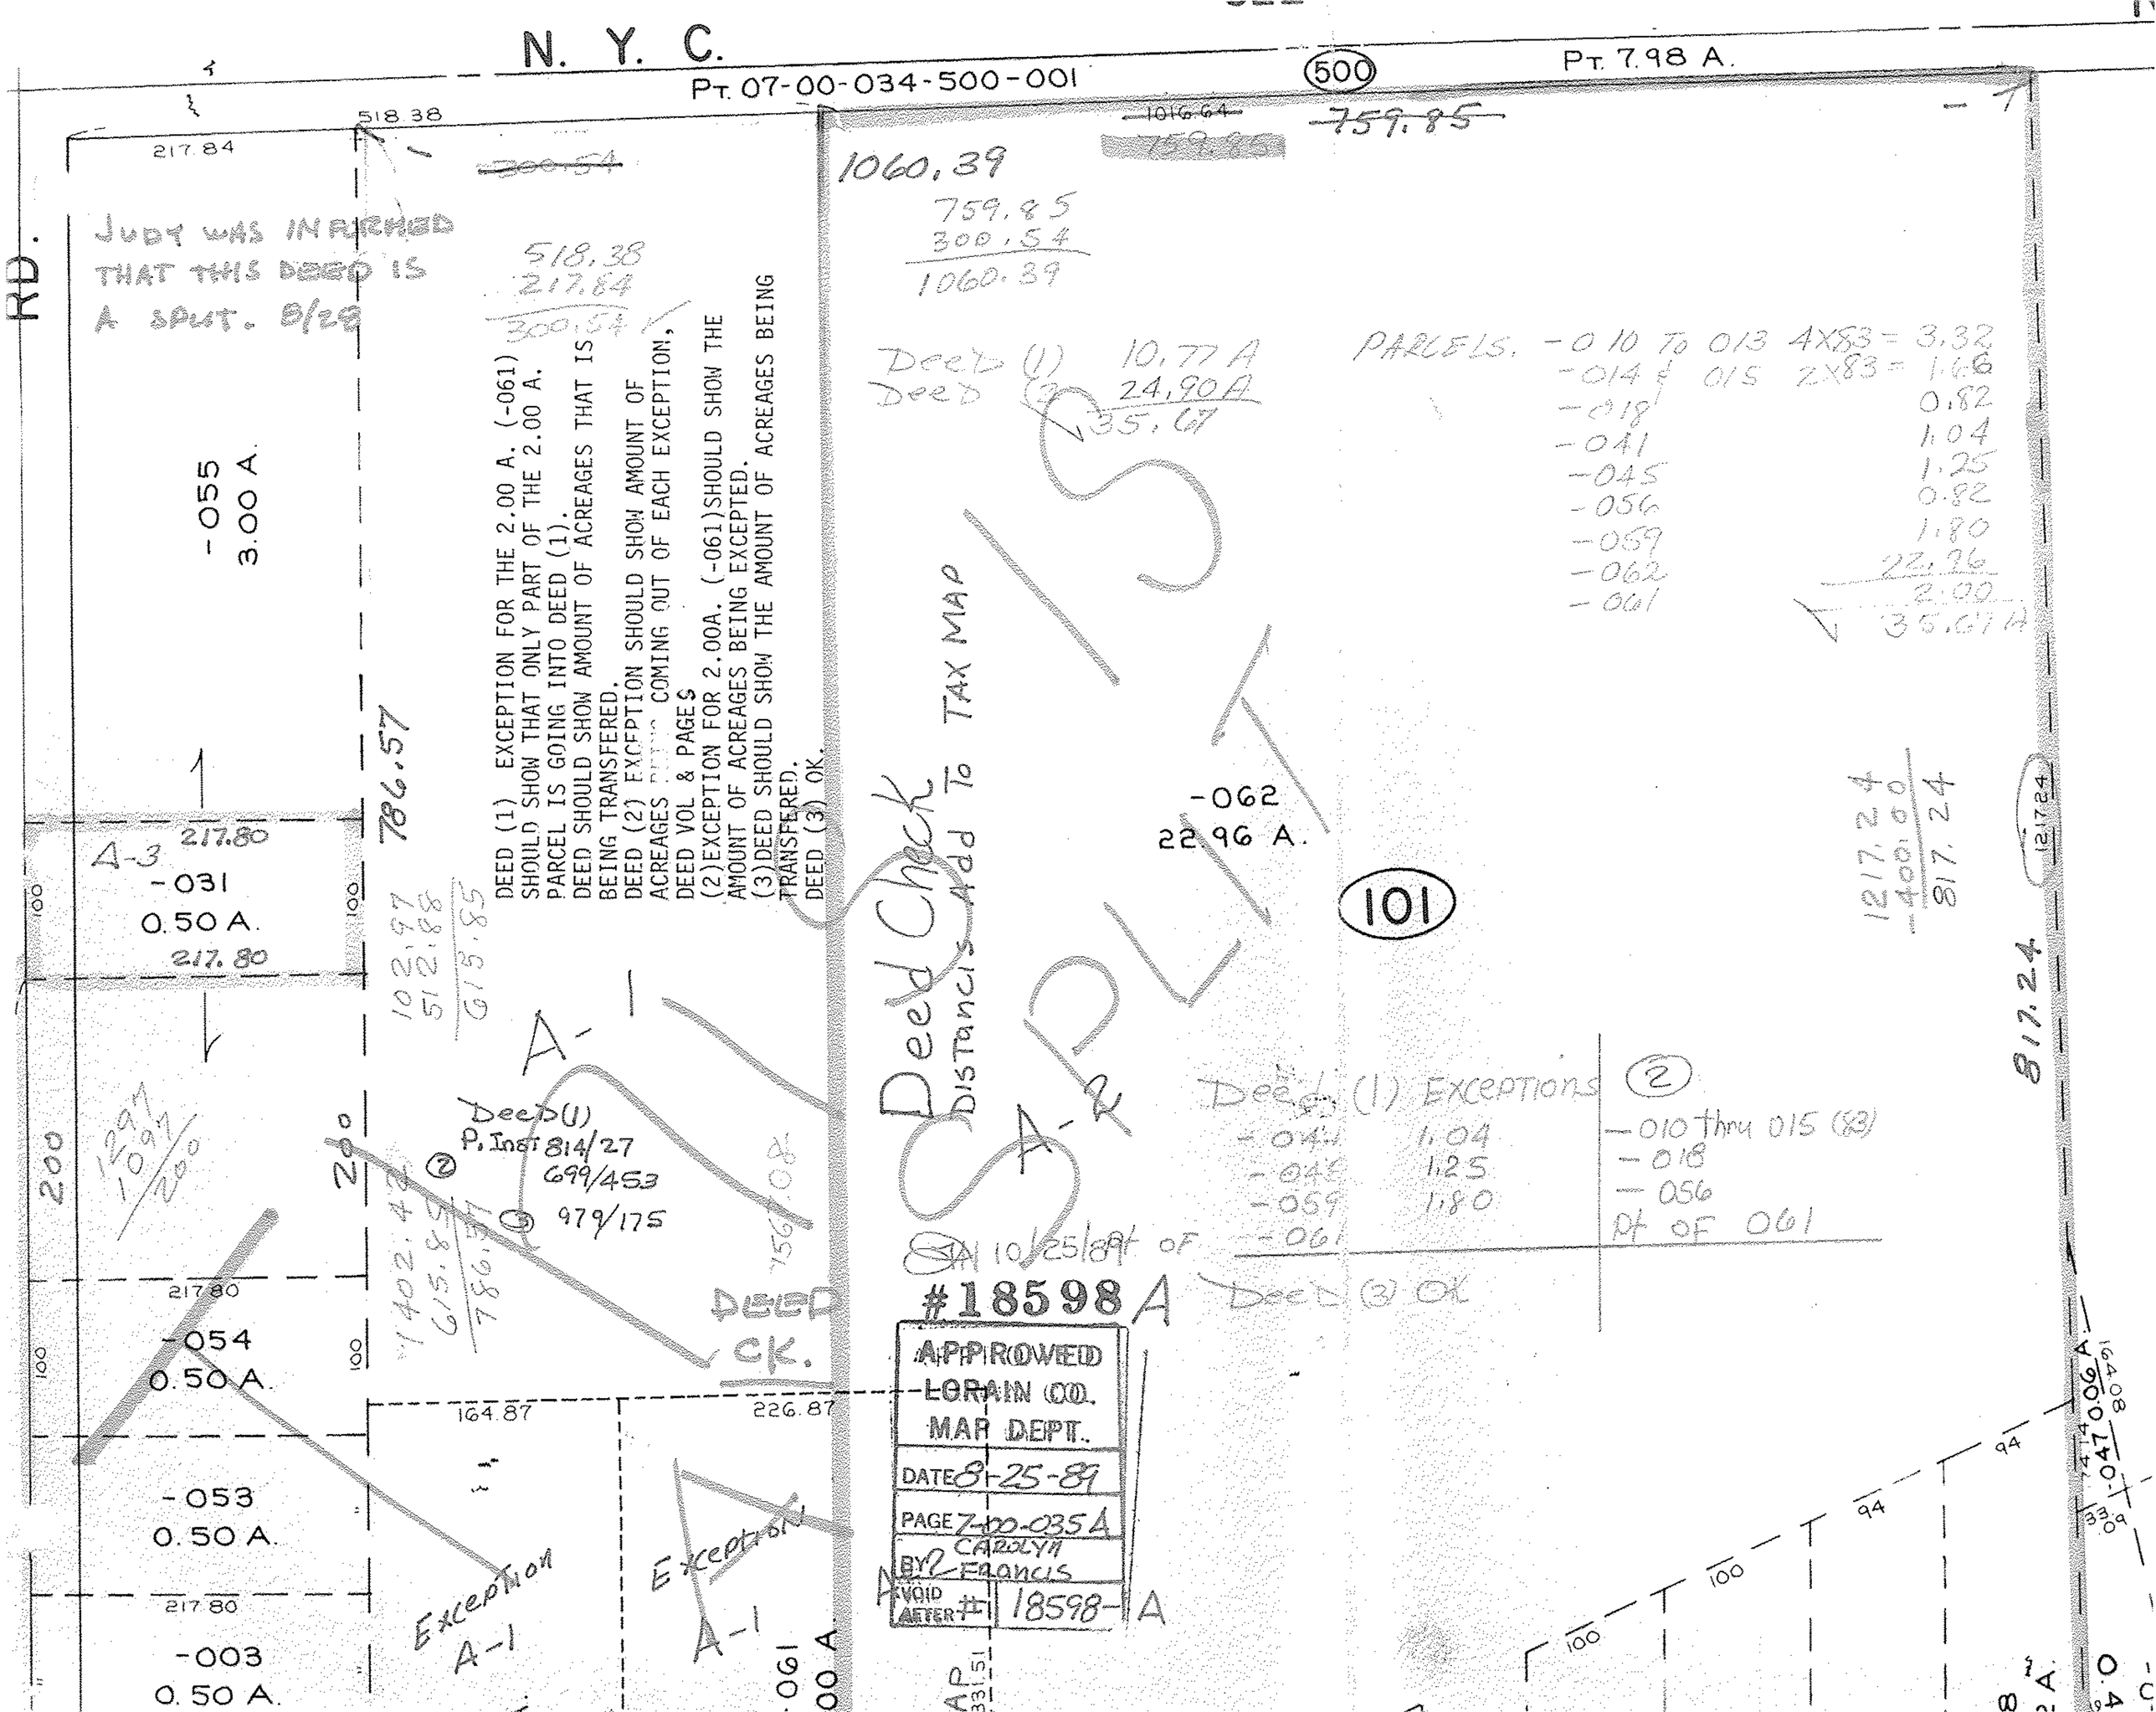
N. Y. C.
Pt. 07-00-034-500-001
500
Pt. 7.98 A.
RD.
518.38
217.84
~~300.54~~
~~1016.64~~
~~759.85~~
1060.39
759.85
300.54
1060.39
JUDY WAS INFORMED THAT THIS DEED IS A SPLIT. 8/28
518.38
217.84
300.54
Deed (1) 10.77 A
Deed (2) 24.90 A
35.67
PARCELS. -010 To 013 4X83 = 3.32
-014 & 015 2X83 = 1.66
-018 0.82
-041 1.04
-045 1.25
-056 0.82
-059 1.80
-062 22.96
-061 2.00
35.67 A
-055
3.00 A.
786.57
DEED (1) EXCEPTION FOR THE 2.00 A. (-061) SHOULD SHOW THAT ONLY PART OF THE 2.00 A. PARCEL IS GOING INTO DEED (1).
DEED SHOULD SHOW AMOUNT OF ACREAGES THAT IS BEING TRANSFERED.
DEED (2) EXCEPTION SHOULD SHOW AMOUNT OF ACREAGES BEING COMING OUT OF EACH EXCEPTION, DEED VOL & PAGES
(2) EXCEPTION FOR 2.00A. (-061) SHOULD SHOW THE AMOUNT OF ACREAGES BEING EXCEPTED.
(3) DEED SHOULD SHOW THE AMOUNT OF ACREAGES BEING TRANSFERED.
DEED (3) OK.
Deed Check
Distancis Add To TAX MAP
-062
22.96 A.
101
1217.24
-400.00
817.24
817.24
A-3
217.80
-031
0.50 A.
217.80
102.97
512.88
615.85
A-1
A-2
Deed (1) Exceptions
-041 1.04
-045 1.25
-059 1.80
-061
(2)
-010 thru 015 (83)
-018
-056
Pt of 061
Deed (3) OK
Deed (1)
P. Inst 814/27
699/453
979/175
1297
1097
200
200
1402.42
615.85
786.57
DEED CK.
10/25/89 Pt of
#18598 A
APPROVED
LORAIN CO.
MAP DEPT.
DATE 8-25-89
PAGE 7-00-035 A
BY CAROLYN FRANCIS
VOID AFTER # 18598-1 A
217.80
-054
0.50 A.
164.87
226.87
-053
0.50 A.
217.80
-003
0.50 A.
Exception A-1
Exception A-1
-061
100 A.
94
100
100
94
94
0.47
0.06 A.
0.4