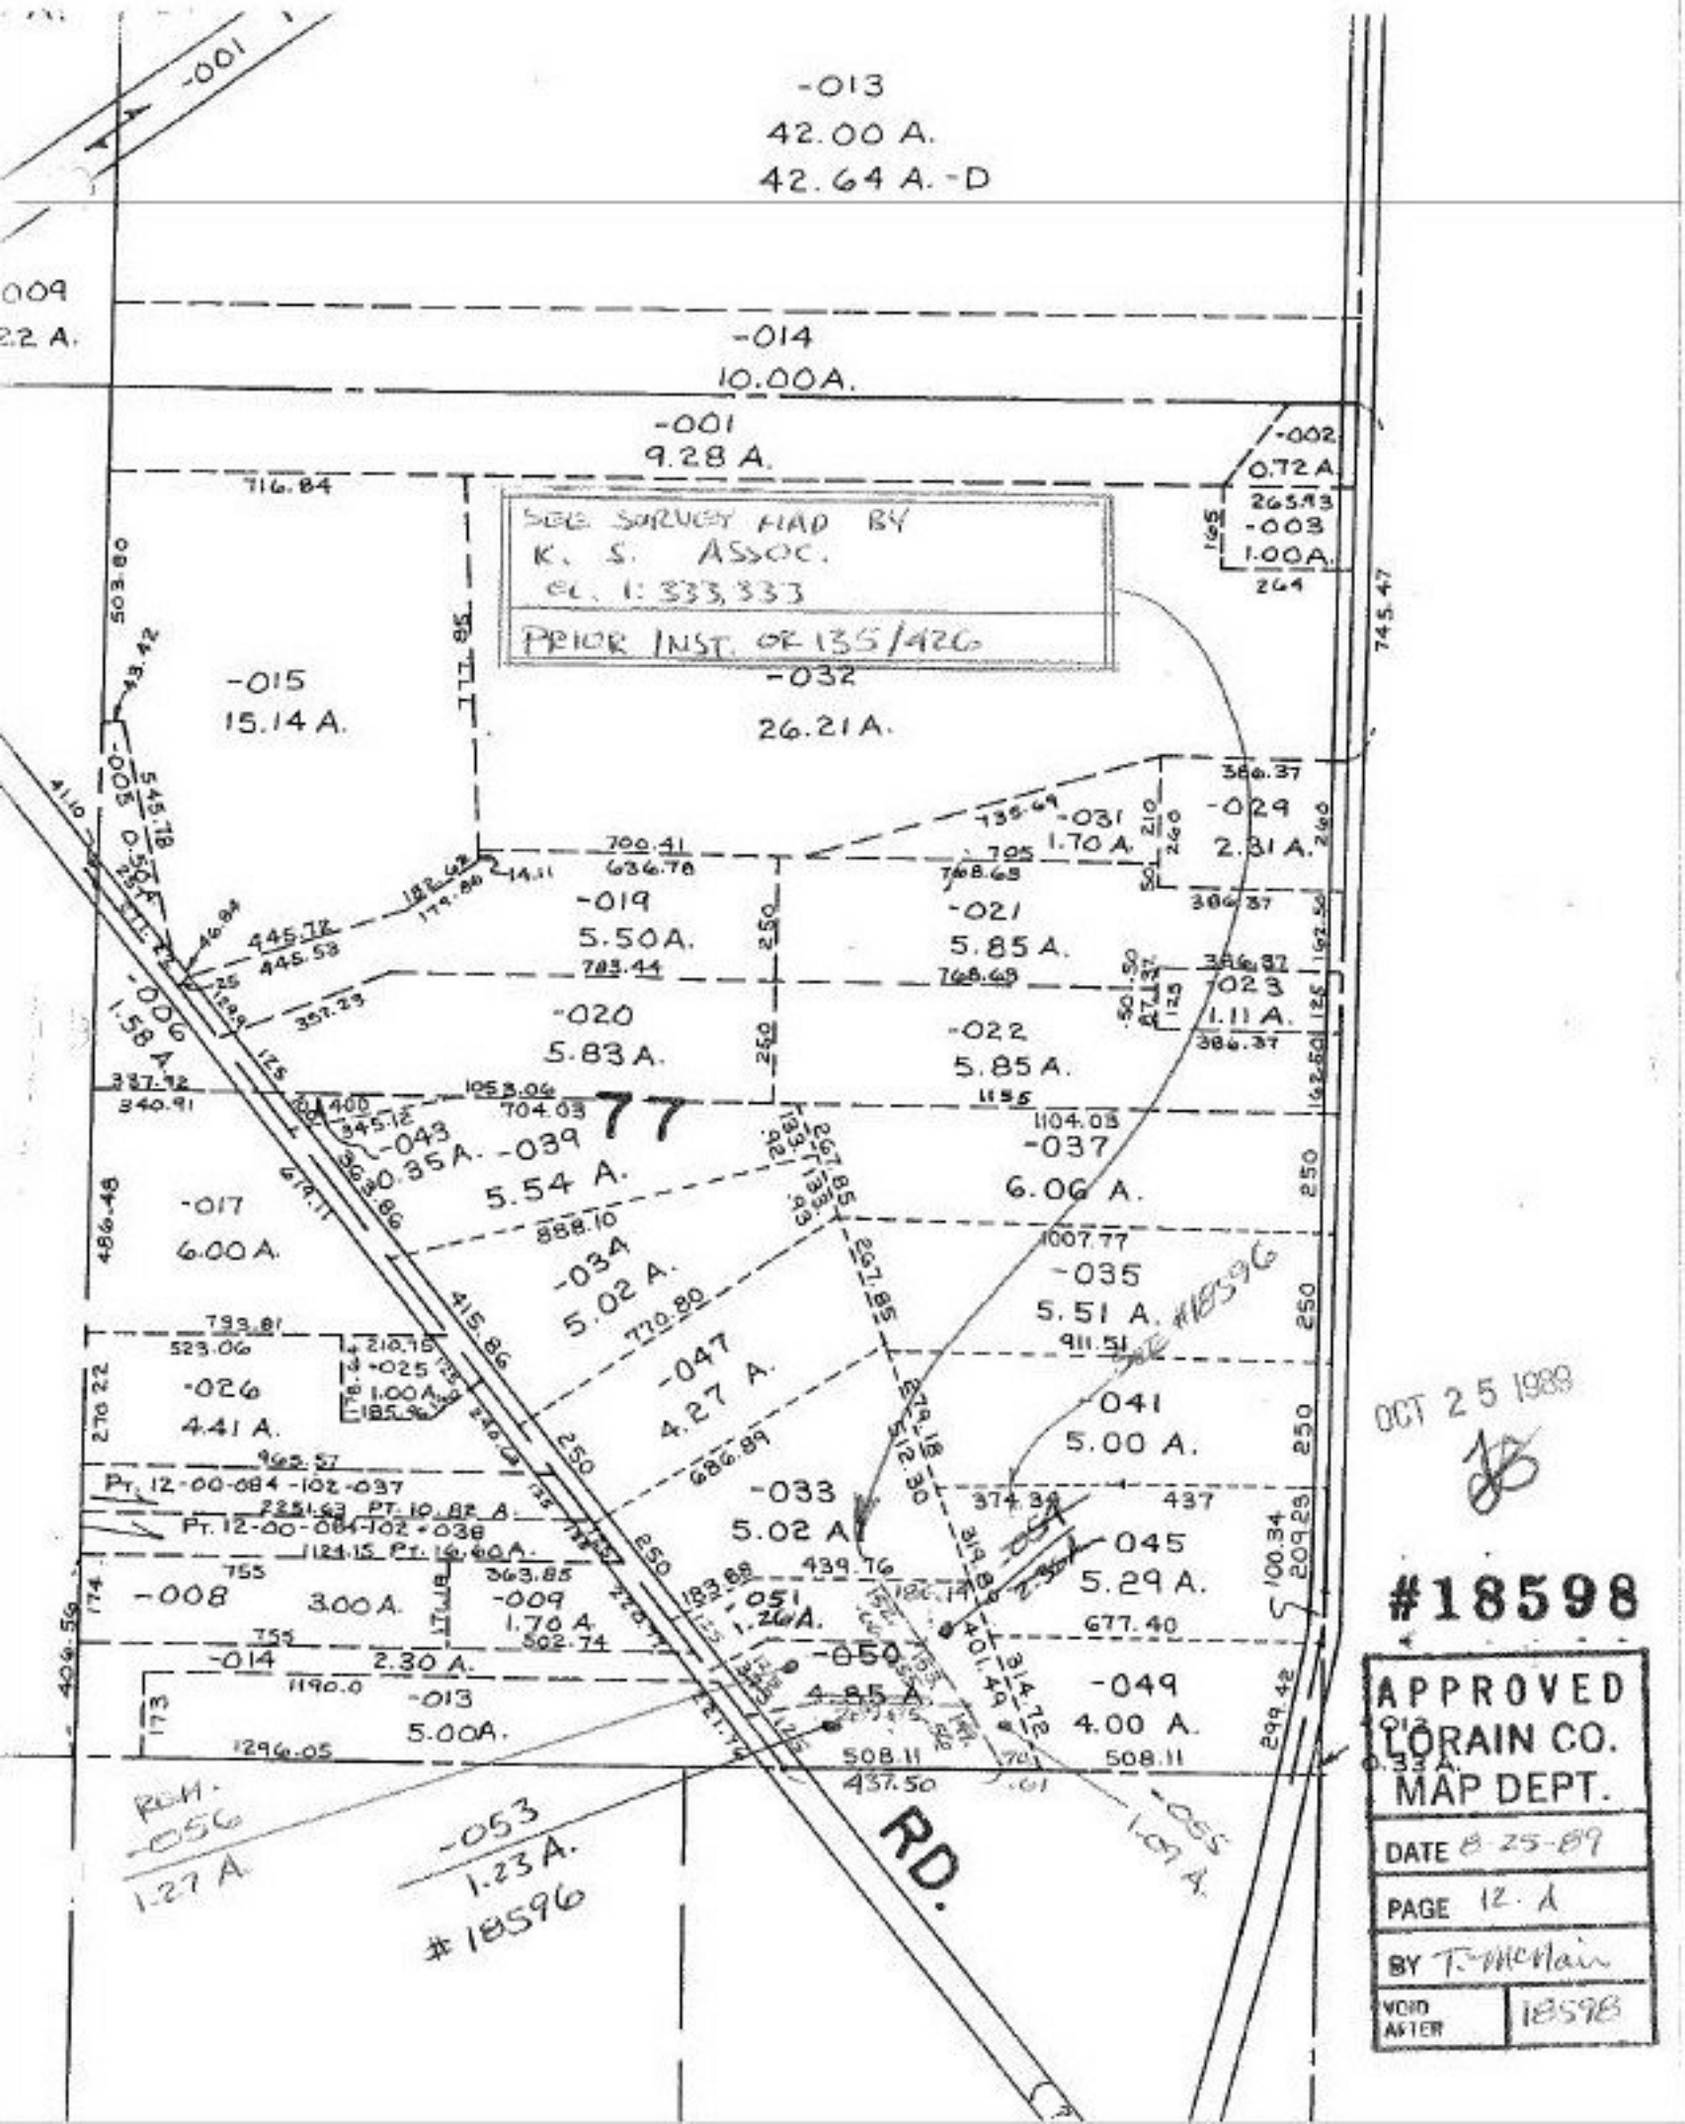
-013
42.00 A.
42.64 A. -D
-014
10.00A.
-001
9.28 A.
-002
0.72 A
-003
1.00A.
SEE SURVEY MAP BY
K. S. ASSOC.
EL. 1: 333,333
PRIOR INST. OR 135/426
-032
26.21A.
-015
15.14 A.
-031
1.70 A.
-029
2.81 A.
-019
5.50A.
-021
5.85 A.
-020
5.83 A.
-022
5.85 A.
-023
1.11 A.
-006
1.58 A.
77
-043
-039
5.54 A.
-017
6.00A.
-037
6.06 A.
-034
5.02 A.
-035
5.51 A.
#18596
-047
4.27 A.
041
5.00 A.
-026
4.41 A.
-025
1.00A.
-033
5.02 A.
045
5.29 A.
-008
3.00A.
-009
1.70 A.
-051
1.20A.
-050
4.85 A.
-049
4.00 A.
-014
2.30 A.
-013
5.00A.
RD.
REM.
-056
1.27 A.
-053
1.23A.
#18596
-055
1.61 A.
OCT 25 1989
#18598
APPROVED
LORAIN CO.
MAP DEPT.
DATE 8-25-89
PAGE 12-A
BY T. McClain
VOID AFTER 18598