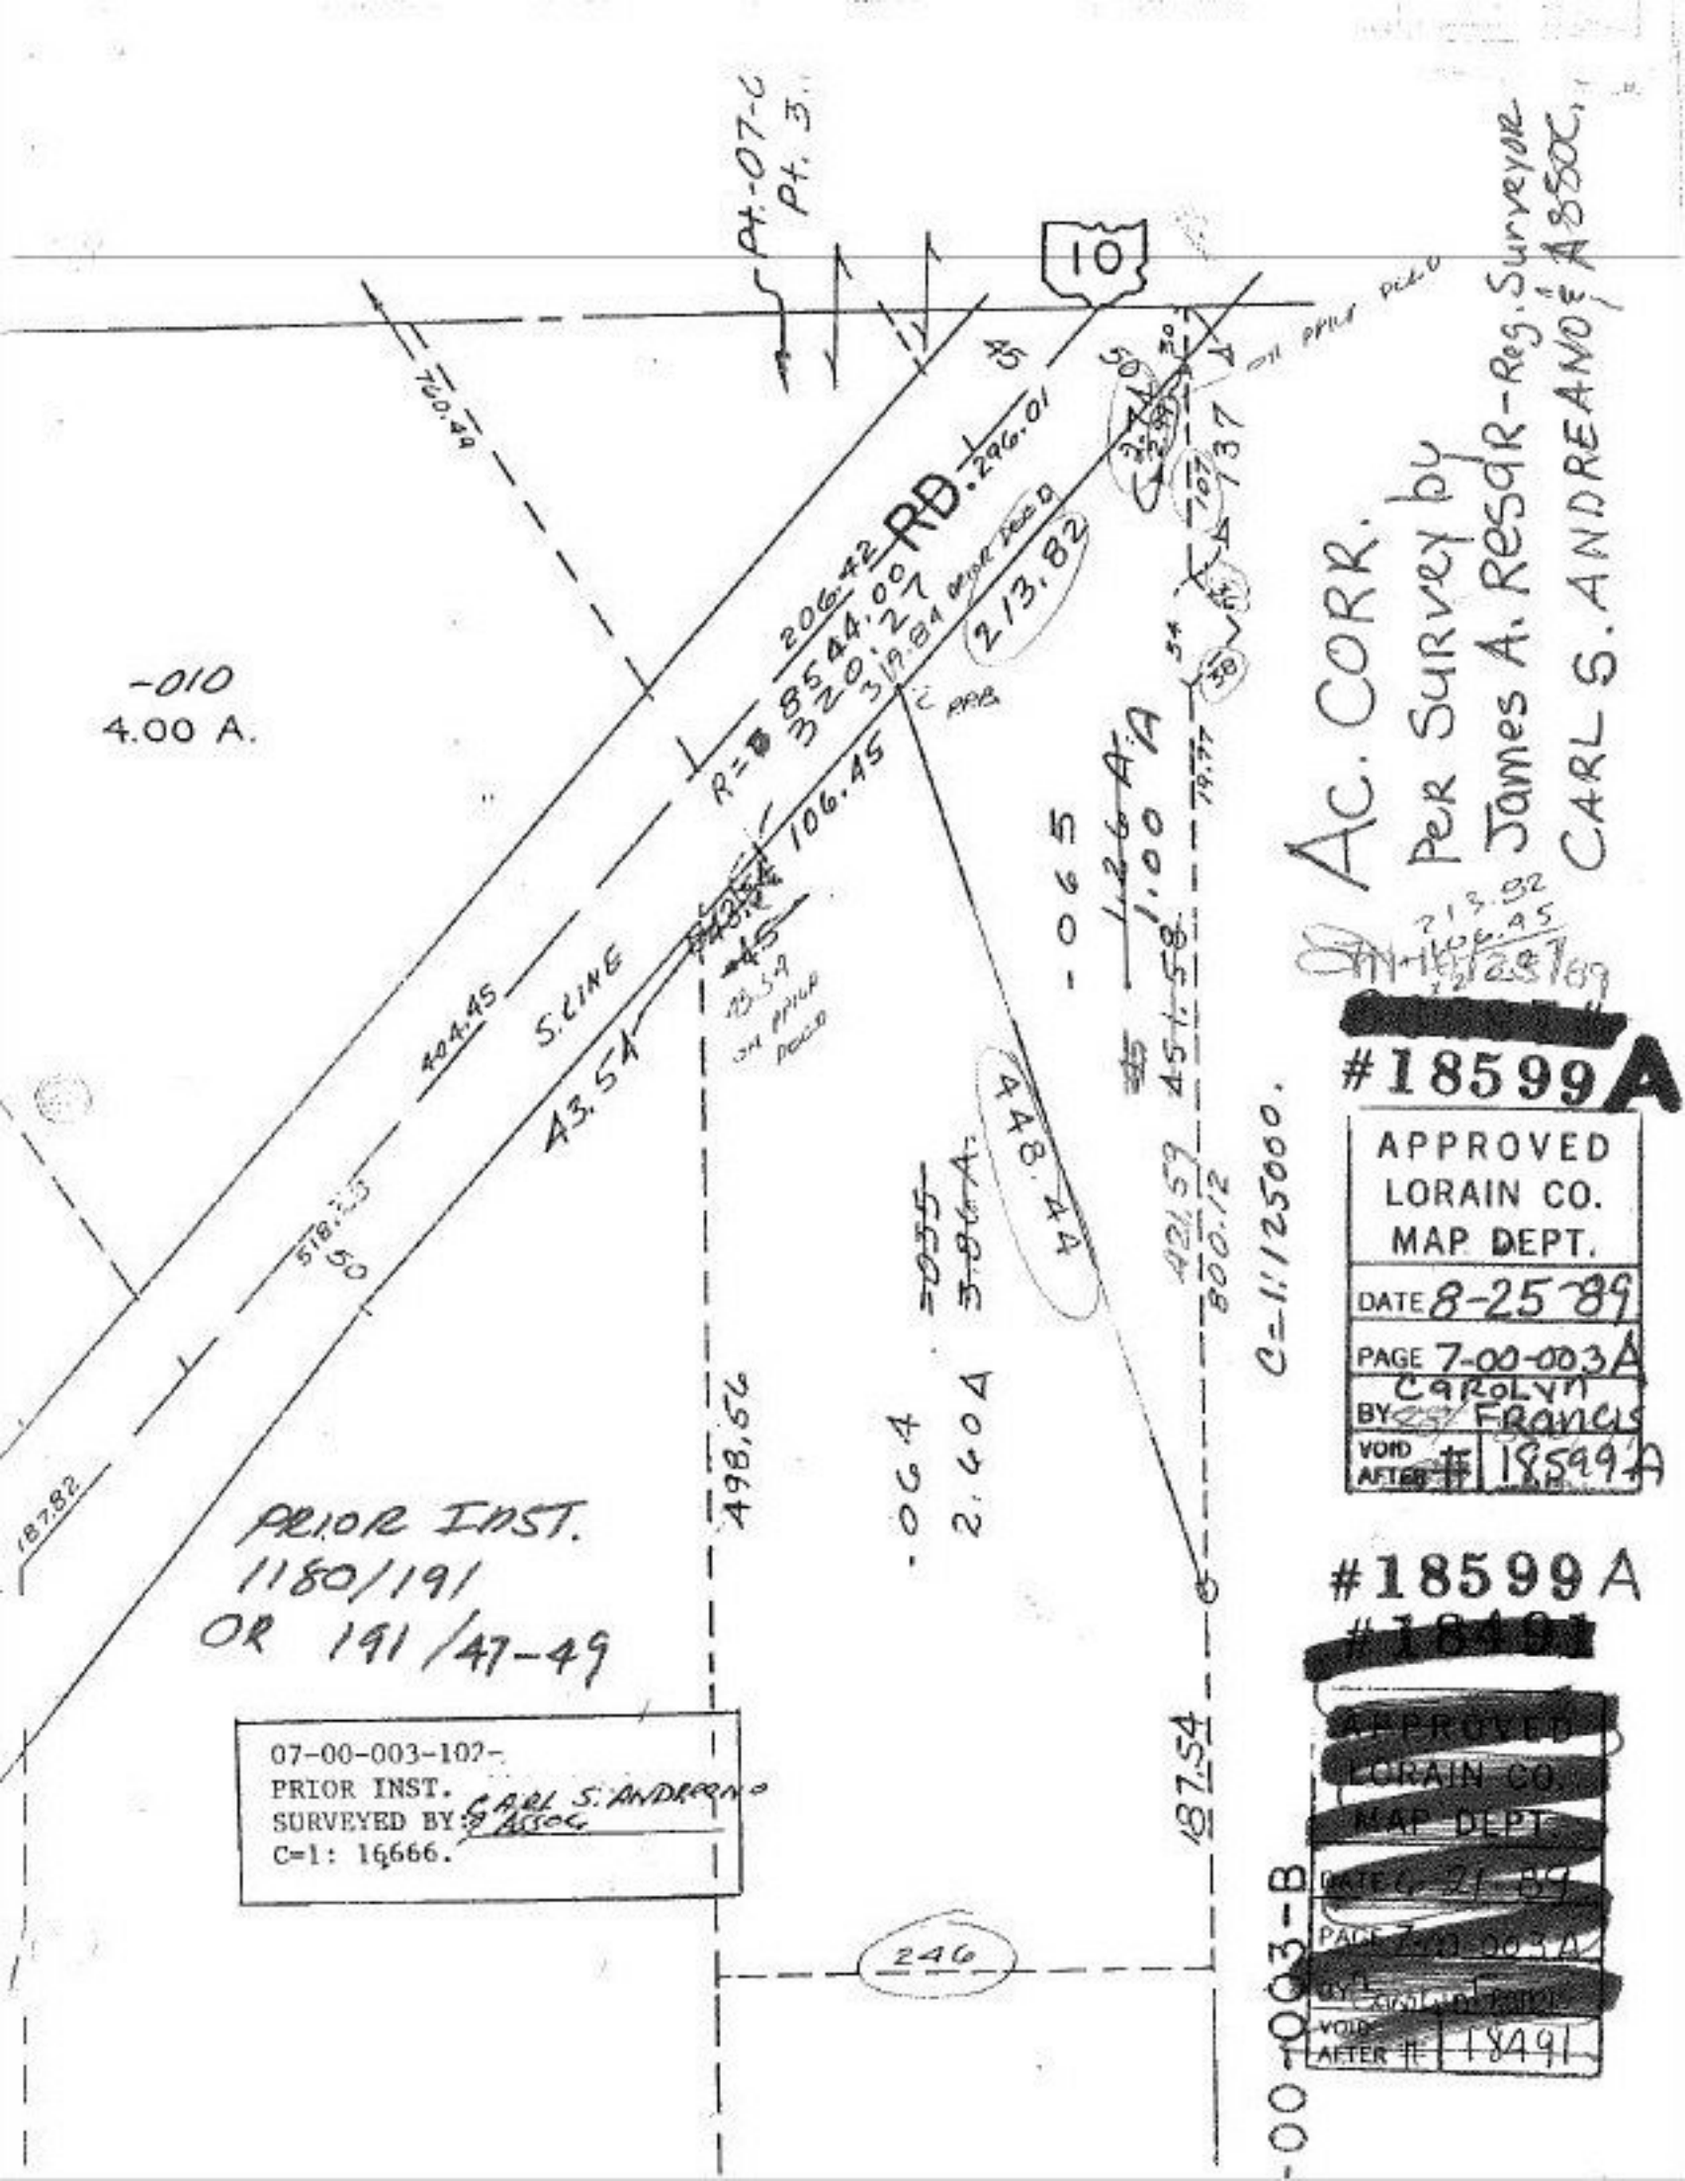

PRIOR INST.
1180/191
OR 191/47-49

07-00-003-107-
PRIOR INST.
SURVEYED BY: CARL S. ANDREANO & ASSOC.
C=1: 16666.