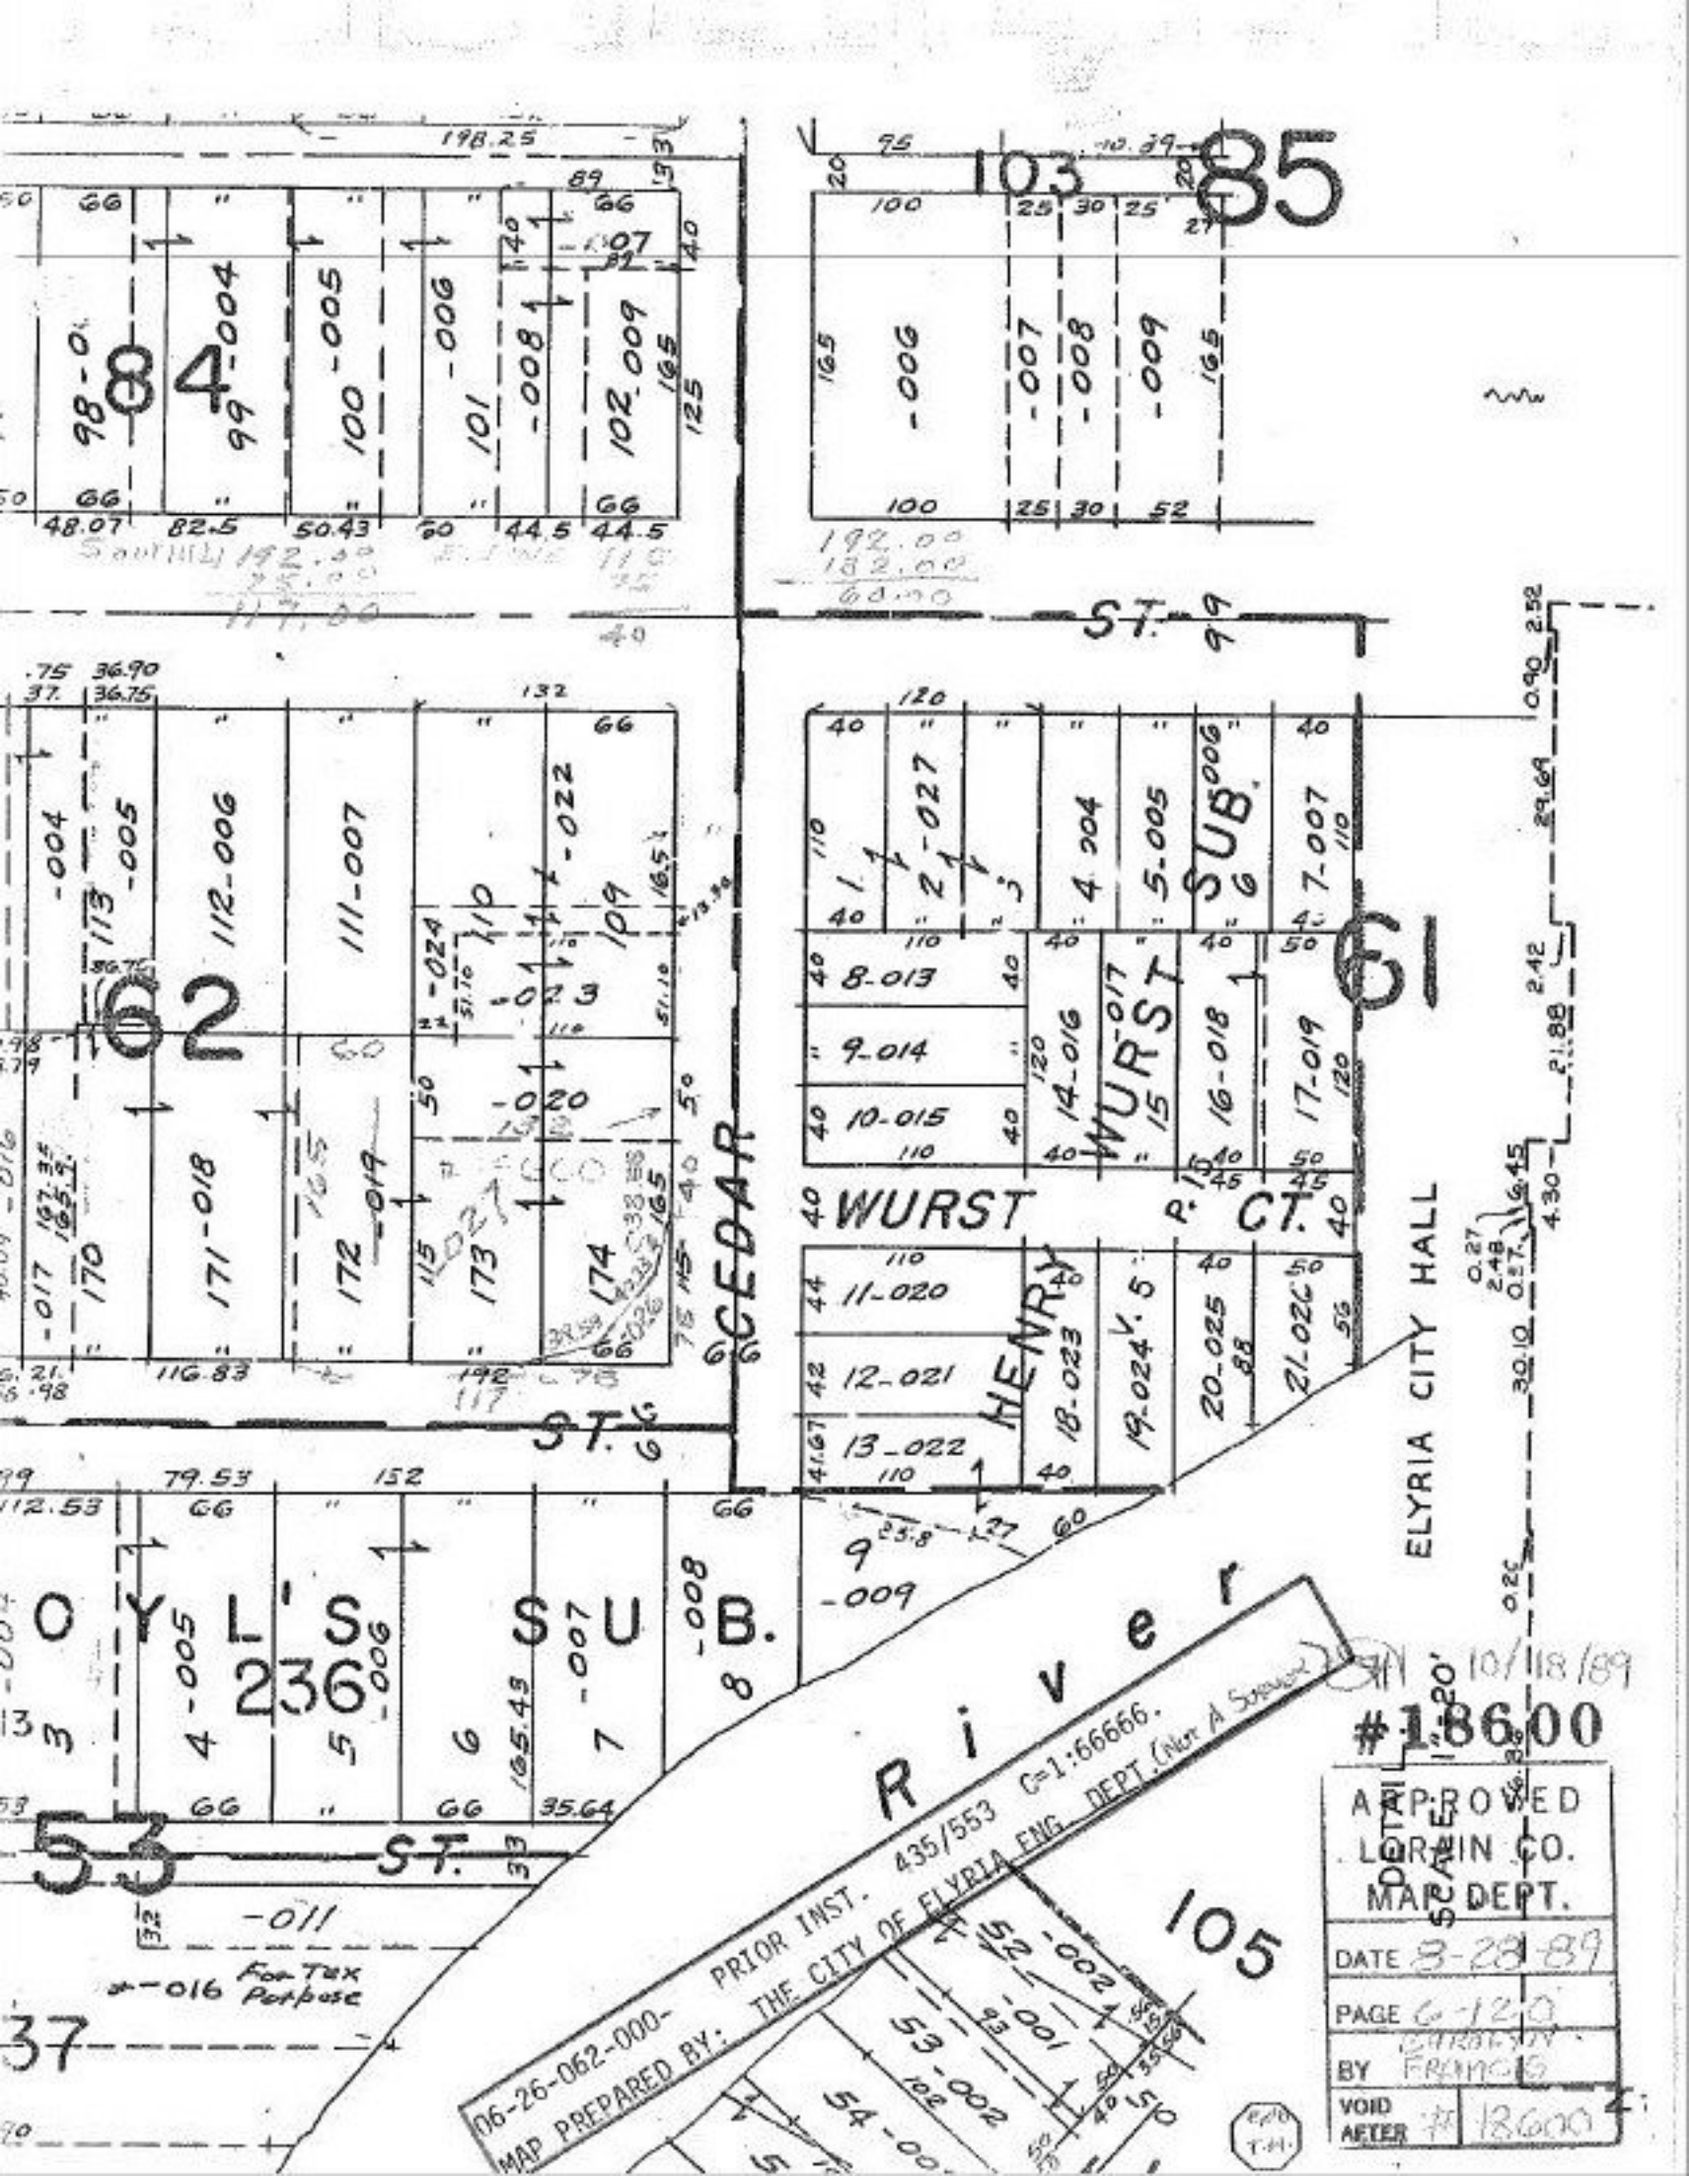

85
103
84
62
61
53
236
105
CEDAR
ST.
WURST CT.
WURST SUB.
HENRY
ELYRIA CITY HALL
OYL'S SUB.
River
For Tax Purpose
06-26-062-000- PRIOR INST. 435/553 C=1:66666.
MAP PREPARED BY: THE CITY OF ELYRIA ENG. DEPT. (Not A Survey)
10/18/89
#18600
APPROVED
LORAIN CO.
MAP DEPT.
DATE 8-28-89
PAGE 6-120
BY
VOID AFTER #18600