THE ℄ OF MILLS IS 7.5' NORTH OF N. LINE OF O.L. 30
WHICH IS ALSO THE RIDGEVILLE / AVON DIVIDING LINE
REFERENCE 1. ROAD RECORD 3 PG. 310 2. FIELD BOOK 192
IN 1934 & OLD SURVEY BY RAY E. HOLLIS

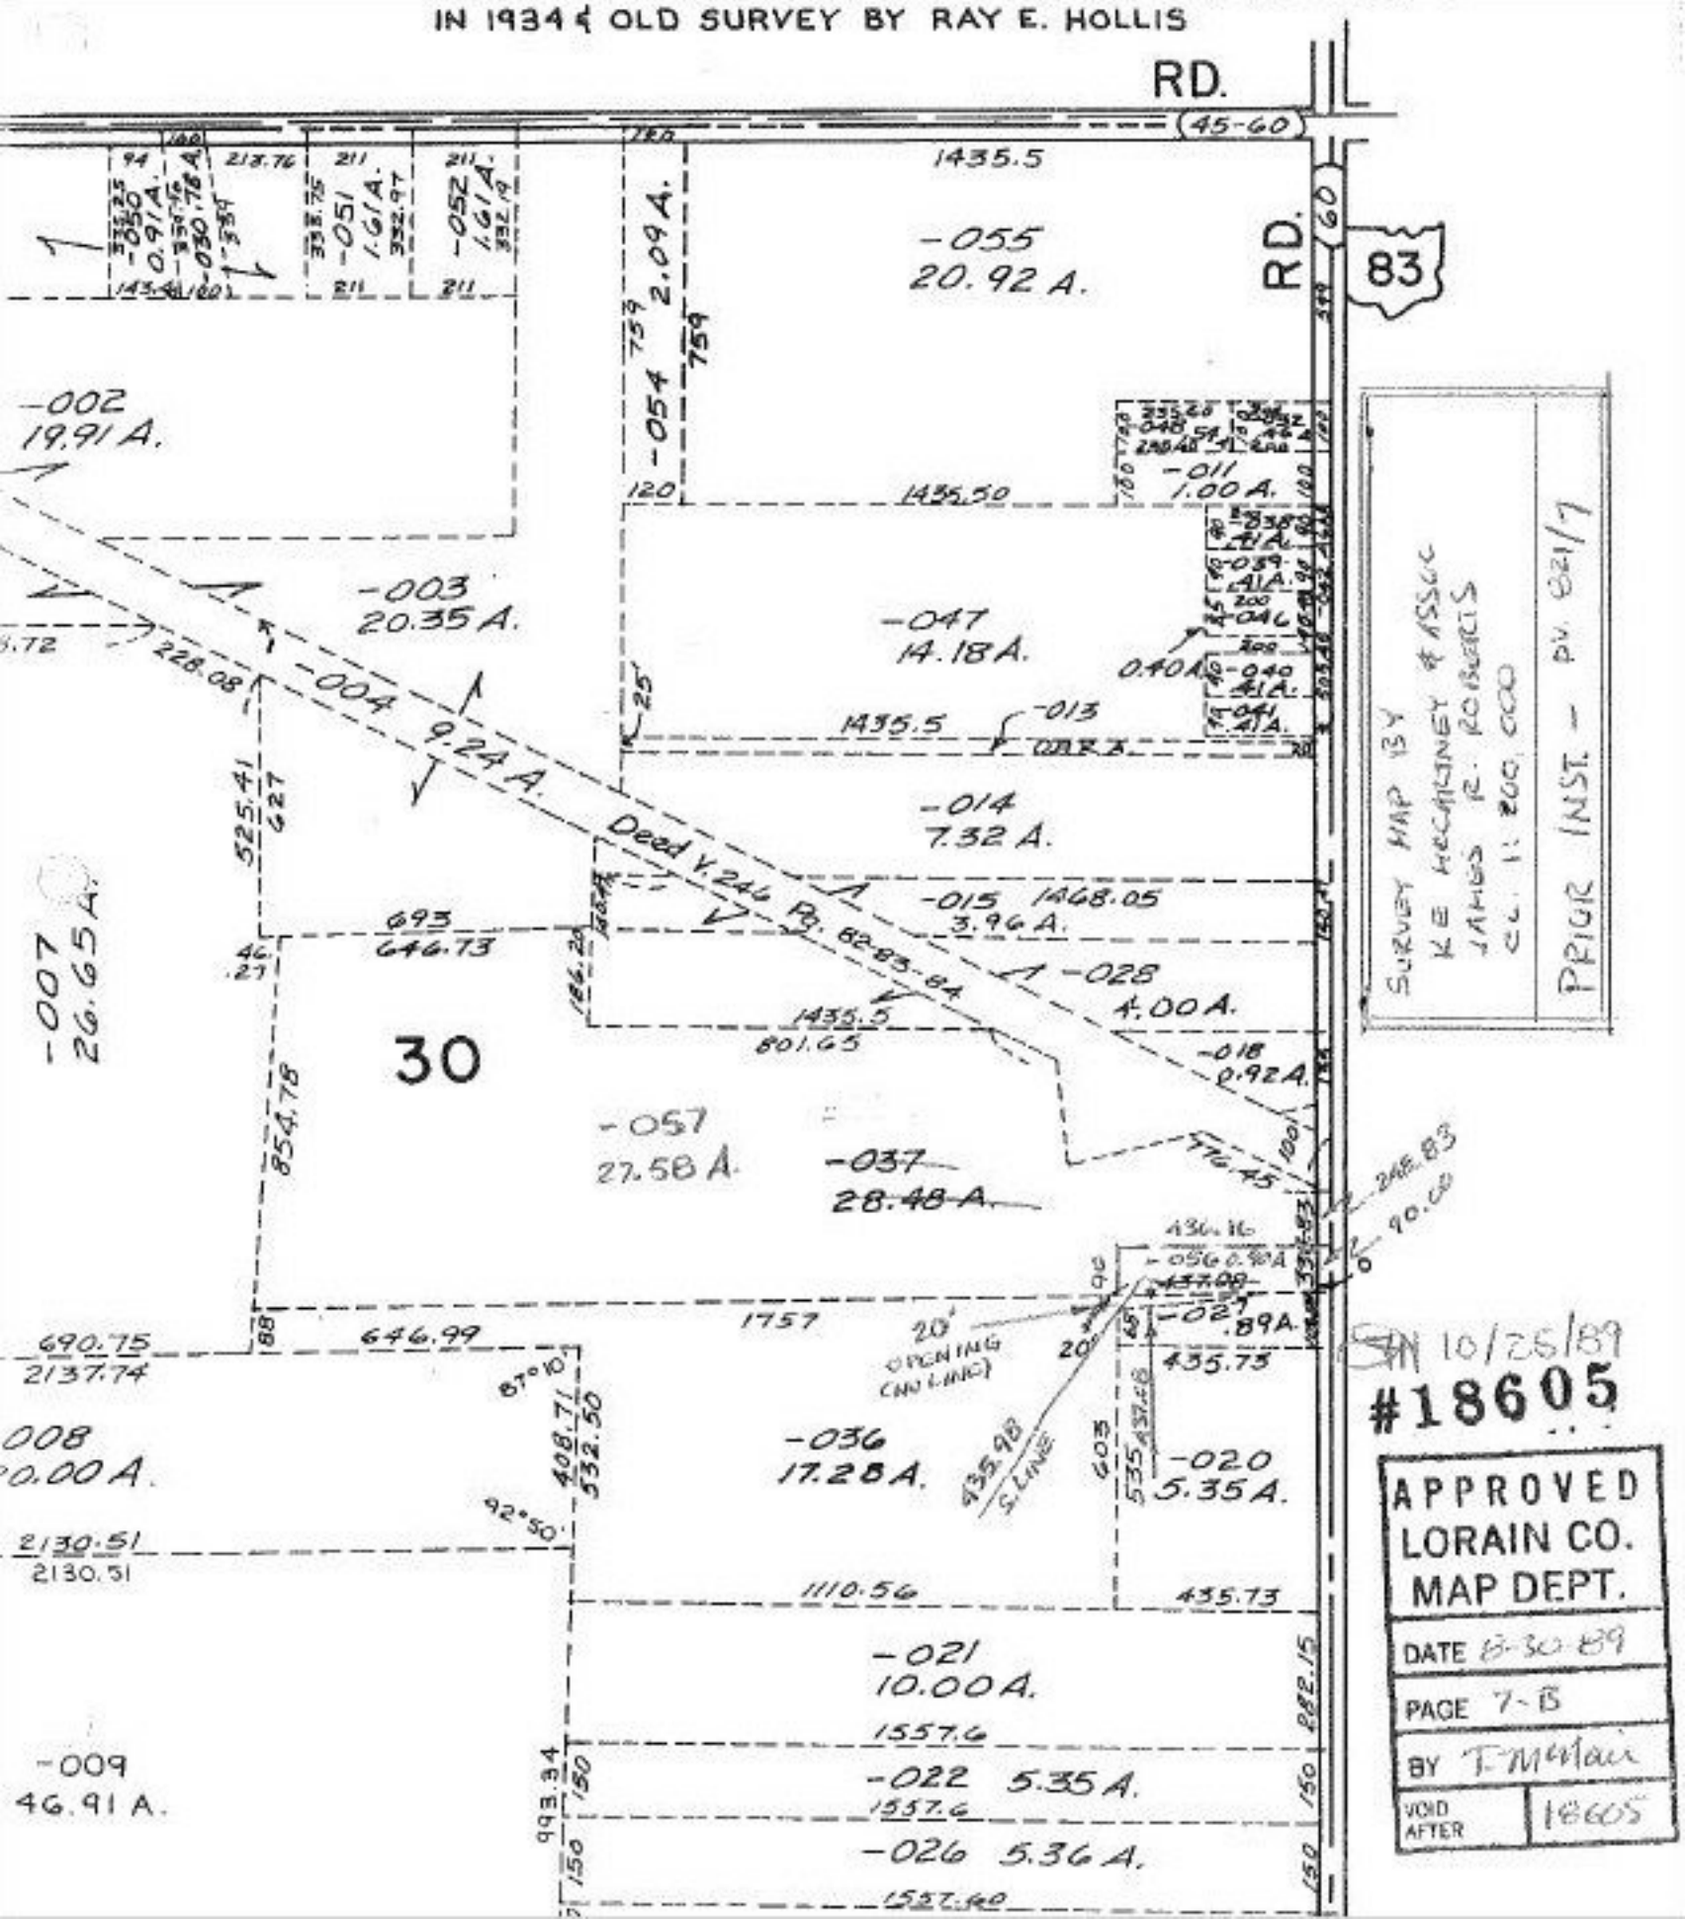

10/25/89
#18605

APPROVED
LORAIN CO.
MAP DEPT.
DATE 10-30-89
PAGE 7-B
BY T. McMain
VOID AFTER 18605