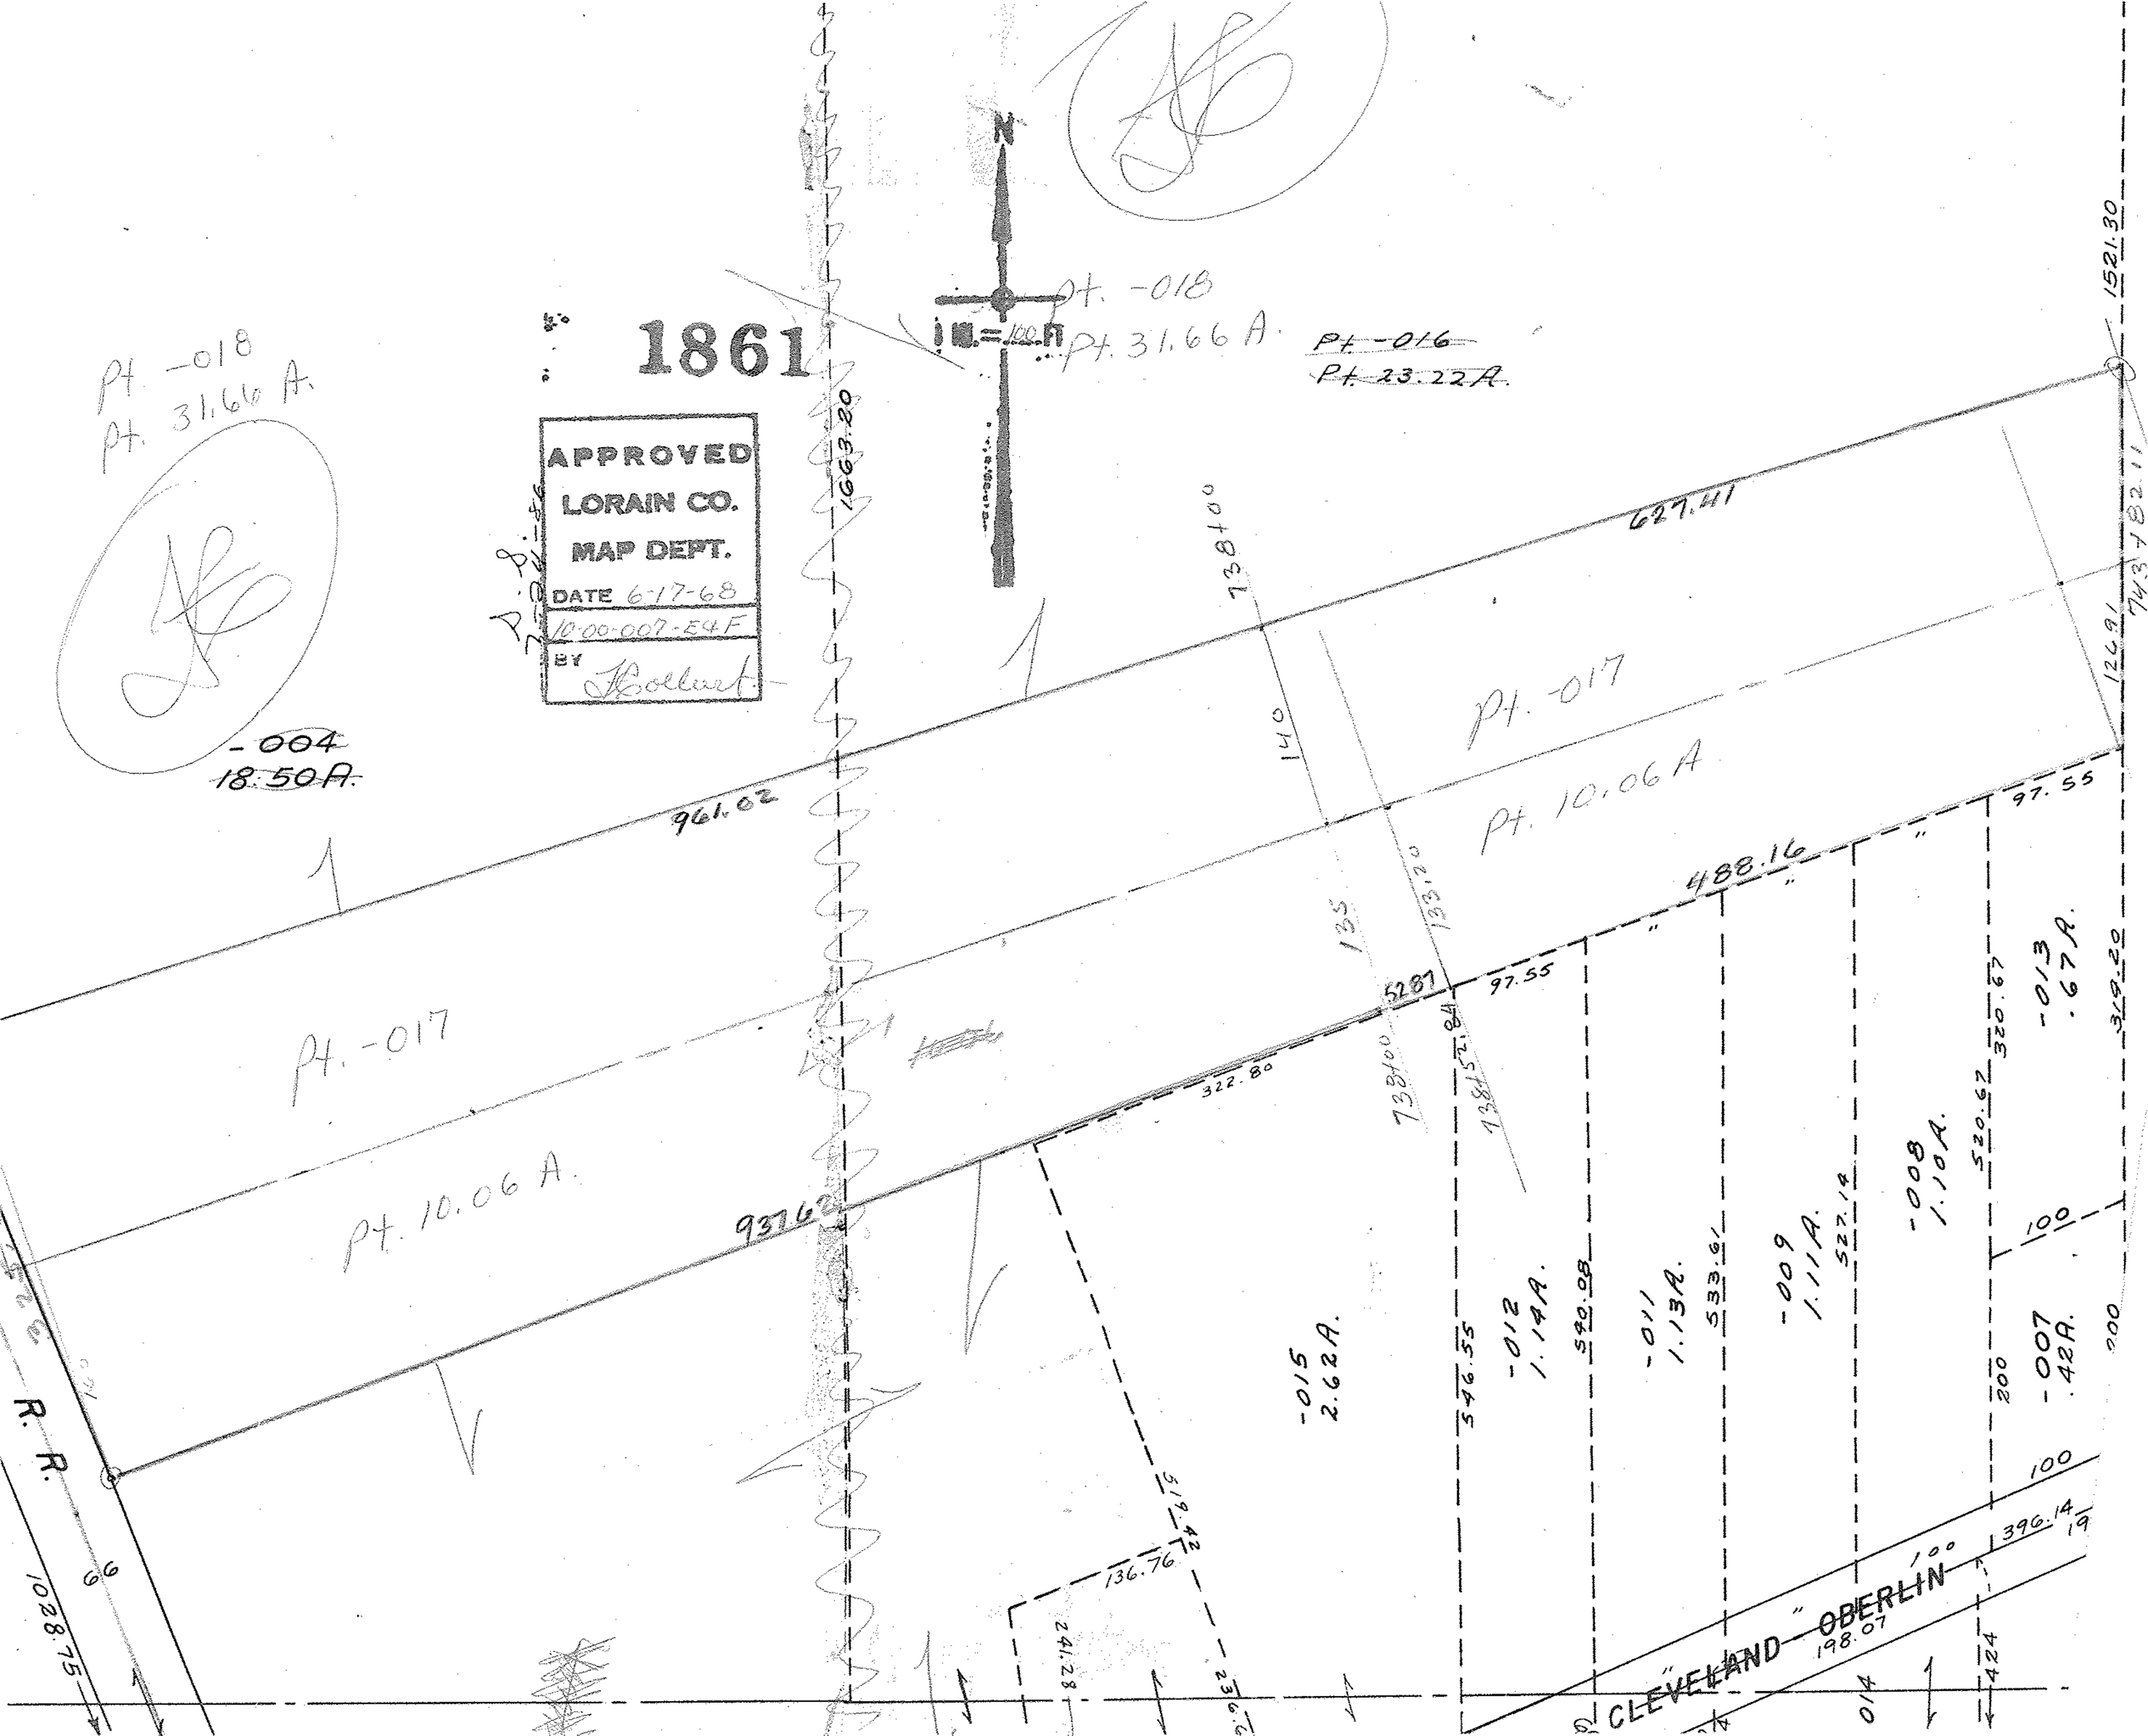

1861
APPROVED
LORAIN CO.
MAP DEPT.
DATE 6-17-68
10-00-007-E4F
BY
N
1 IN. = 100 FT.
Pt. -018
Pt. 31.66 A.
Pt. -016
Pt. 23.22 A.
Pt. -018
Pt. 31.66 A.
-004
18.50 A.
Pt. -017
Pt. 10.06 A.
Pt. -017
Pt. 10.06 A.
1663.20
627.41
961.02
937.62
488.16
97.55
97.55
322.80
1521.30
743+82.11
126.91
-013
.67 A.
-008
1.10 A.
-009
1.11 A.
-011
1.13 A.
-012
1.14 A.
-015
2.62 A.
-007
.42 A.
R. R.
1028.75
66
CLEVELAND - OBERLIN
198.07
396.14
136.76
241.28
519.42
546.55
540.08
533.61
527.14
520.67
320.67
319.20
100
200
424