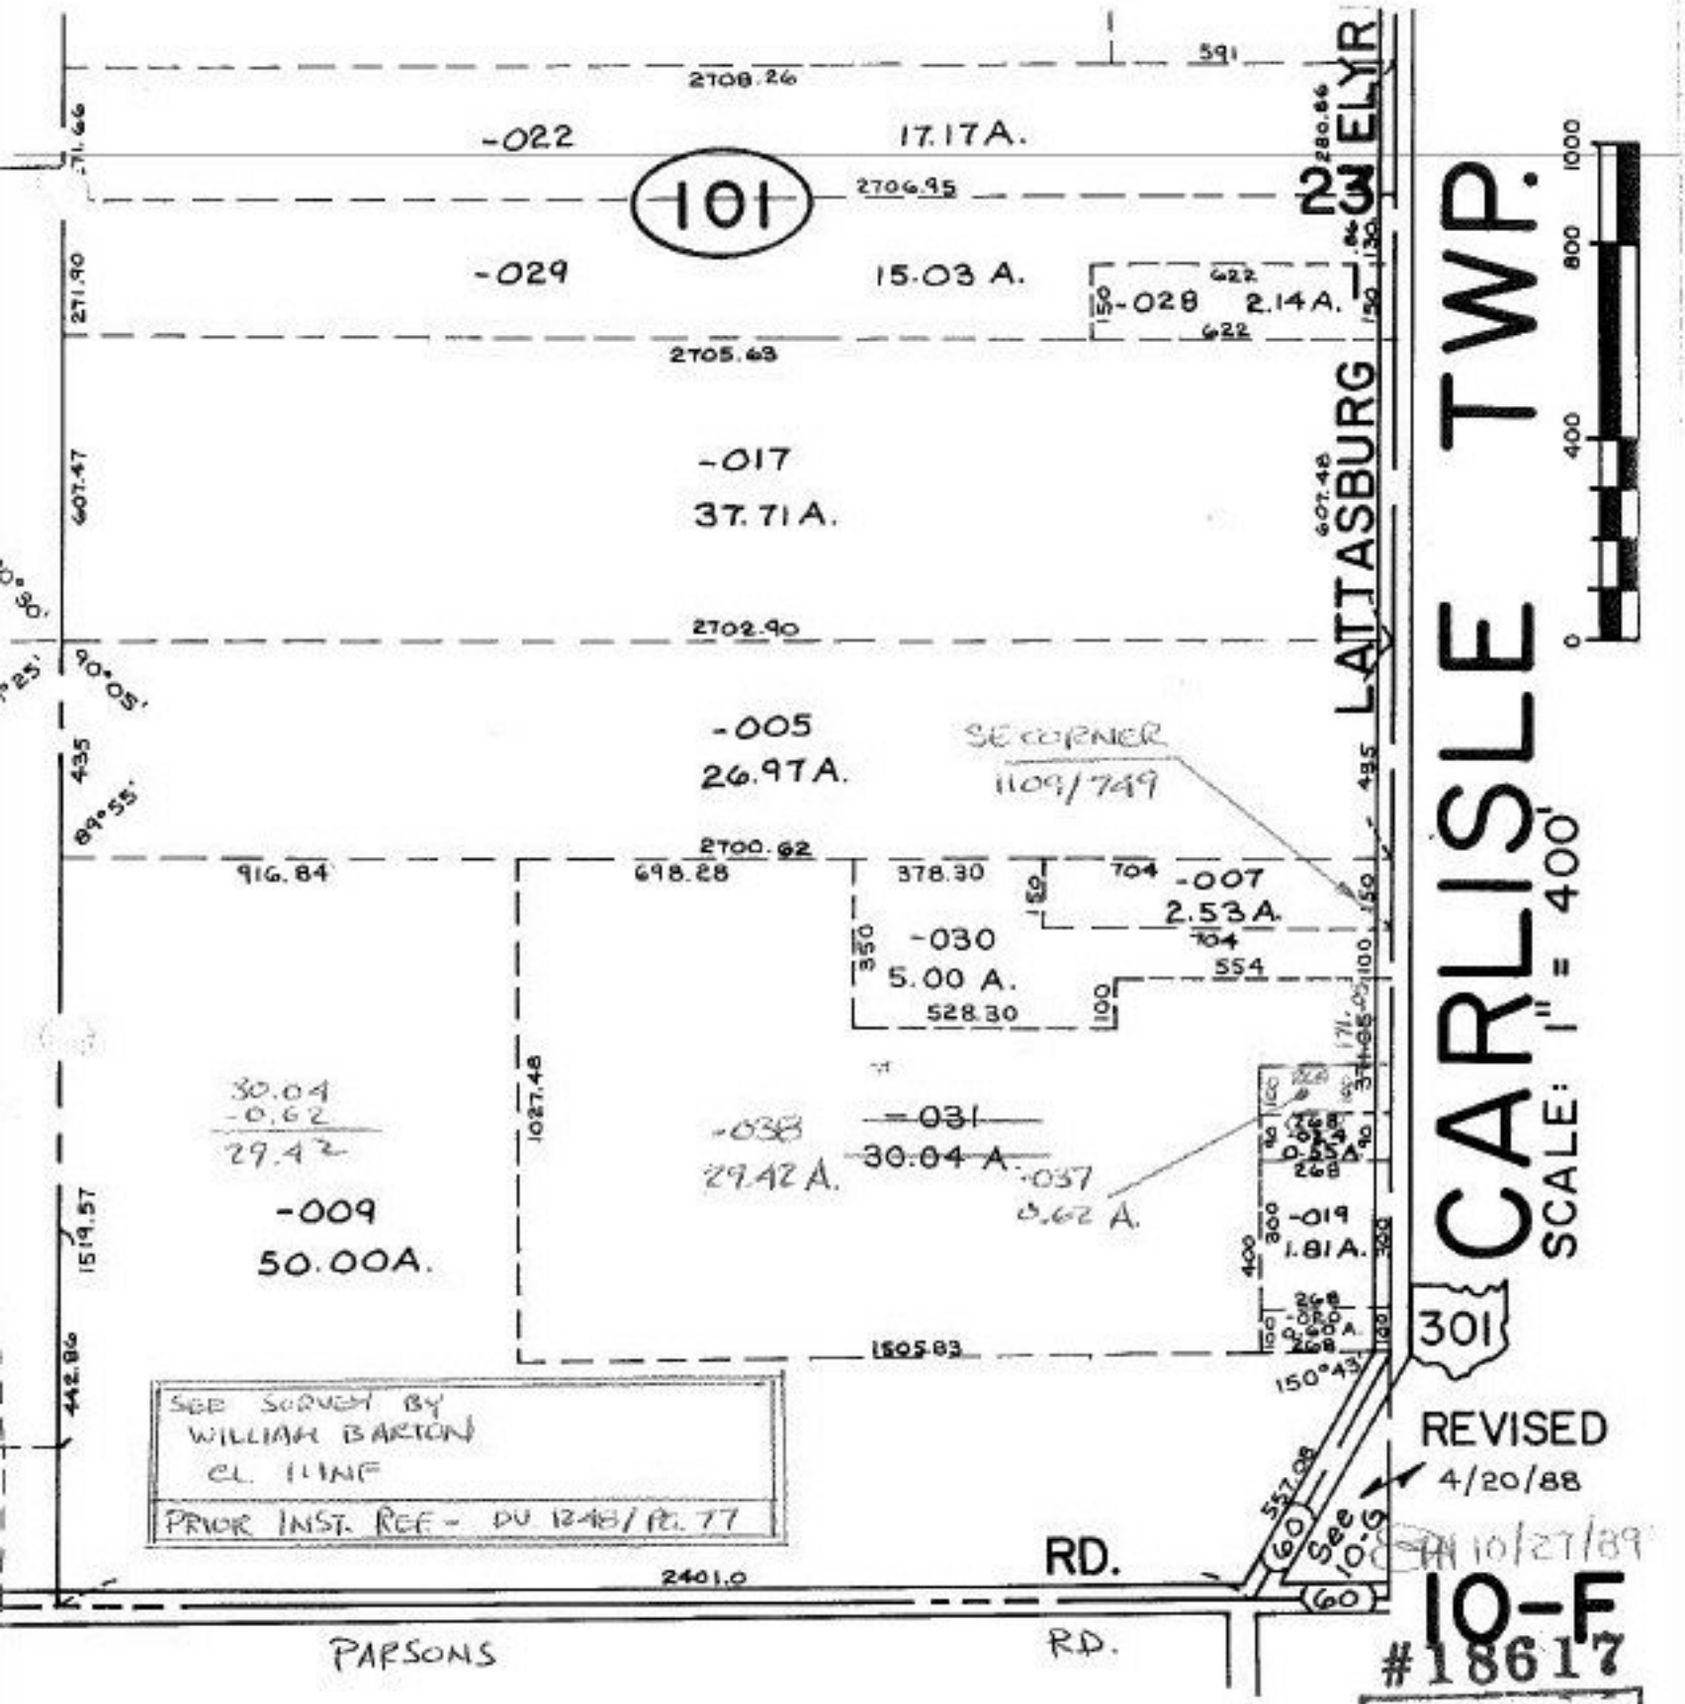

10-F

#18617

APPROVED
LORAIN CO.
MAP DEPT.

DATE 9-8-89

PAGE 10-F

BY T. McNair

VOID AFTER 18617