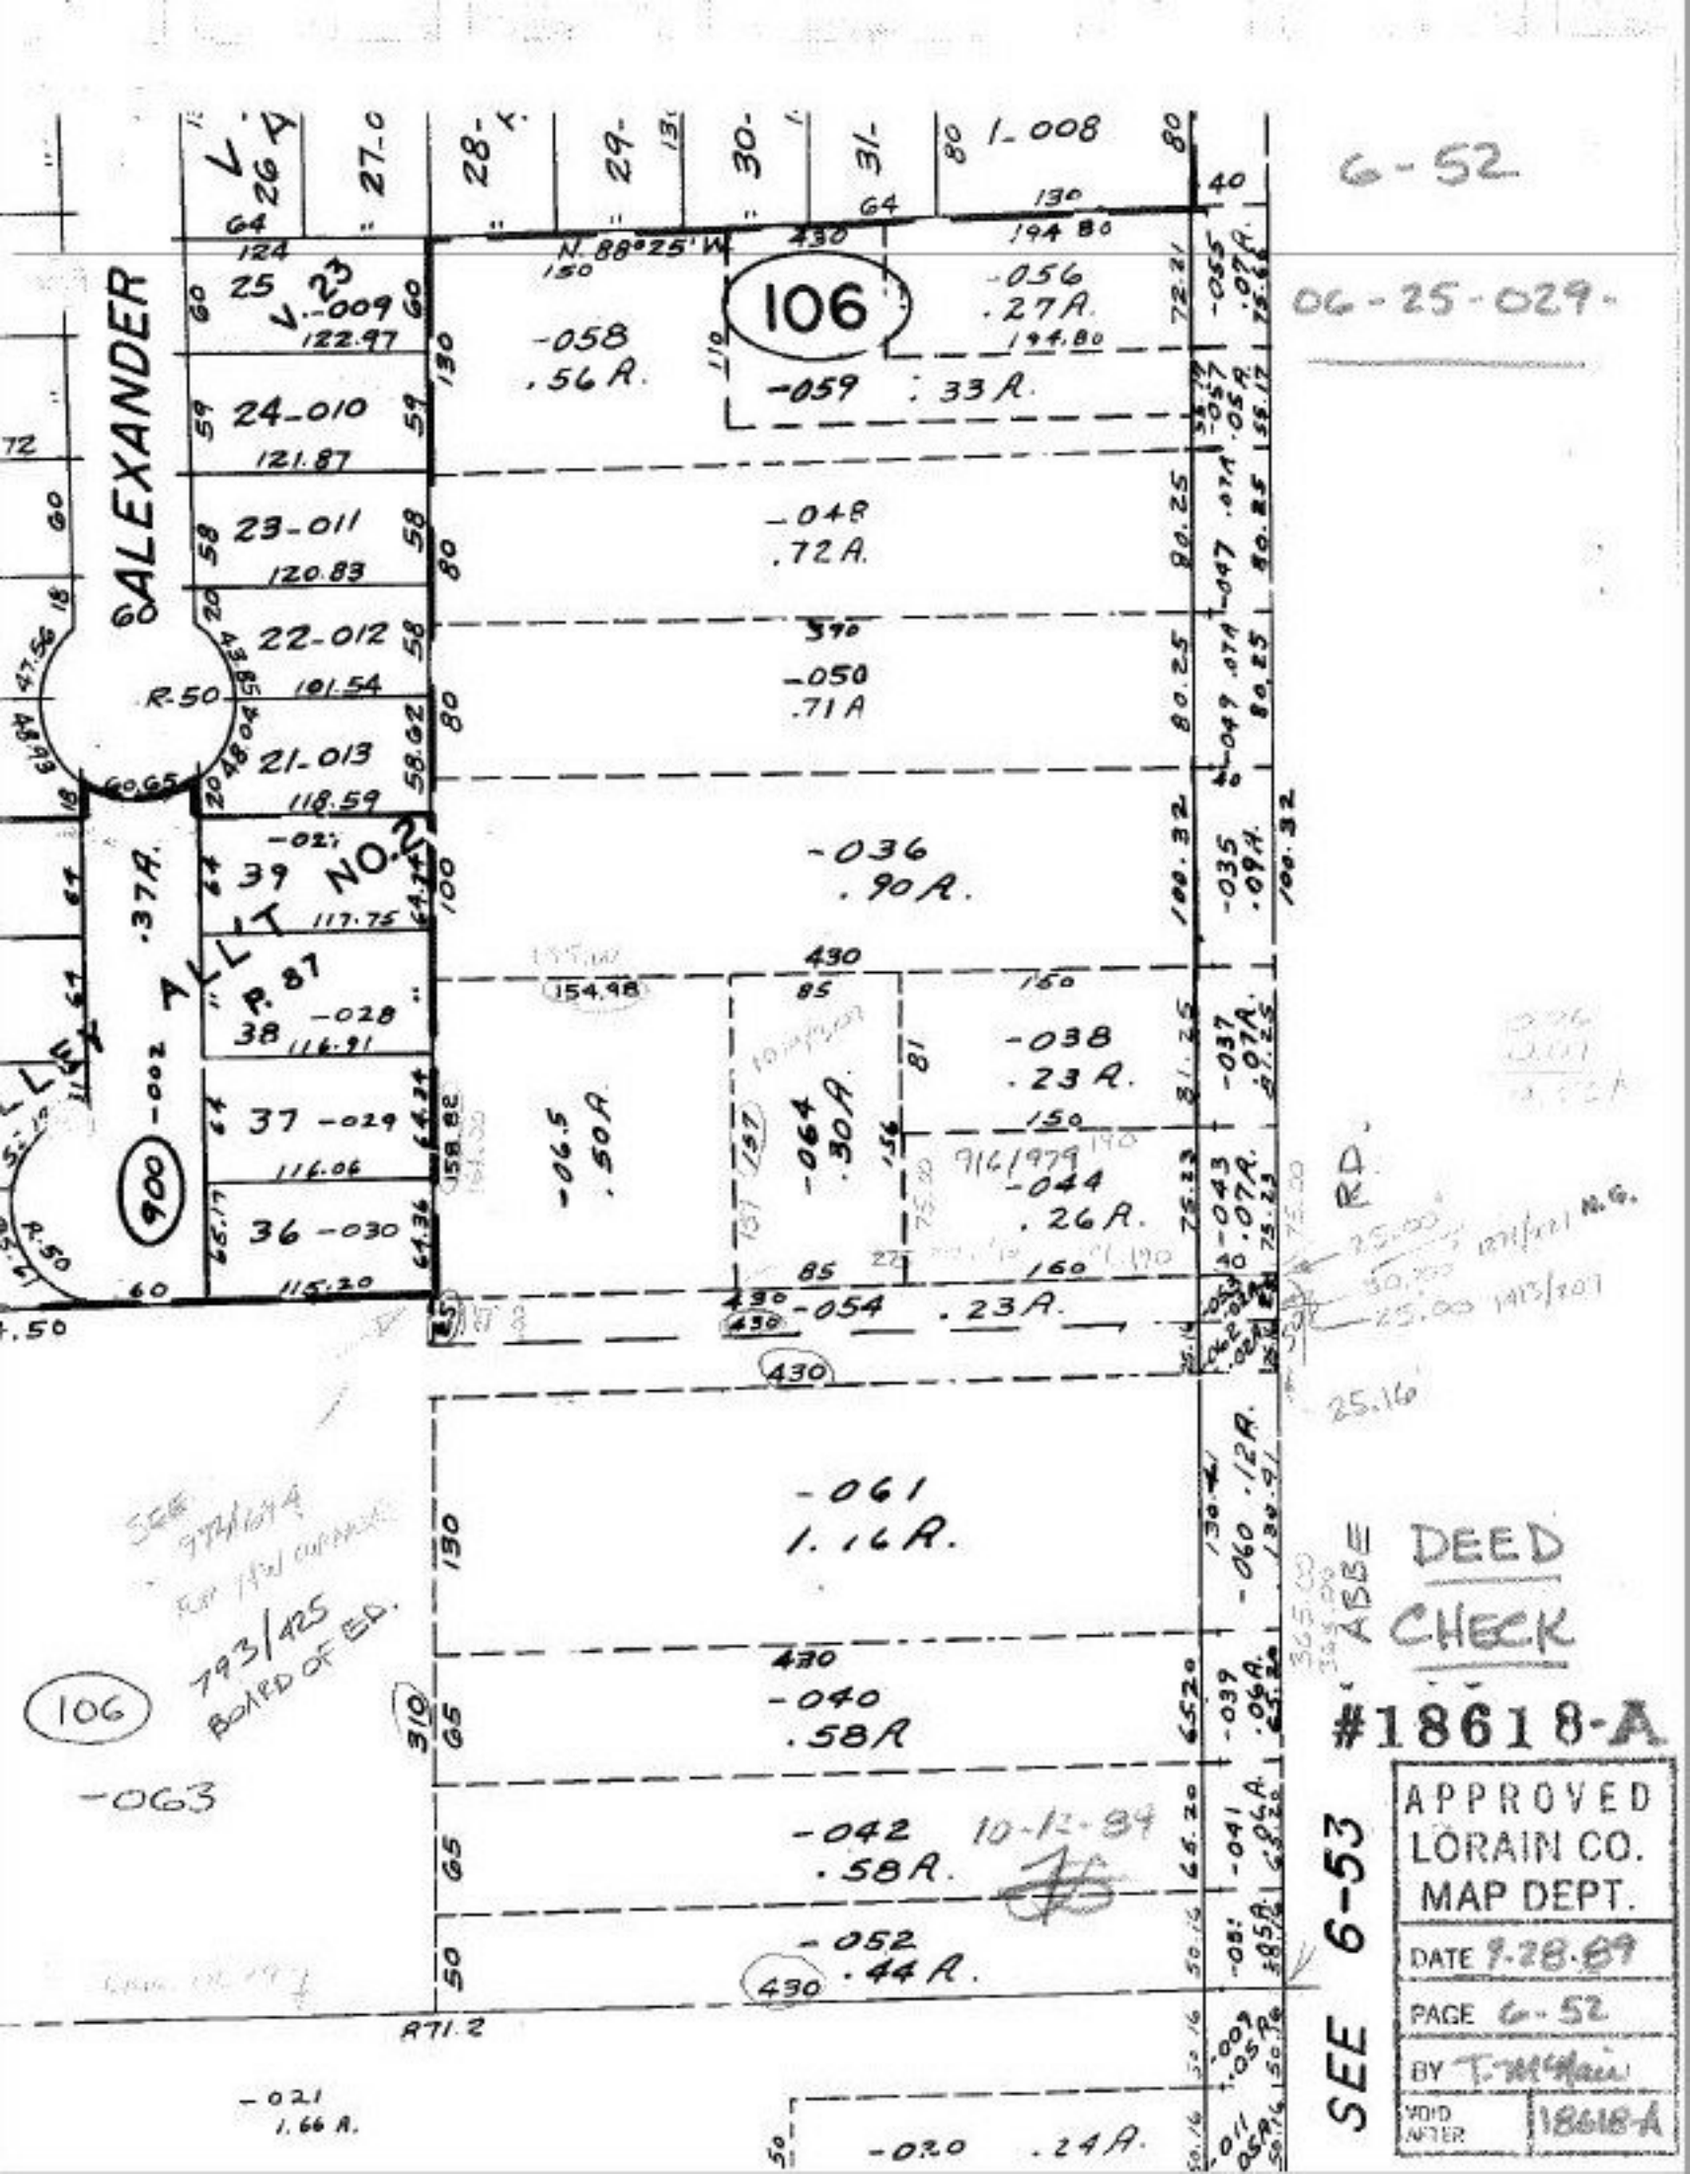
6-52
06-25-029
ALEXANDER
106
-058
.56 A.
-056
.27 A.
-059
.33 A.
-048
.72 A.
-050
.71 A
-036
.90 A.
-038
.23 A.
-044
.26 A.
-054
.23 A.
-061
1.16 A.
-040
.58 A
-042
.58 A.
-052
.44 A.
-020
.24 A.
-063
-021
1.66 A.
SEE 6-53
DEED CHECK
#18618-A
APPROVED
LORAIN CO.
MAP DEPT.
DATE 9-28-89
PAGE 6-52
BY T. McNair
VOID AFTER 18618-A