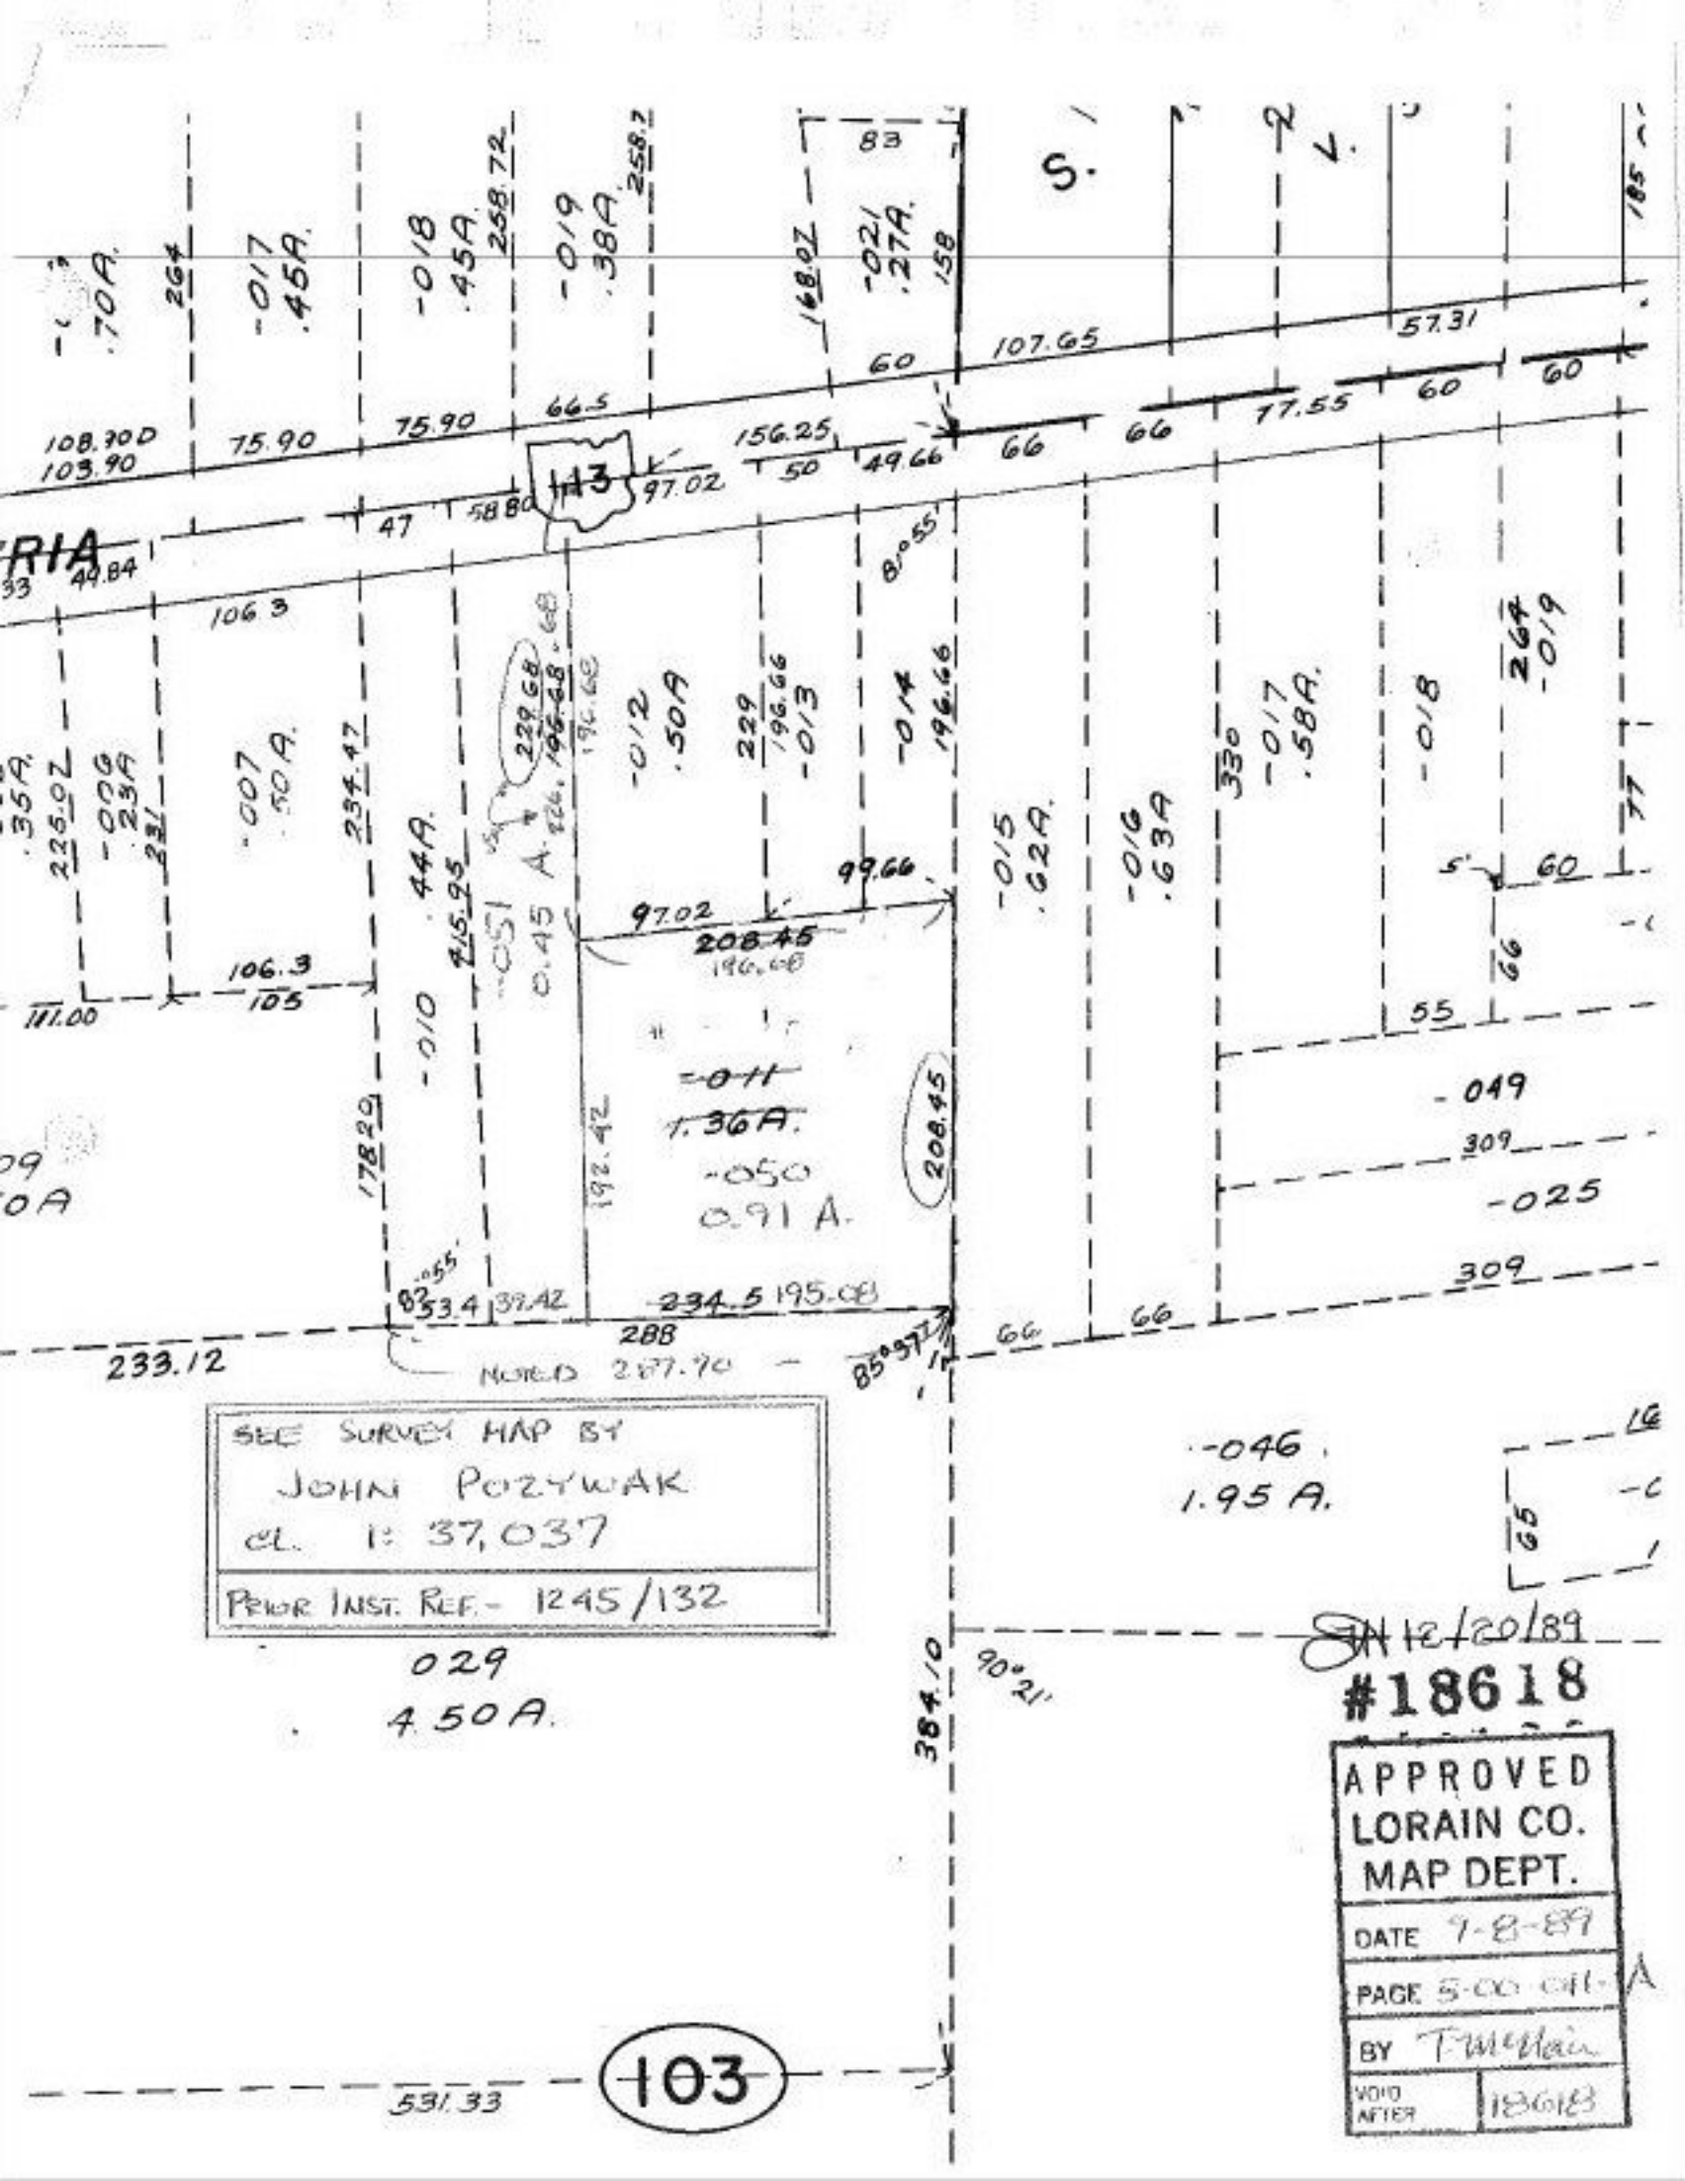
-017 .45A.
-018 .45A.
258.72
-019 .38A.
258.2
-021 .27A.
168.02
158
S.
57.31
107.65
60
108.900
103.90
75.90
75.90
66.5
156.25
50
49.66
66
66
77.55
60
60
97.02
47
58.80
113
40.84
106.3
-007 .50A.
234.47
-010 .44A.
215.95
-012 .50A.
229
196.66
-013
-014
196.66
8.055
99.66
97.02
208.45
196.66
-015 .62A.
-016 .63A.
330
-017 .58A.
-018
264
-019
5'
60
55
66
106.3
105
111.00
178.20
192.42
-011
1.36A.
-050
0.91 A.
208.45
-049
309
-025
309
82.055
53.4
39.42
234.5 195.08
288
233.12
NORTH 287.70
85°37'
66
66
SEE SURVEY MAP BY
JOHN POZYWAK
EL. 1: 37,037
PRIOR INST. REF. - 1245/132
029
4.50A.
-046
1.95 A.
384.10
90°21'
531.33
103
12/20/89
#18618
APPROVED
LORAIN CO.
MAP DEPT.
DATE 7-8-89
PAGE 5-00 all
BY T. McClain
VOID AFTER 180183