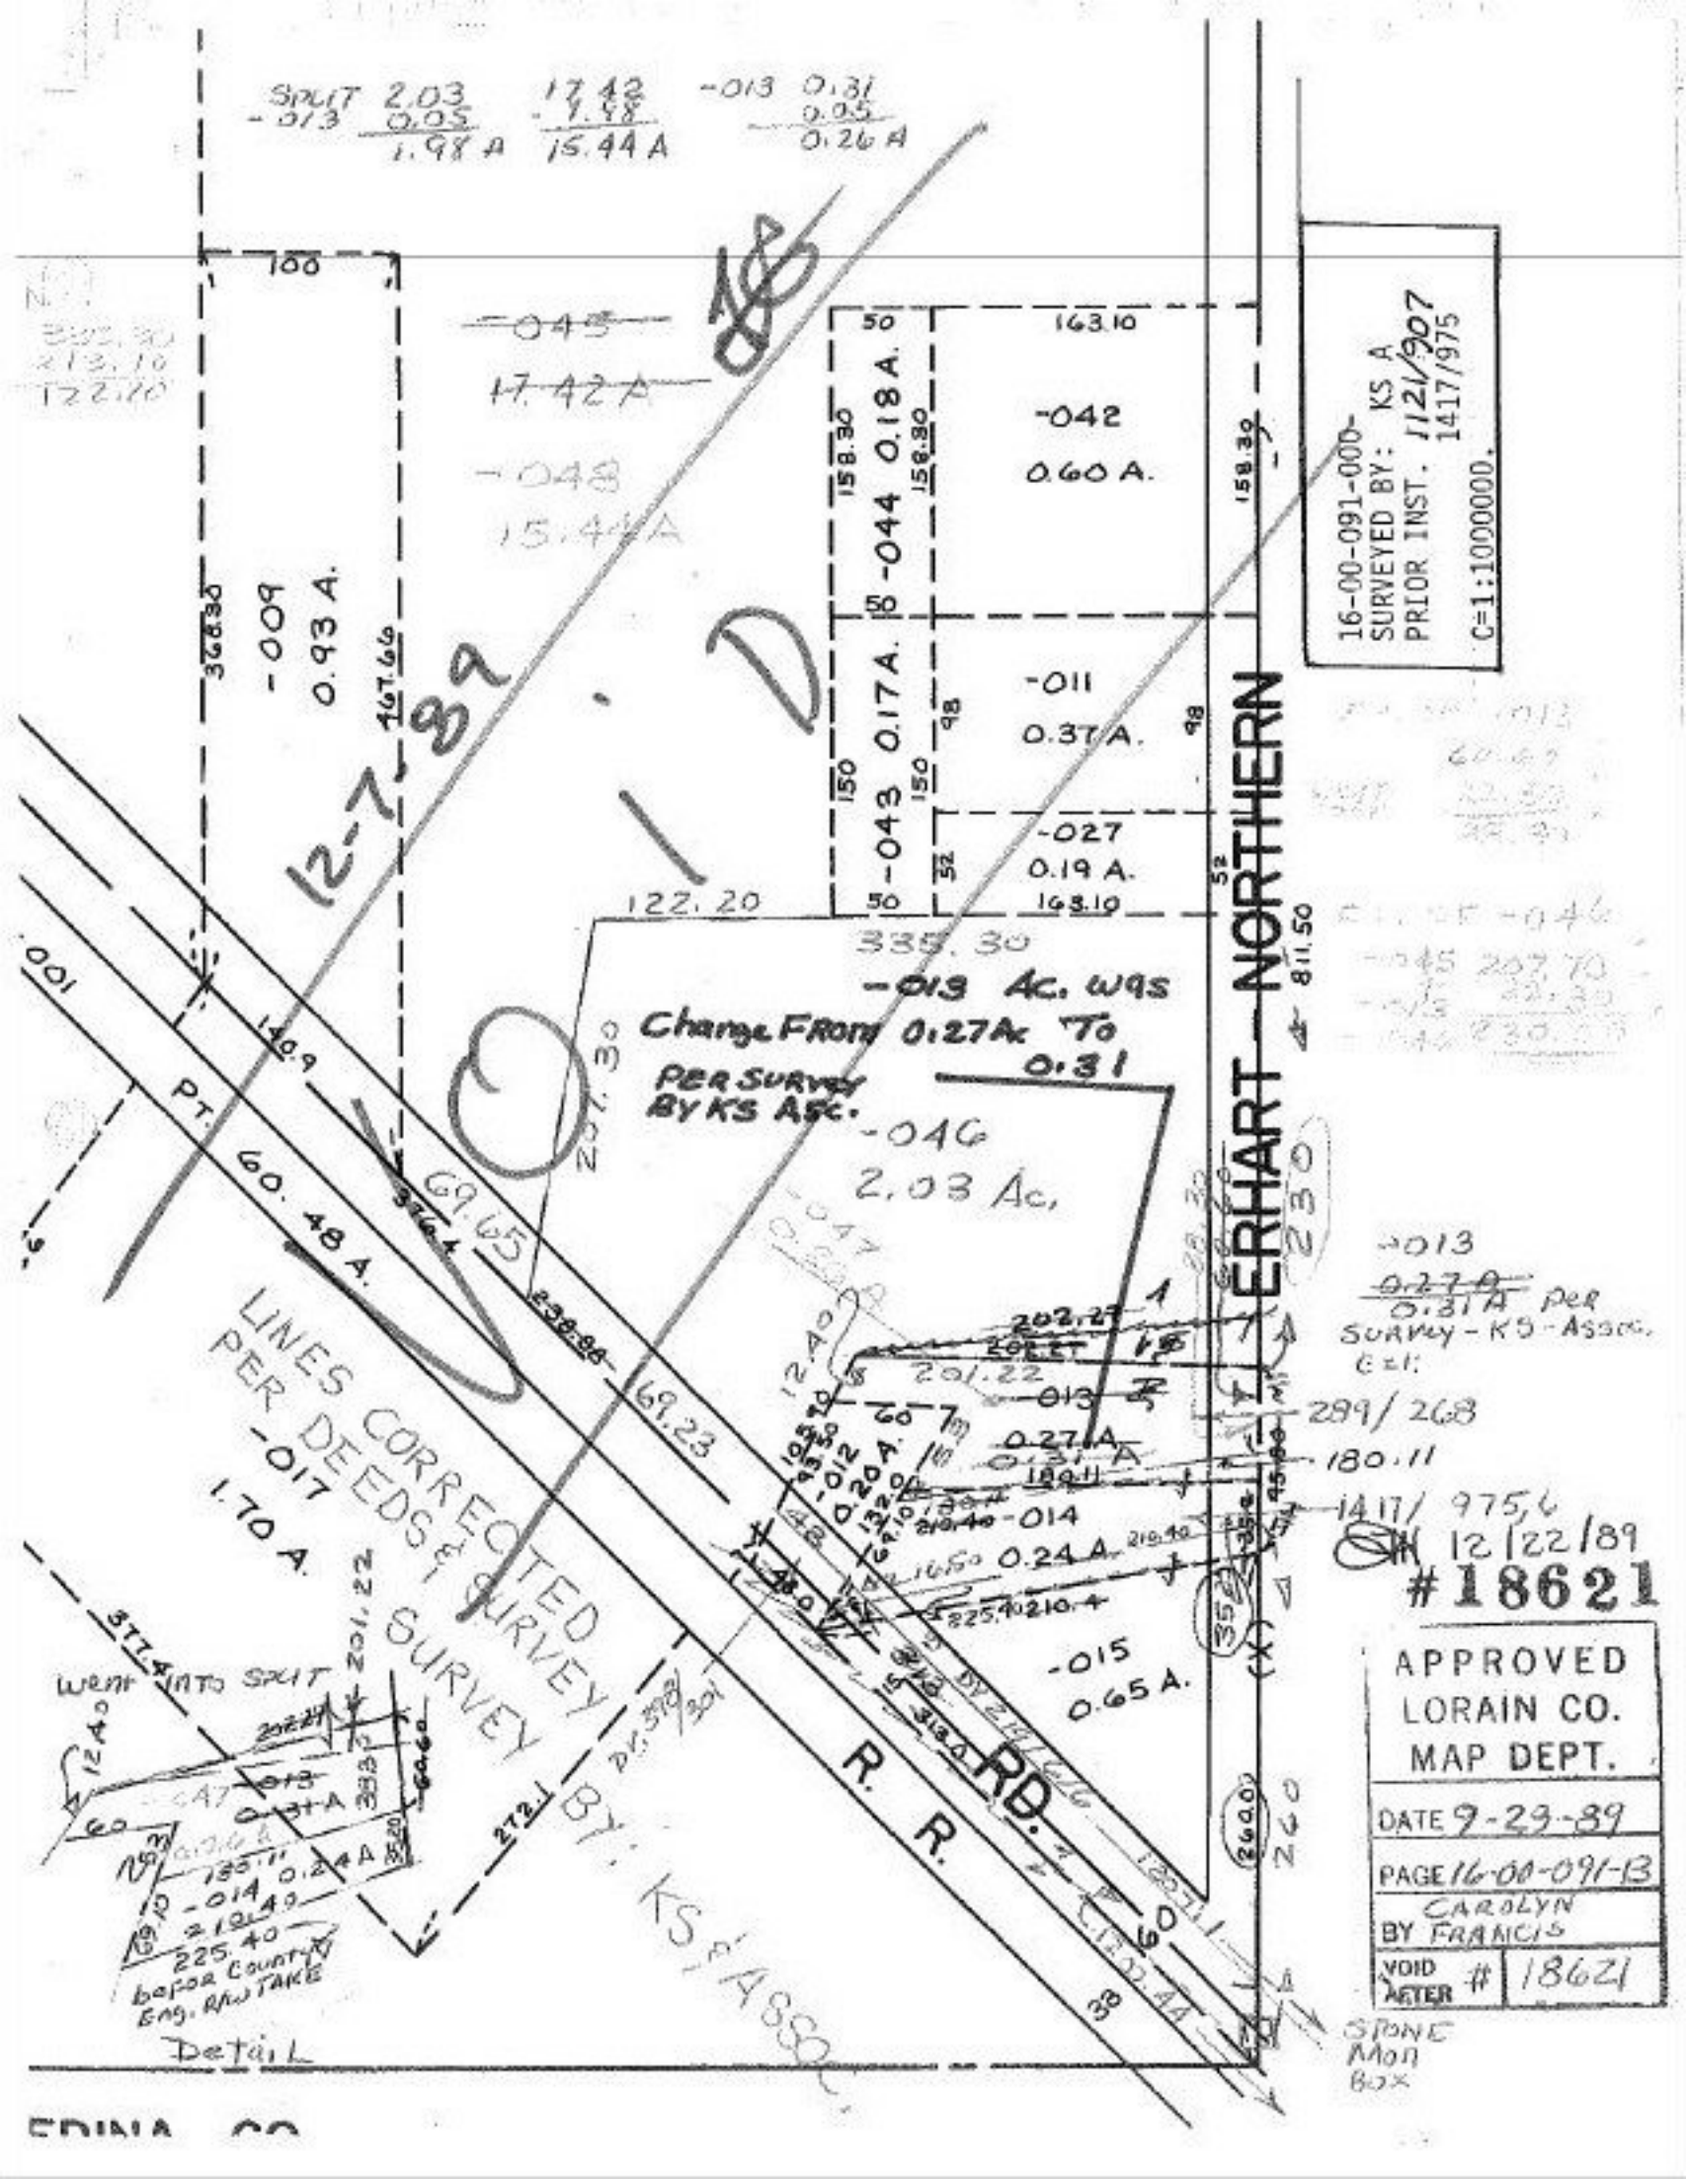

SPLIT 2.03
-013 0.05
1.98 A
17.42
-1.98
15.44 A
-013 0.31
0.05
0.26 A
16-00-091-000-
SURVEYED BY: KS A
PRIOR INST. 1121/907
1417/975
C=1:1000000.
-045
17.42 A
-048
15.44 A
-009
0.93 A.
-044 0.18 A.
-042
0.60 A.
-043 0.17 A.
-011
0.37 A.
-027
0.19 A.
-013 Ac. was
Change From 0.27 Ac To
0.31
PER SURVEY
BY KS ASC.
-046
2.03 Ac.
PT. 60.48 A.
LINES CORRECTED
PER DEEDS & SURVEY
SURVEY BY: KS & ASSOC.
-017
1.70 A.
-012
0.20 A.
-014
0.24 A.
-015
0.65 A.
ERHART NORTHERN
R. R.
RD.
-013
0.27 A
0.31 A PER
SURVEY - KS - ASSOC.
C=1:
289/268
180.11
1417/975,6
12/22/89
#18621
APPROVED
LORAIN CO.
MAP DEPT.
DATE 9-29-89
PAGE 16-00-091-13
BY CAROLYN FRANCIS
VOID AFTER # 18621
went into split
before County Eng. R/W TAKE
Detail
STONE MON BOX
12-7-89
VOID