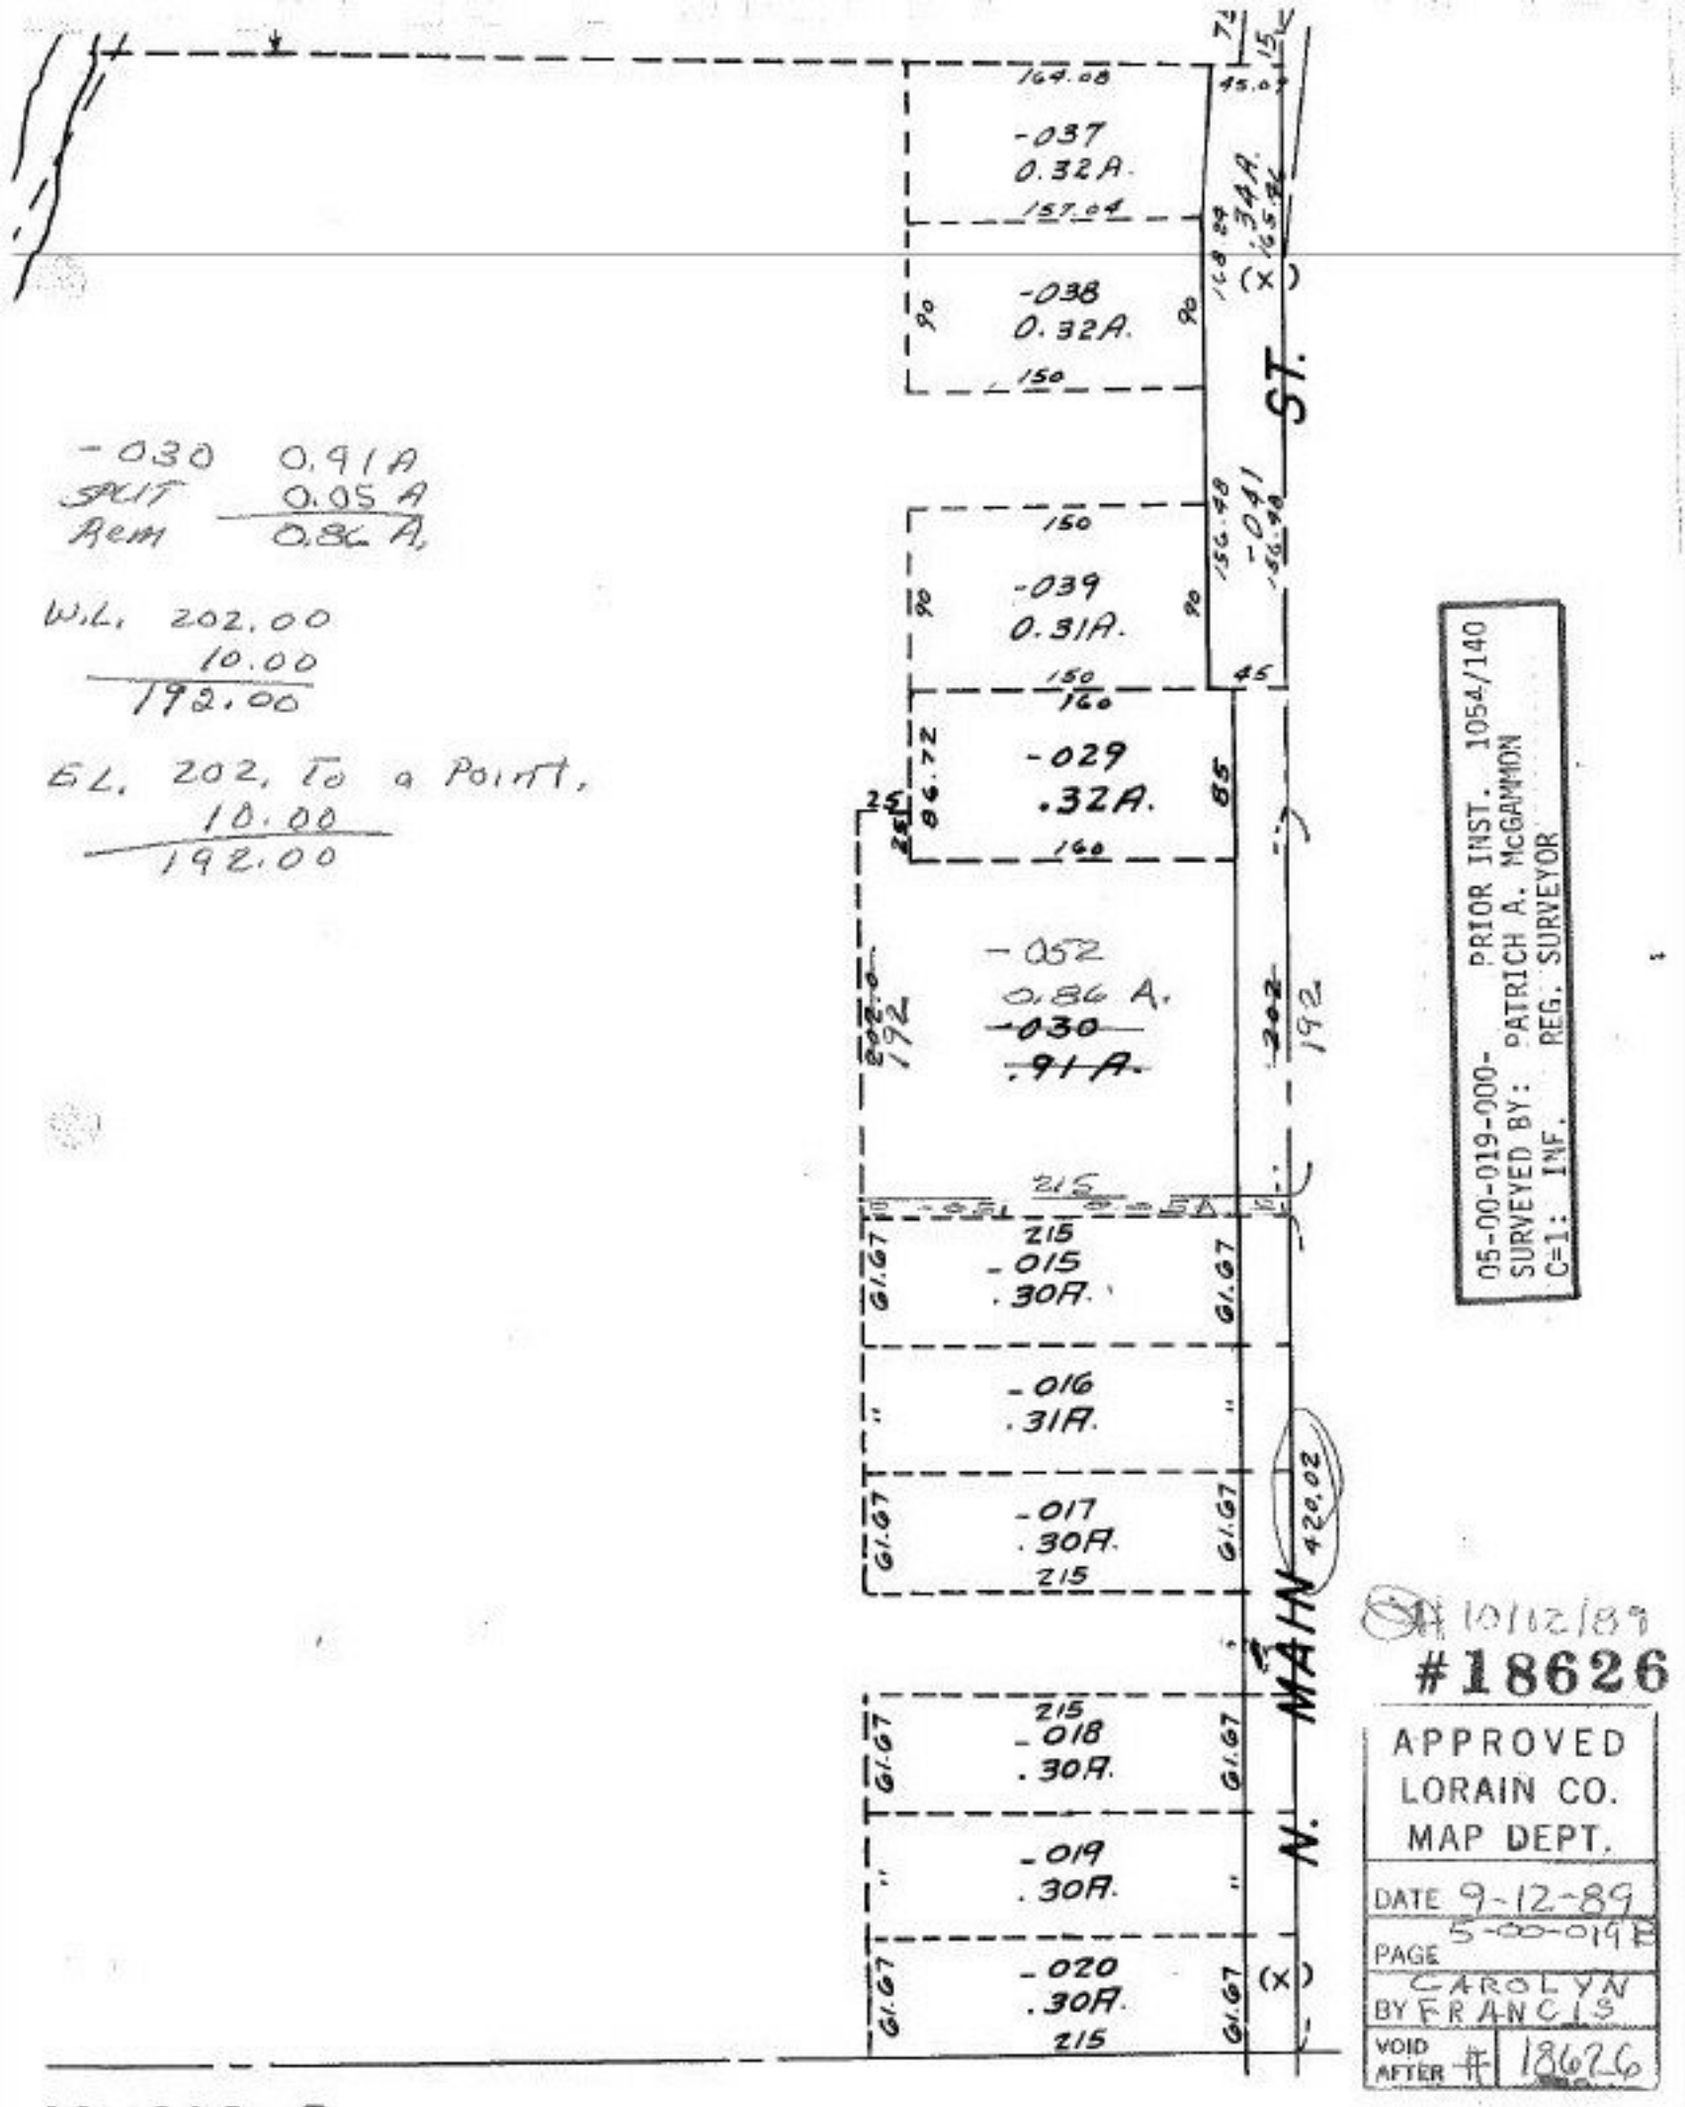

-030 0.91A
SPLIT 0.05 A
REM 0.86 A.

W.L. 202.00
10.00
192.00

S.L. 202, To a Point,
10.00
192.00

05-00-019-000- PRIOR INST. 1054/140
SURVEYED BY: PATRICH A. McGAMMON
C=1: INF. REG. SURVEYOR

10/12/89
#18626

APPROVED
LORAIN CO.
MAP DEPT.
DATE 9-12-89
PAGE 5-00-019
BY CAROLYN FRANCIS
VOID AFTER # 18626

00-018-B