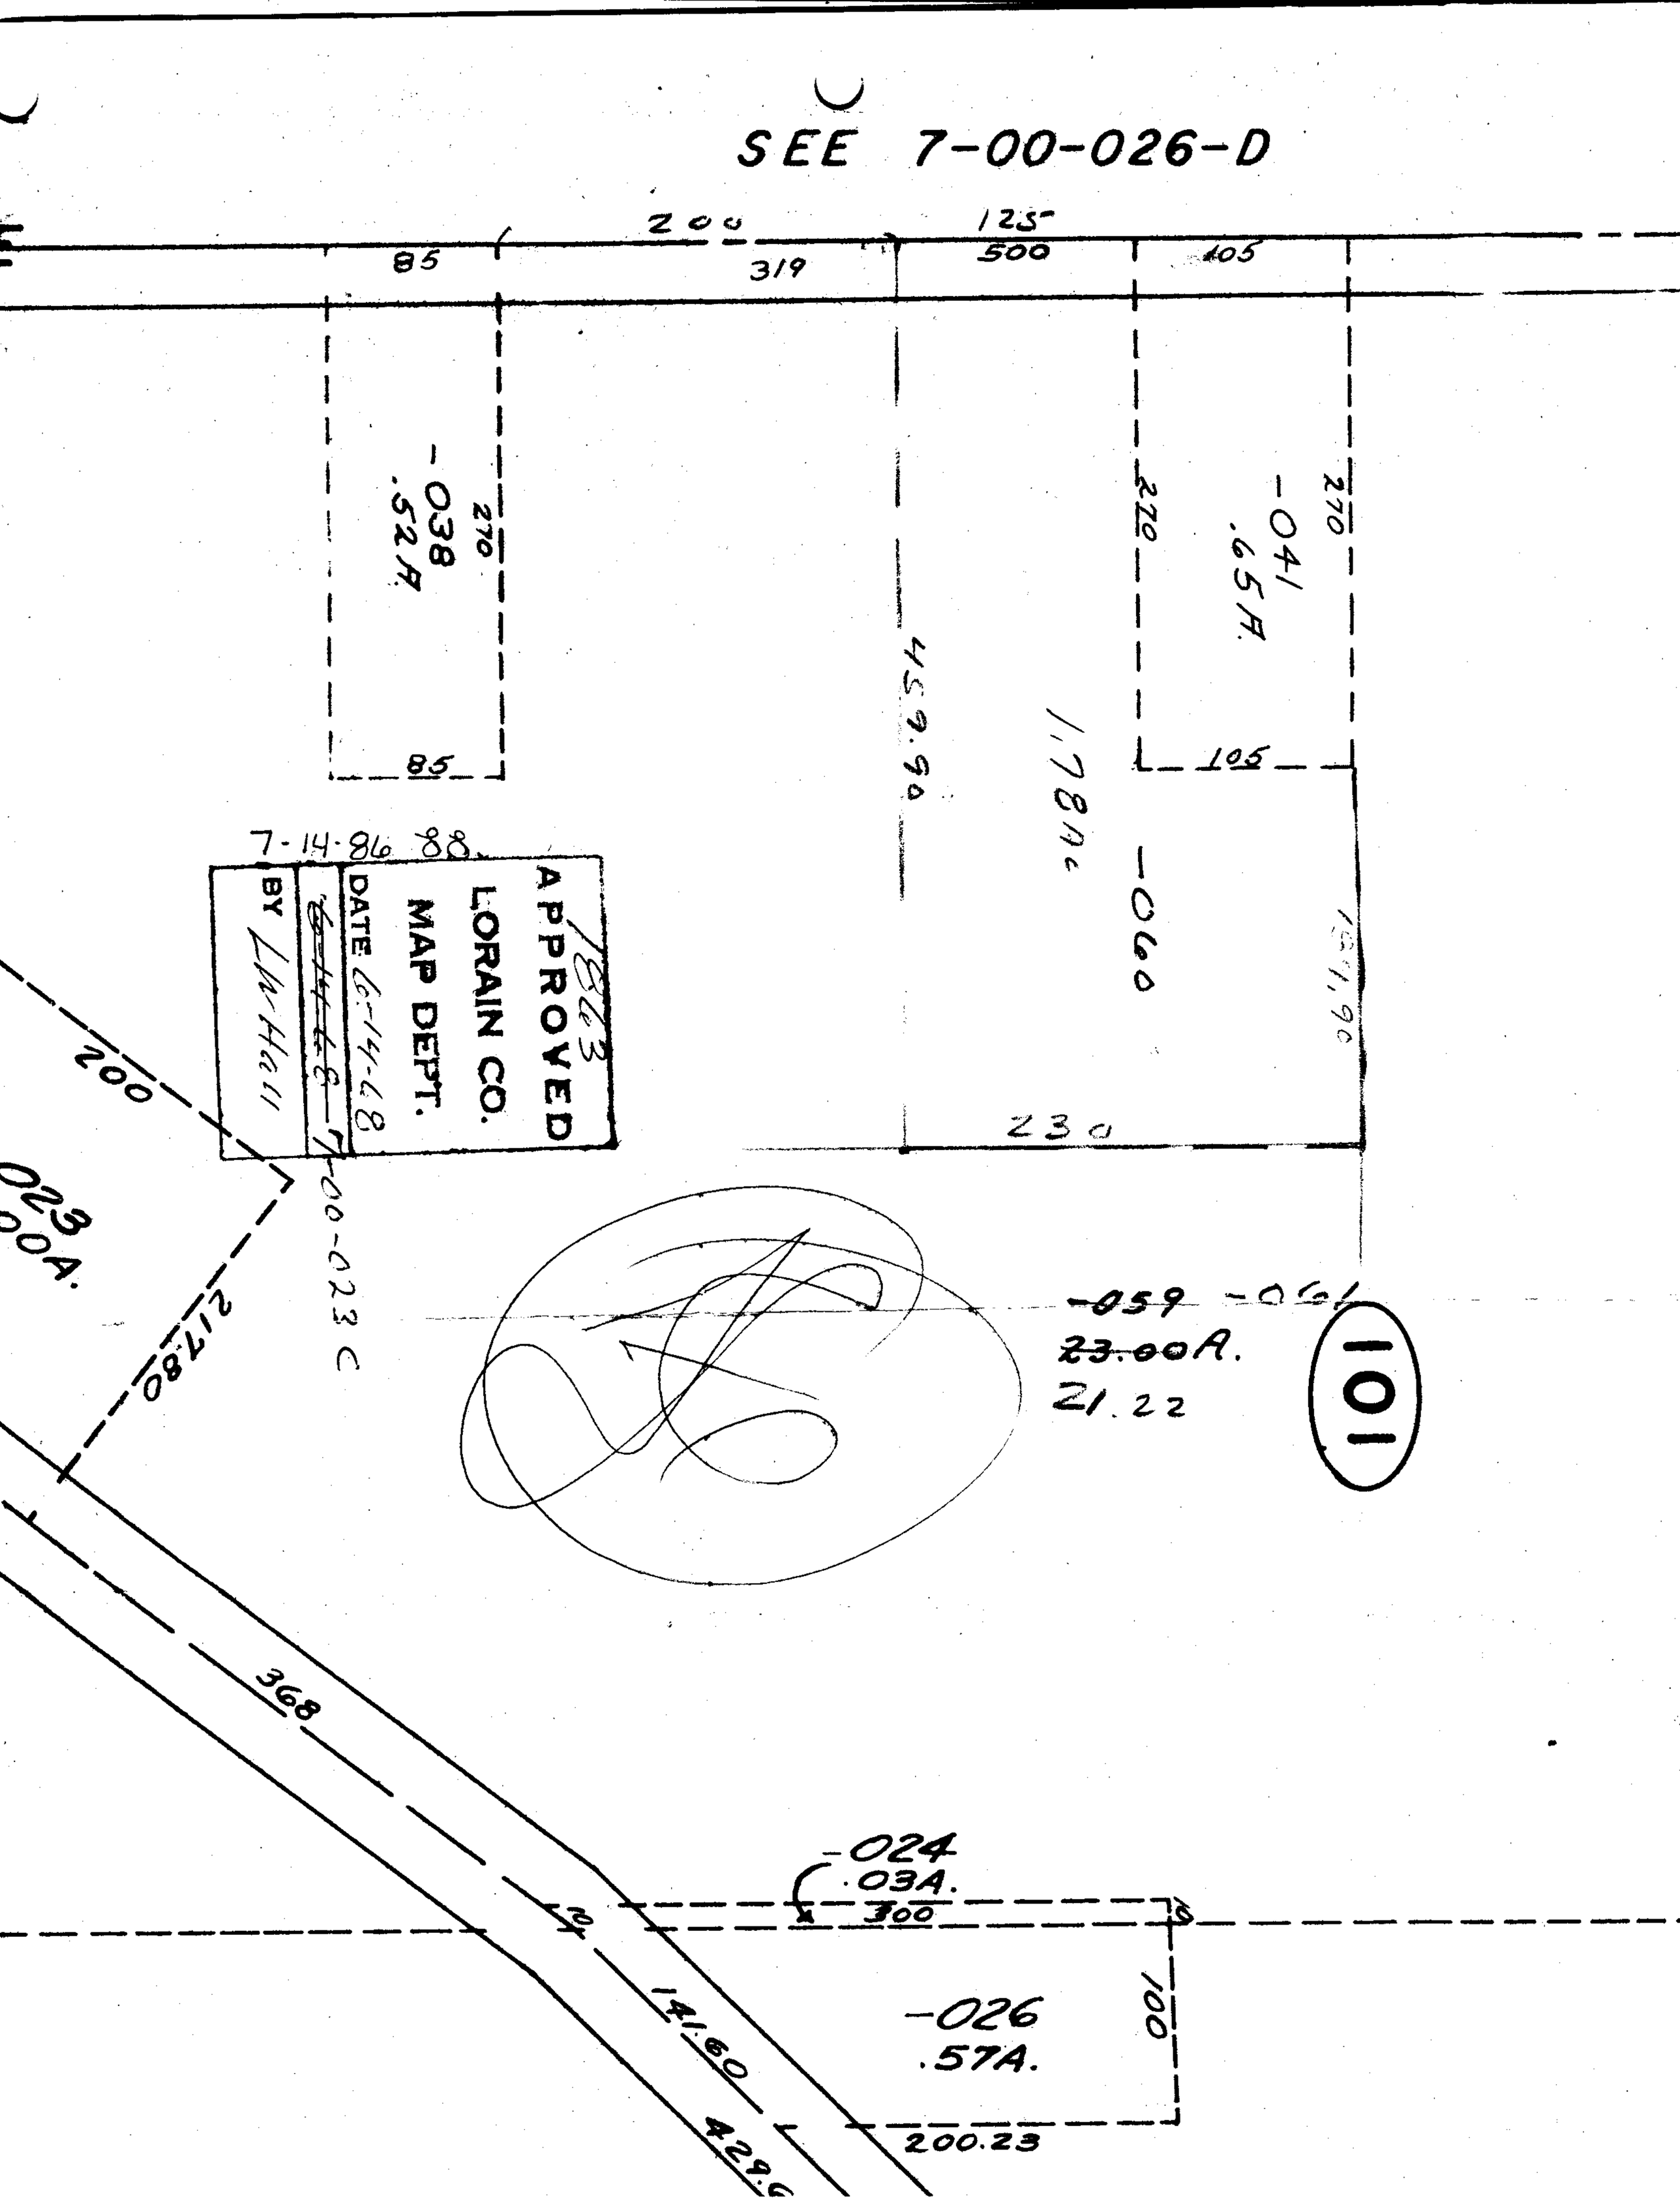
SEE 7-00-026-D
200
125
85
319
500
105
-038
.52A.
270
85
-041
.65A.
270
105
459.90
1.78Ac
-060
230
7-14-86 88
APPROVED
LORAIN CO.
MAP DEPT.
DATE 6-14-68
BY
-00-023 C
200
217.80
-059 -061
23.00A.
21.22
101
368
-024
.03A.
300
-026
.57A.
100
141.60
200.23