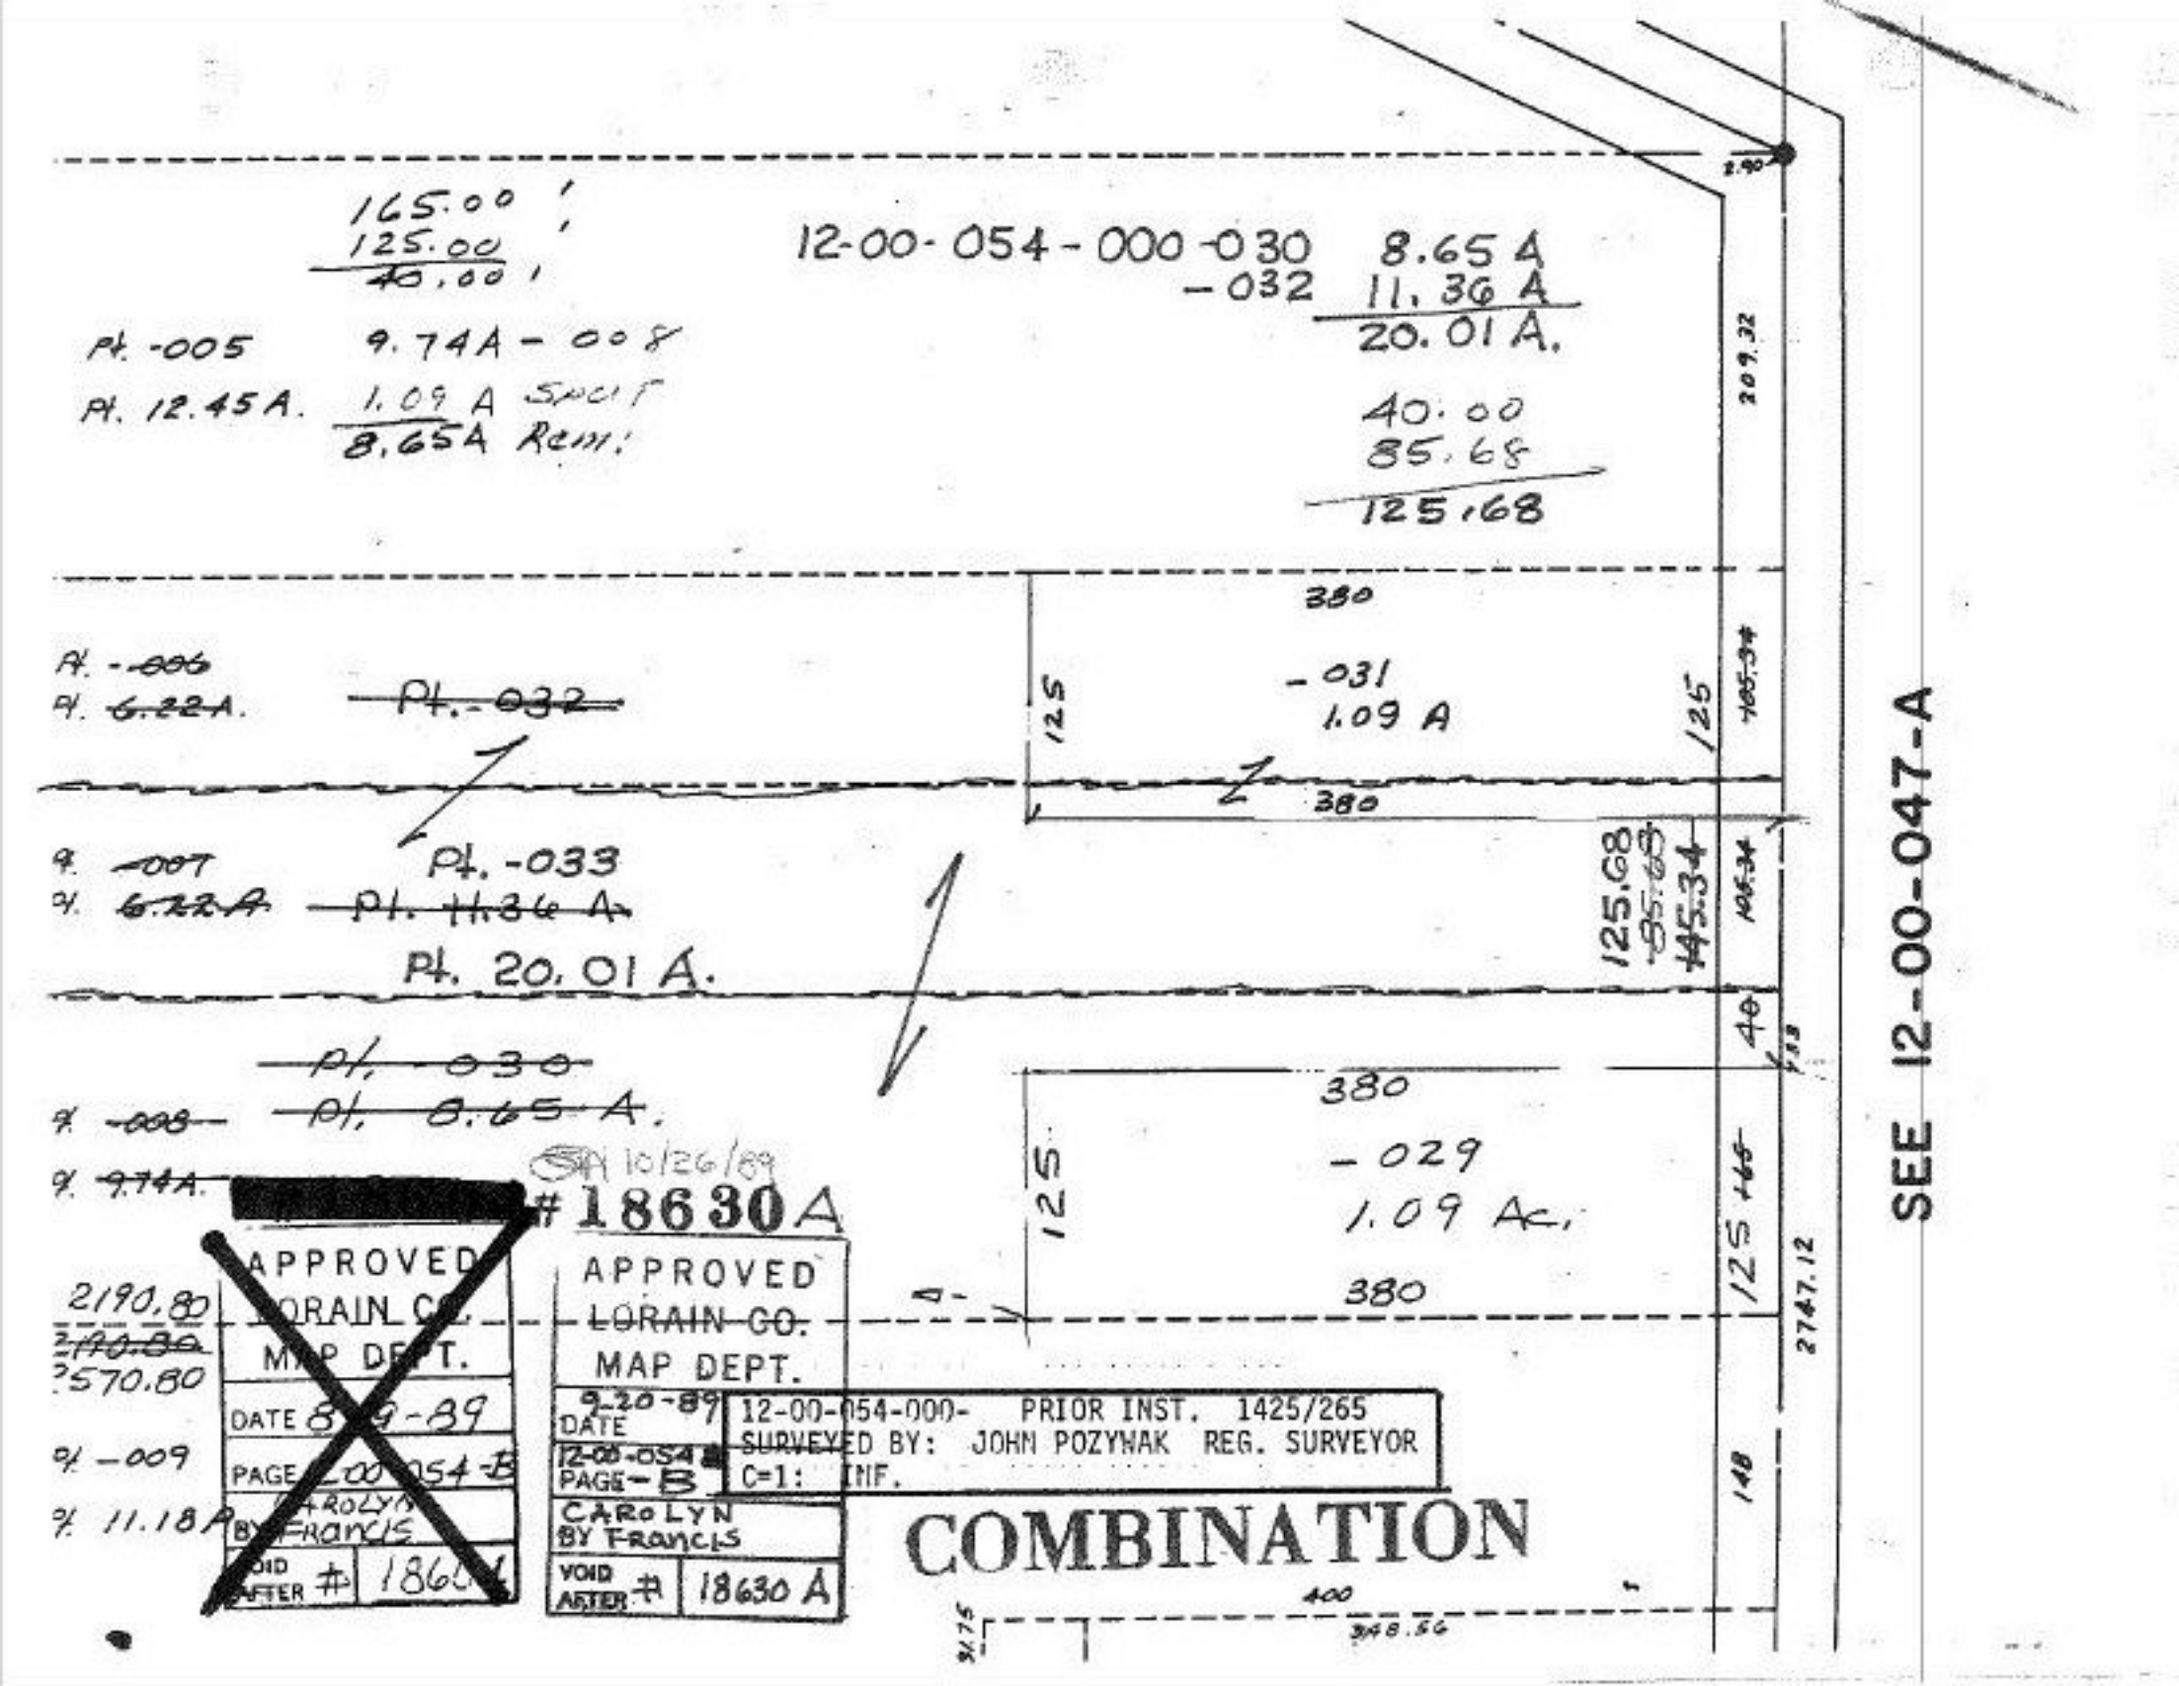
165.00'
125.00'
40.00'
Pt. -005 9.74A - 008
Pt. 12.45A. 1.09 A SPLIT
8.65A Rem.
12-00-054-000-030 8.65 A
-032 11.36 A
20.01 A.
40.00
85.68
125.68
380
-031
1.09 A
125'
380
Pt. -006
Pt. 6.22A.
Pt. -032
Pt. -007
Pt. 6.22A
Pt. 11.36 A.
Pt. -033
Pt. 20.01 A.
125.68
95.68
45.34
Pt. -008
Pt. 8.65 A.
Pt. 9.74A.
380
-029
1.09 Ac.
125'
380
#18630A
APPROVED
LORAIN CO.
MAP DEPT.
DATE 8-9-89
PAGE 12-00-054-B
BY CAROLYN FRANCIS
VOID AFTER # 18630
APPROVED
LORAIN CO.
MAP DEPT.
DATE 9-20-89
12-00-054-000- PRIOR INST. 1425/265
12-00-054 SURVEYED BY: JOHN POZYWAK REG. SURVEYOR
PAGE-B C=1: INF.
CAROLYN BY FRANCIS
VOID AFTER # 18630 A
2190.80
2570.80
Pt -009
Pt 11.18A
COMBINATION
400
348.56
SEE 12-00-047-A