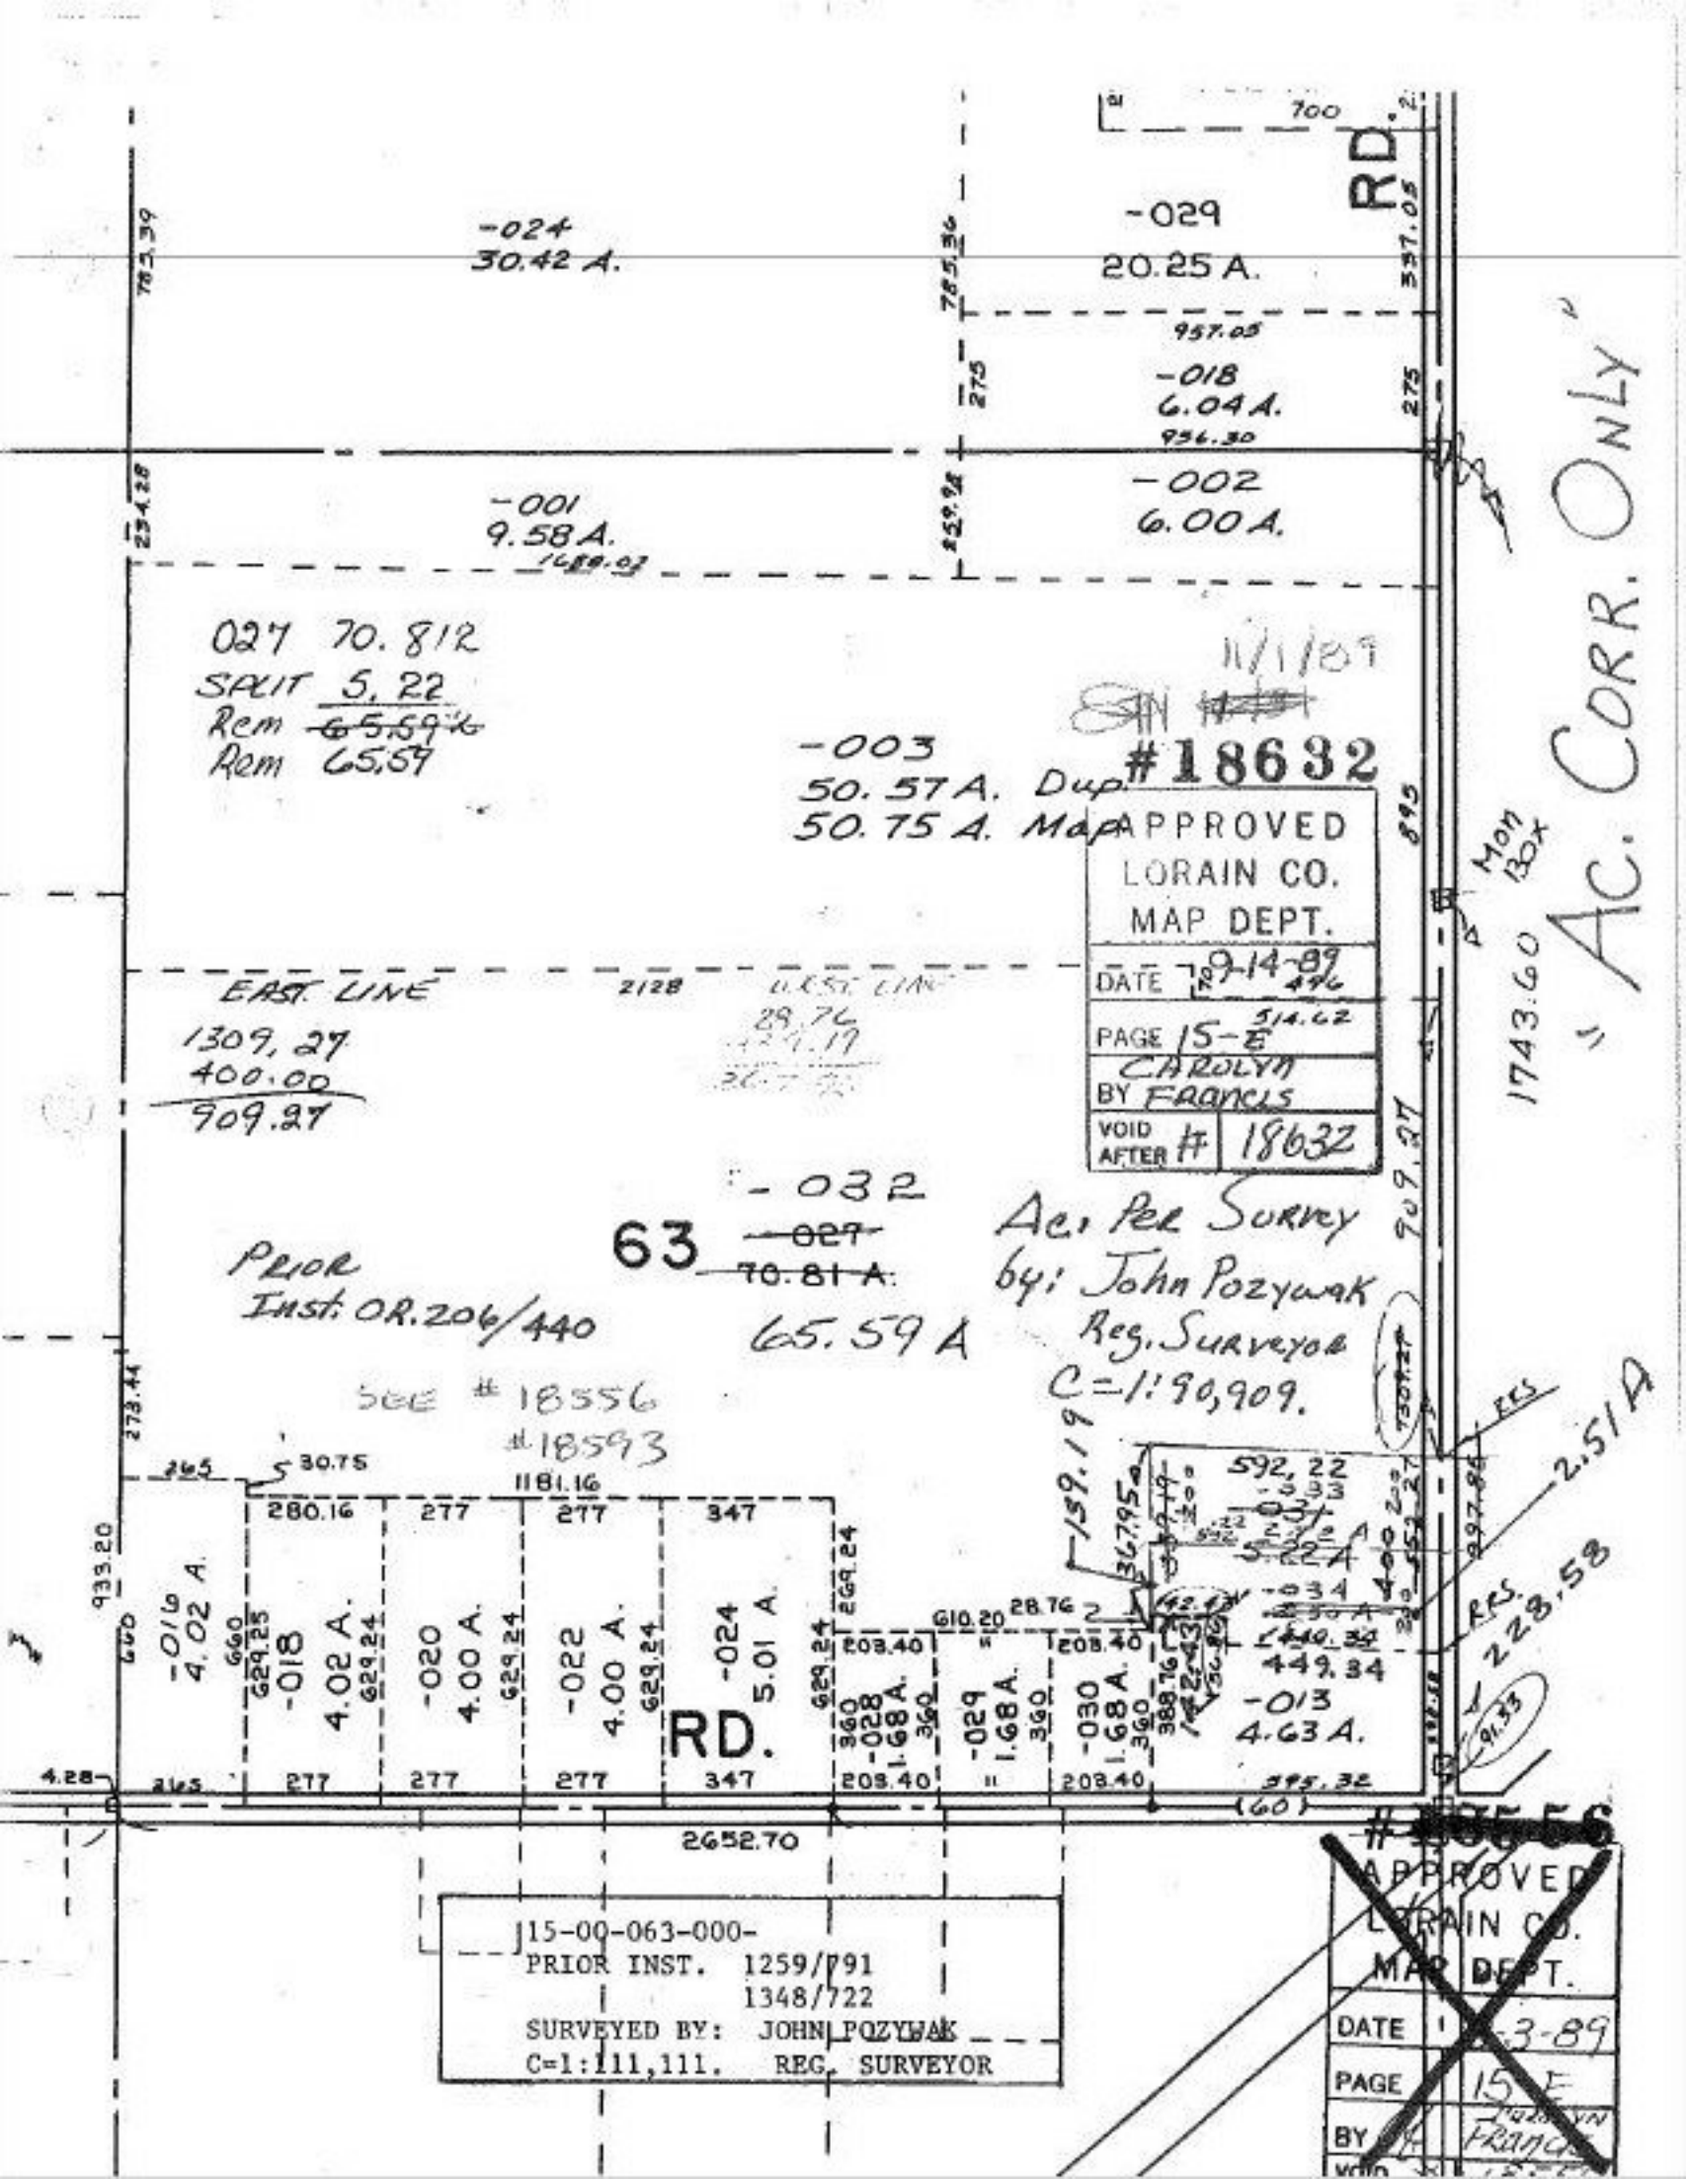

-024
30.42 A.
-029
20.25 A.
RD.
-018
6.04 A.
-002
6.00 A.
-001
9.58 A.
027 70.812
SPLIT 5.22
Rem ~~65.59~~
Rem 65.59
-003
50.57 A. Dup.
50.75 A. Map
11/1/89
#18632
APPROVED
LORAIN CO.
MAP DEPT.
DATE 9-14-89
PAGE 15-E
BY CAROLYN FRANCIS
VOID AFTER # 18632
EAST LINE
1309.27
400.00
909.27
-032
63 ~~-027~~
~~70.81 A.~~
65.59 A
Ac. Per Survey
by: John Pozywak
Reg. Surveyor
C=1:90,909.
PRIOR
Inst. OR.206/440
SEE #18556
#18593
-016
4.02 A.
-018
4.02 A.
-020
4.00 A.
-022
4.00 A.
-024
5.01 A.
RD.
-028
1.68 A.
-029
1.68 A.
-030
1.68 A.
-013
4.63 A.
592.22
449.34
2652.70
Mon Box
1743.60
"Ac. Corr. Only"
2.51 A
RES.
228.58
15-00-063-000-
PRIOR INST. 1259/791
1348/722
SURVEYED BY: JOHN POZYWAK
C=1:111,111. REG. SURVEYOR
APPROVED
LORAIN CO.
MAP DEPT.
DATE
PAGE 15-E
BY