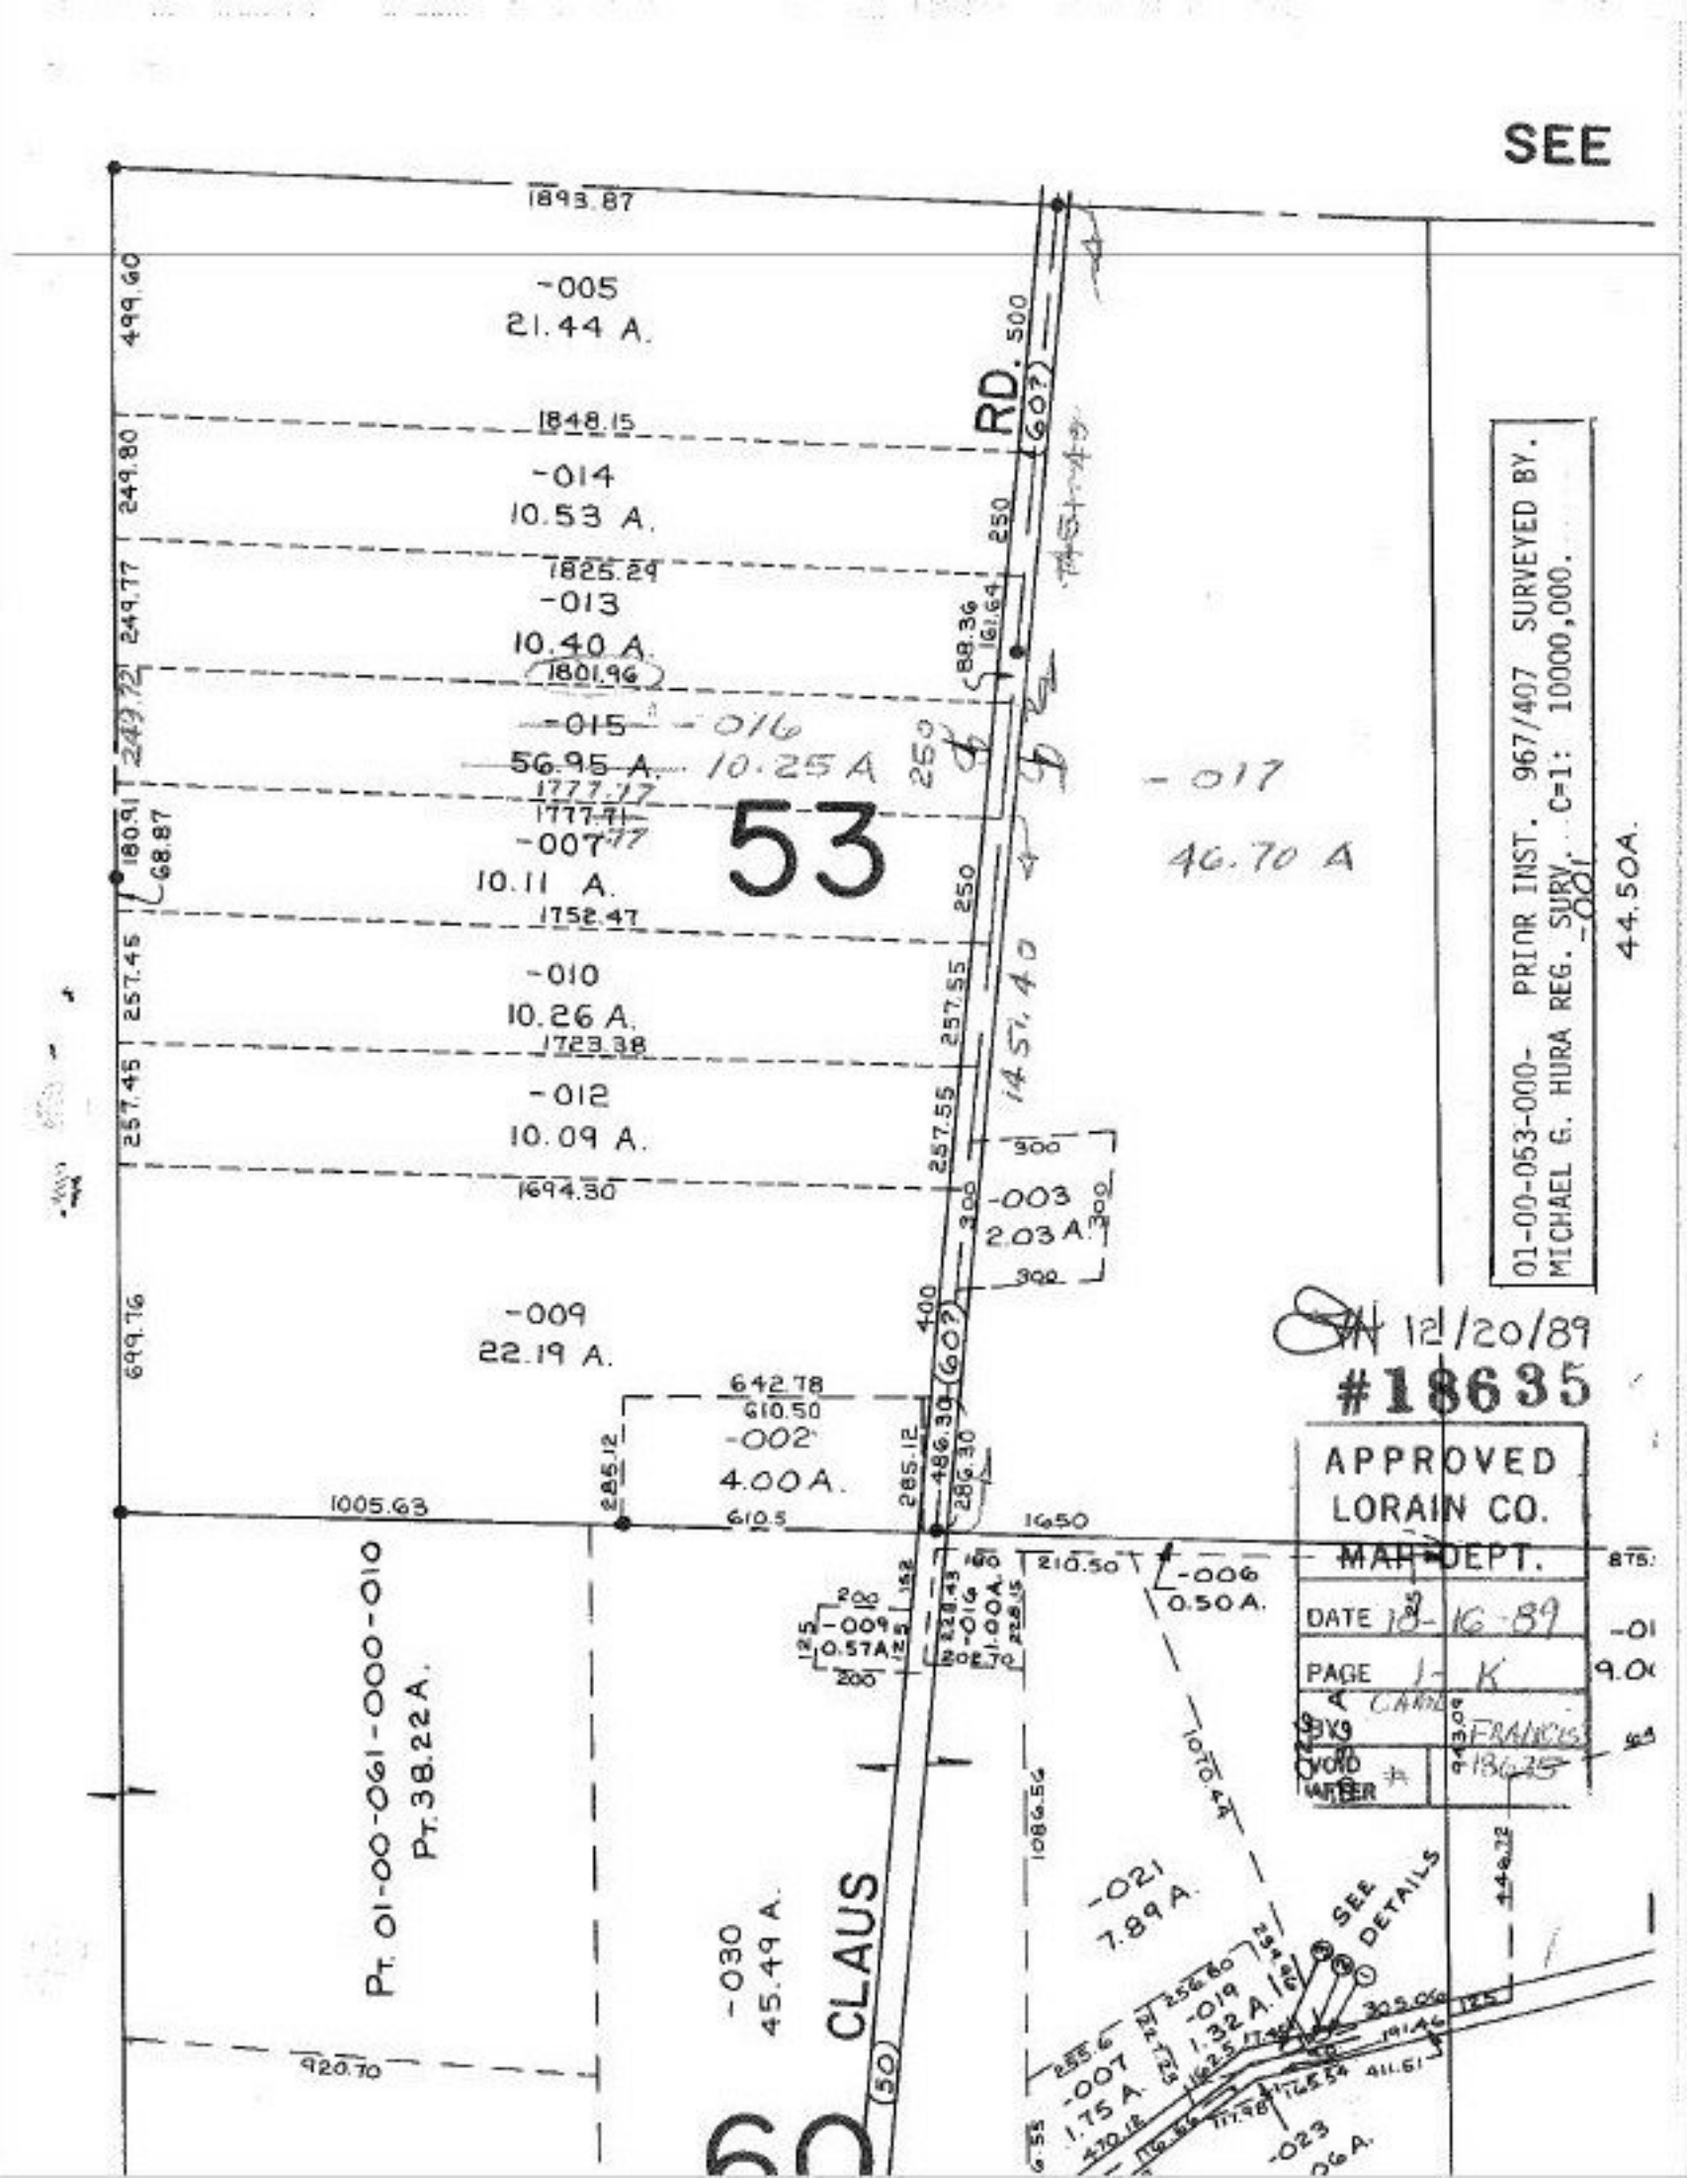
SEE
1893.87
-005
21.44 A.
1848.15
-014
10.53 A.
1825.29
-013
10.40 A.
1801.96
-015
56.95 A.
-016
10.25 A
1777.77
-007
10.11 A.
1752.47
-010
10.26 A.
1723.38
-012
10.09 A.
1694.30
-009
22.19 A.
-017
46.70 A
53
RD.
-003
2.03 A.
642.78
610.50
-002
4.00 A.
1005.63
1650
-006
0.50 A.
-009
0.57 A.
-016
1.00 A.
-021
7.89 A.
-030
45.49 A.
CLAUS
PT. 01-00-061-000-010
PT. 38.22 A.
920.70
-007
1.75 A.
-019
1.32 A.
-023
SEE DETAILS
01-00-053-000- PRIOR INST. 967/407 SURVEYED BY.
MICHAEL G. HURA REG. SURV. C=1: 10000,000.
44.50A.
12/20/89
#18635
APPROVED
LORAIN CO.
MAP DEPT.
DATE 18-16-89
PAGE 1-K
BY
VOID
AFTER