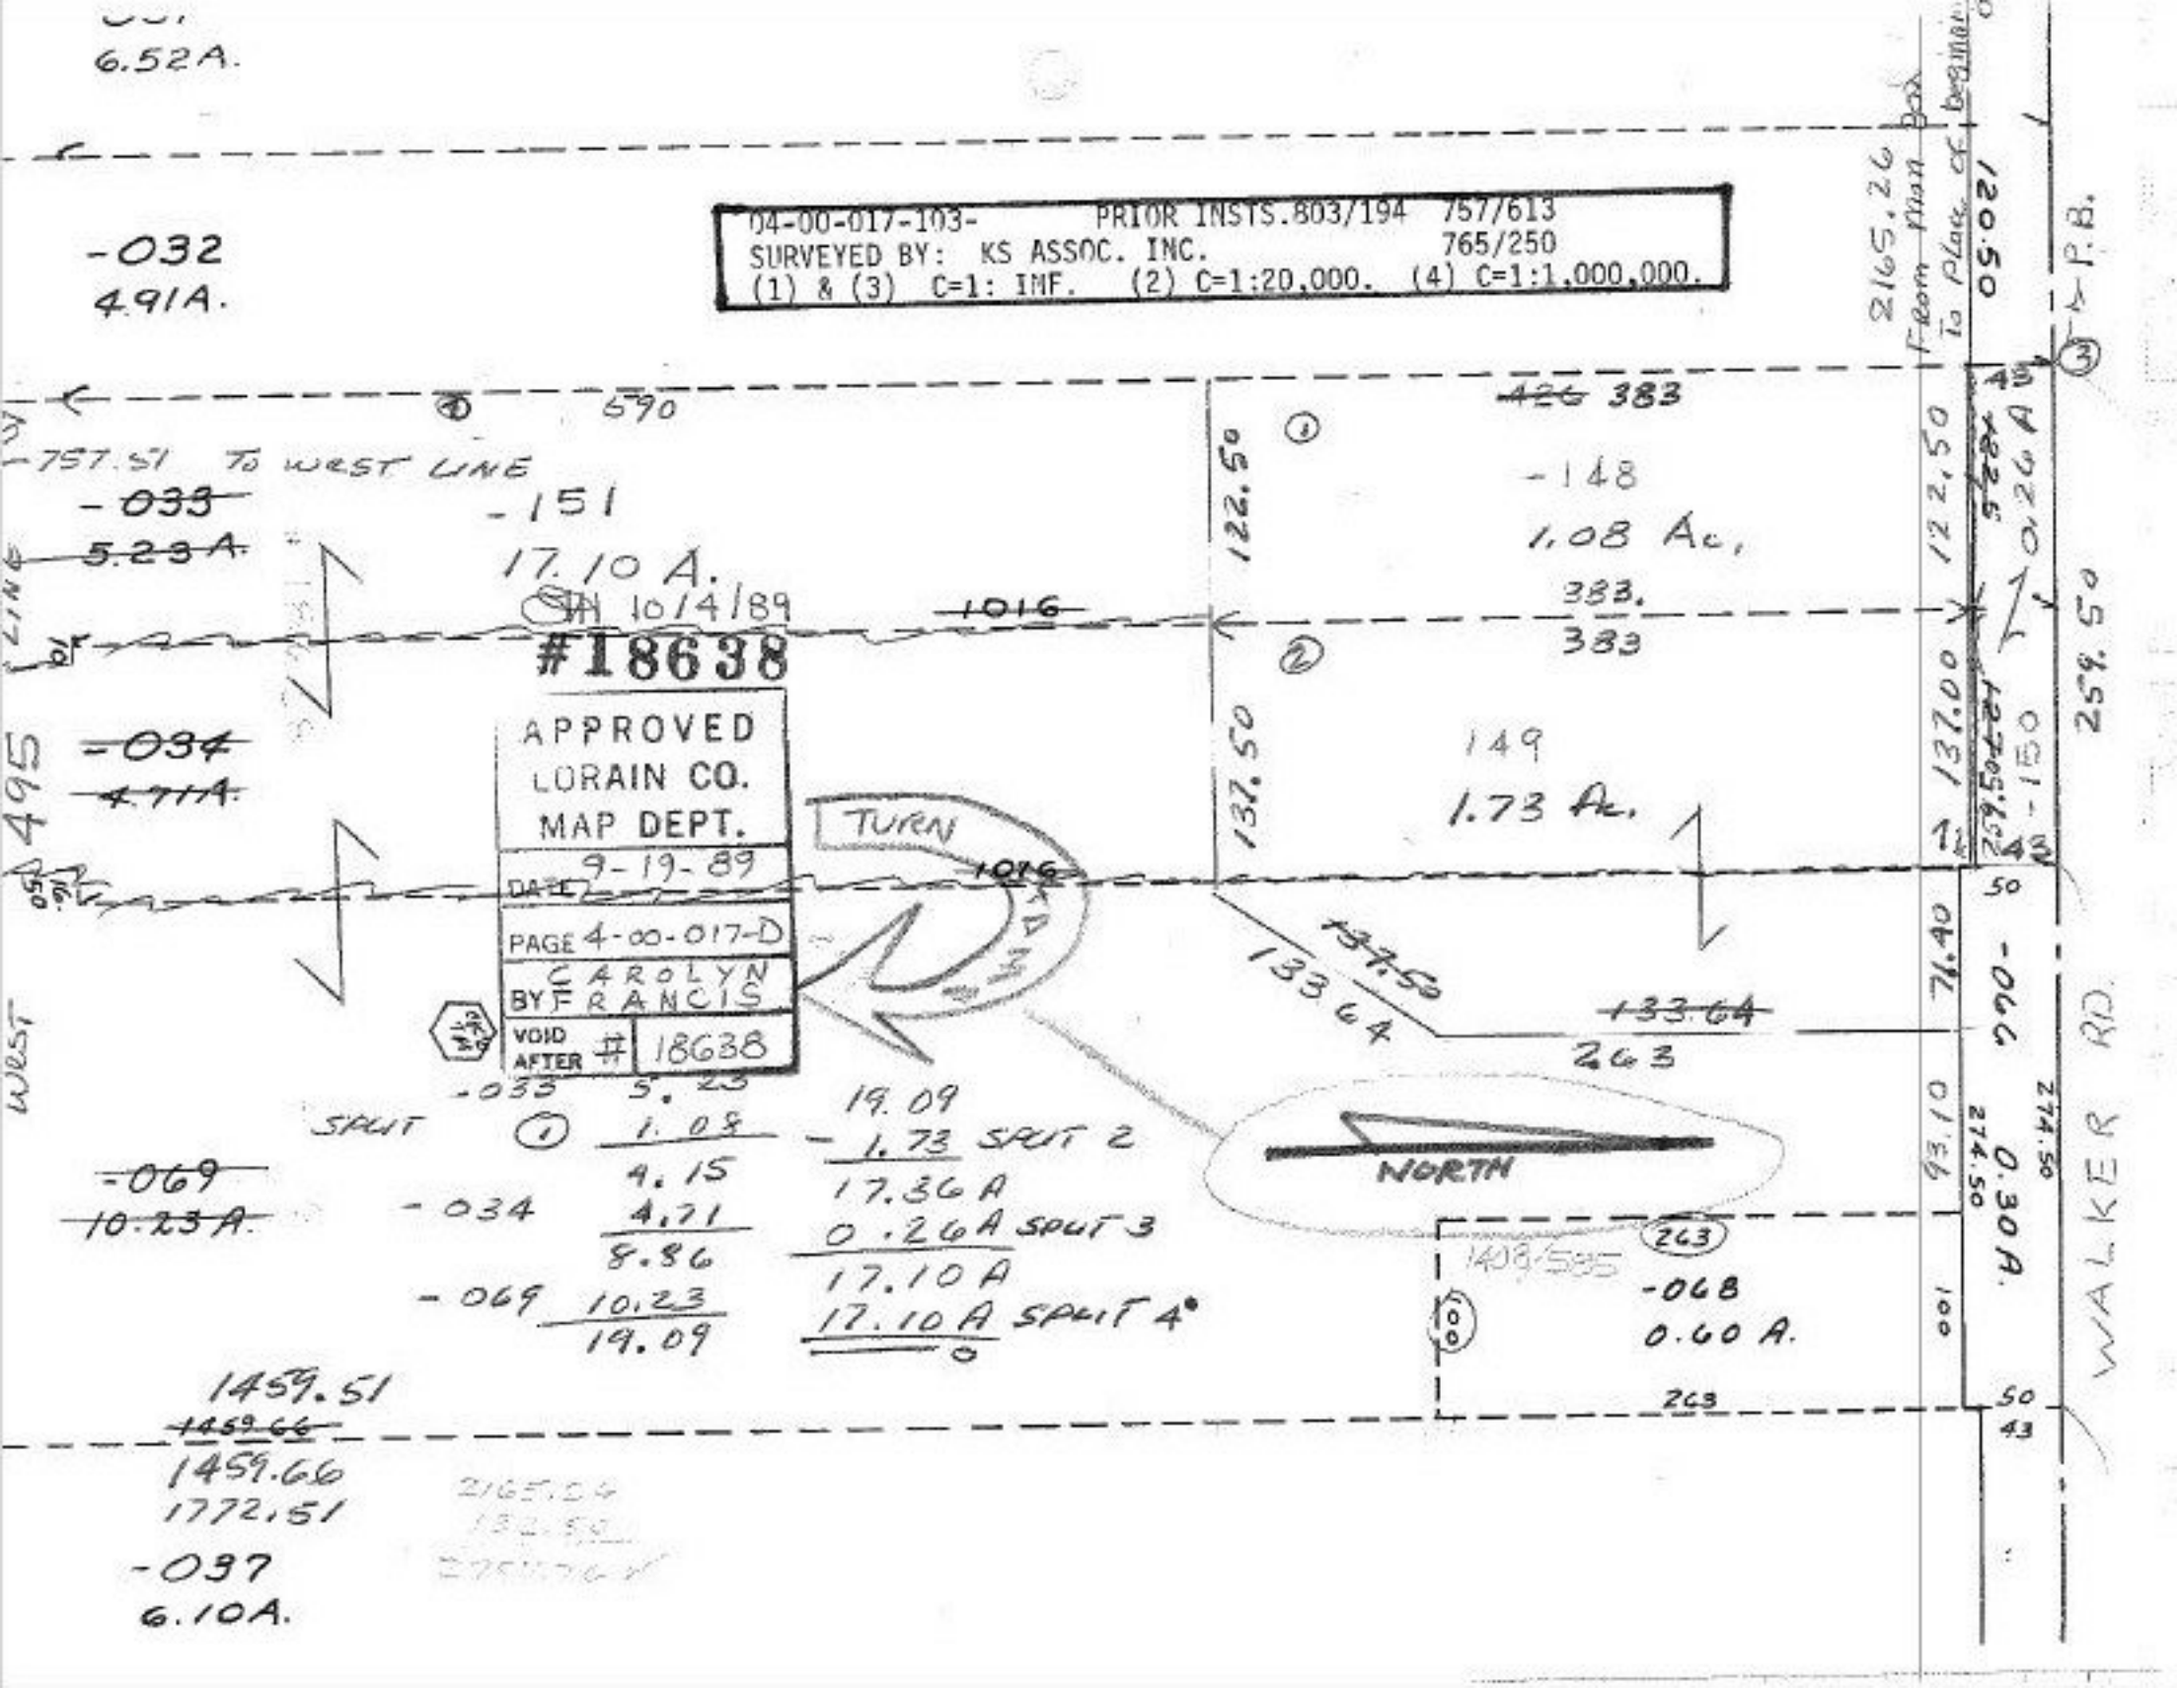

6.52A.
04-00-017-103- PRIOR INSTS.803/194 757/613
SURVEYED BY: KS ASSOC. INC. 765/250
(1) & (3) C=1: INF. (2) C=1:20,000. (4) C=1:1,000,000.
-032
4.91A.
2165.26 From Man Box To Place of beginning
120.50
P.B.
590
757.51 TO WEST LINE
-033
5.23A.
-151
17.10 A.
10/4/89
1016
#18638
APPROVED
LORAIN CO.
MAP DEPT.
DATE 9-19-89
PAGE 4-00-017-D
BY CAROLYN FRANCIS
VOID AFTER # 18638
-034
4.71A.
495
WEST
TURN
1016
122.50
137.50
426 383
-148
1.08 Ac.
383.
383
149
1.73 Ac.
137.50
133.64
133.64
263
-150
259.50
0.26 A
71.40
-066
0.30 A.
274.50
93.10
100
263
-068
0.60 A.
WALKER RD.
-033 5.23
SPLIT 1 1.08
4.15
-034 4.71
8.86
-069 10.23
19.09
19.09
- 1.73 SPLIT 2
17.36 A
0.26 A SPLIT 3
17.10 A
17.10 A SPLIT 4
NORTH
-069
10.23A.
1459.51
1459.66
1459.66
1772.51
-037
6.10A.