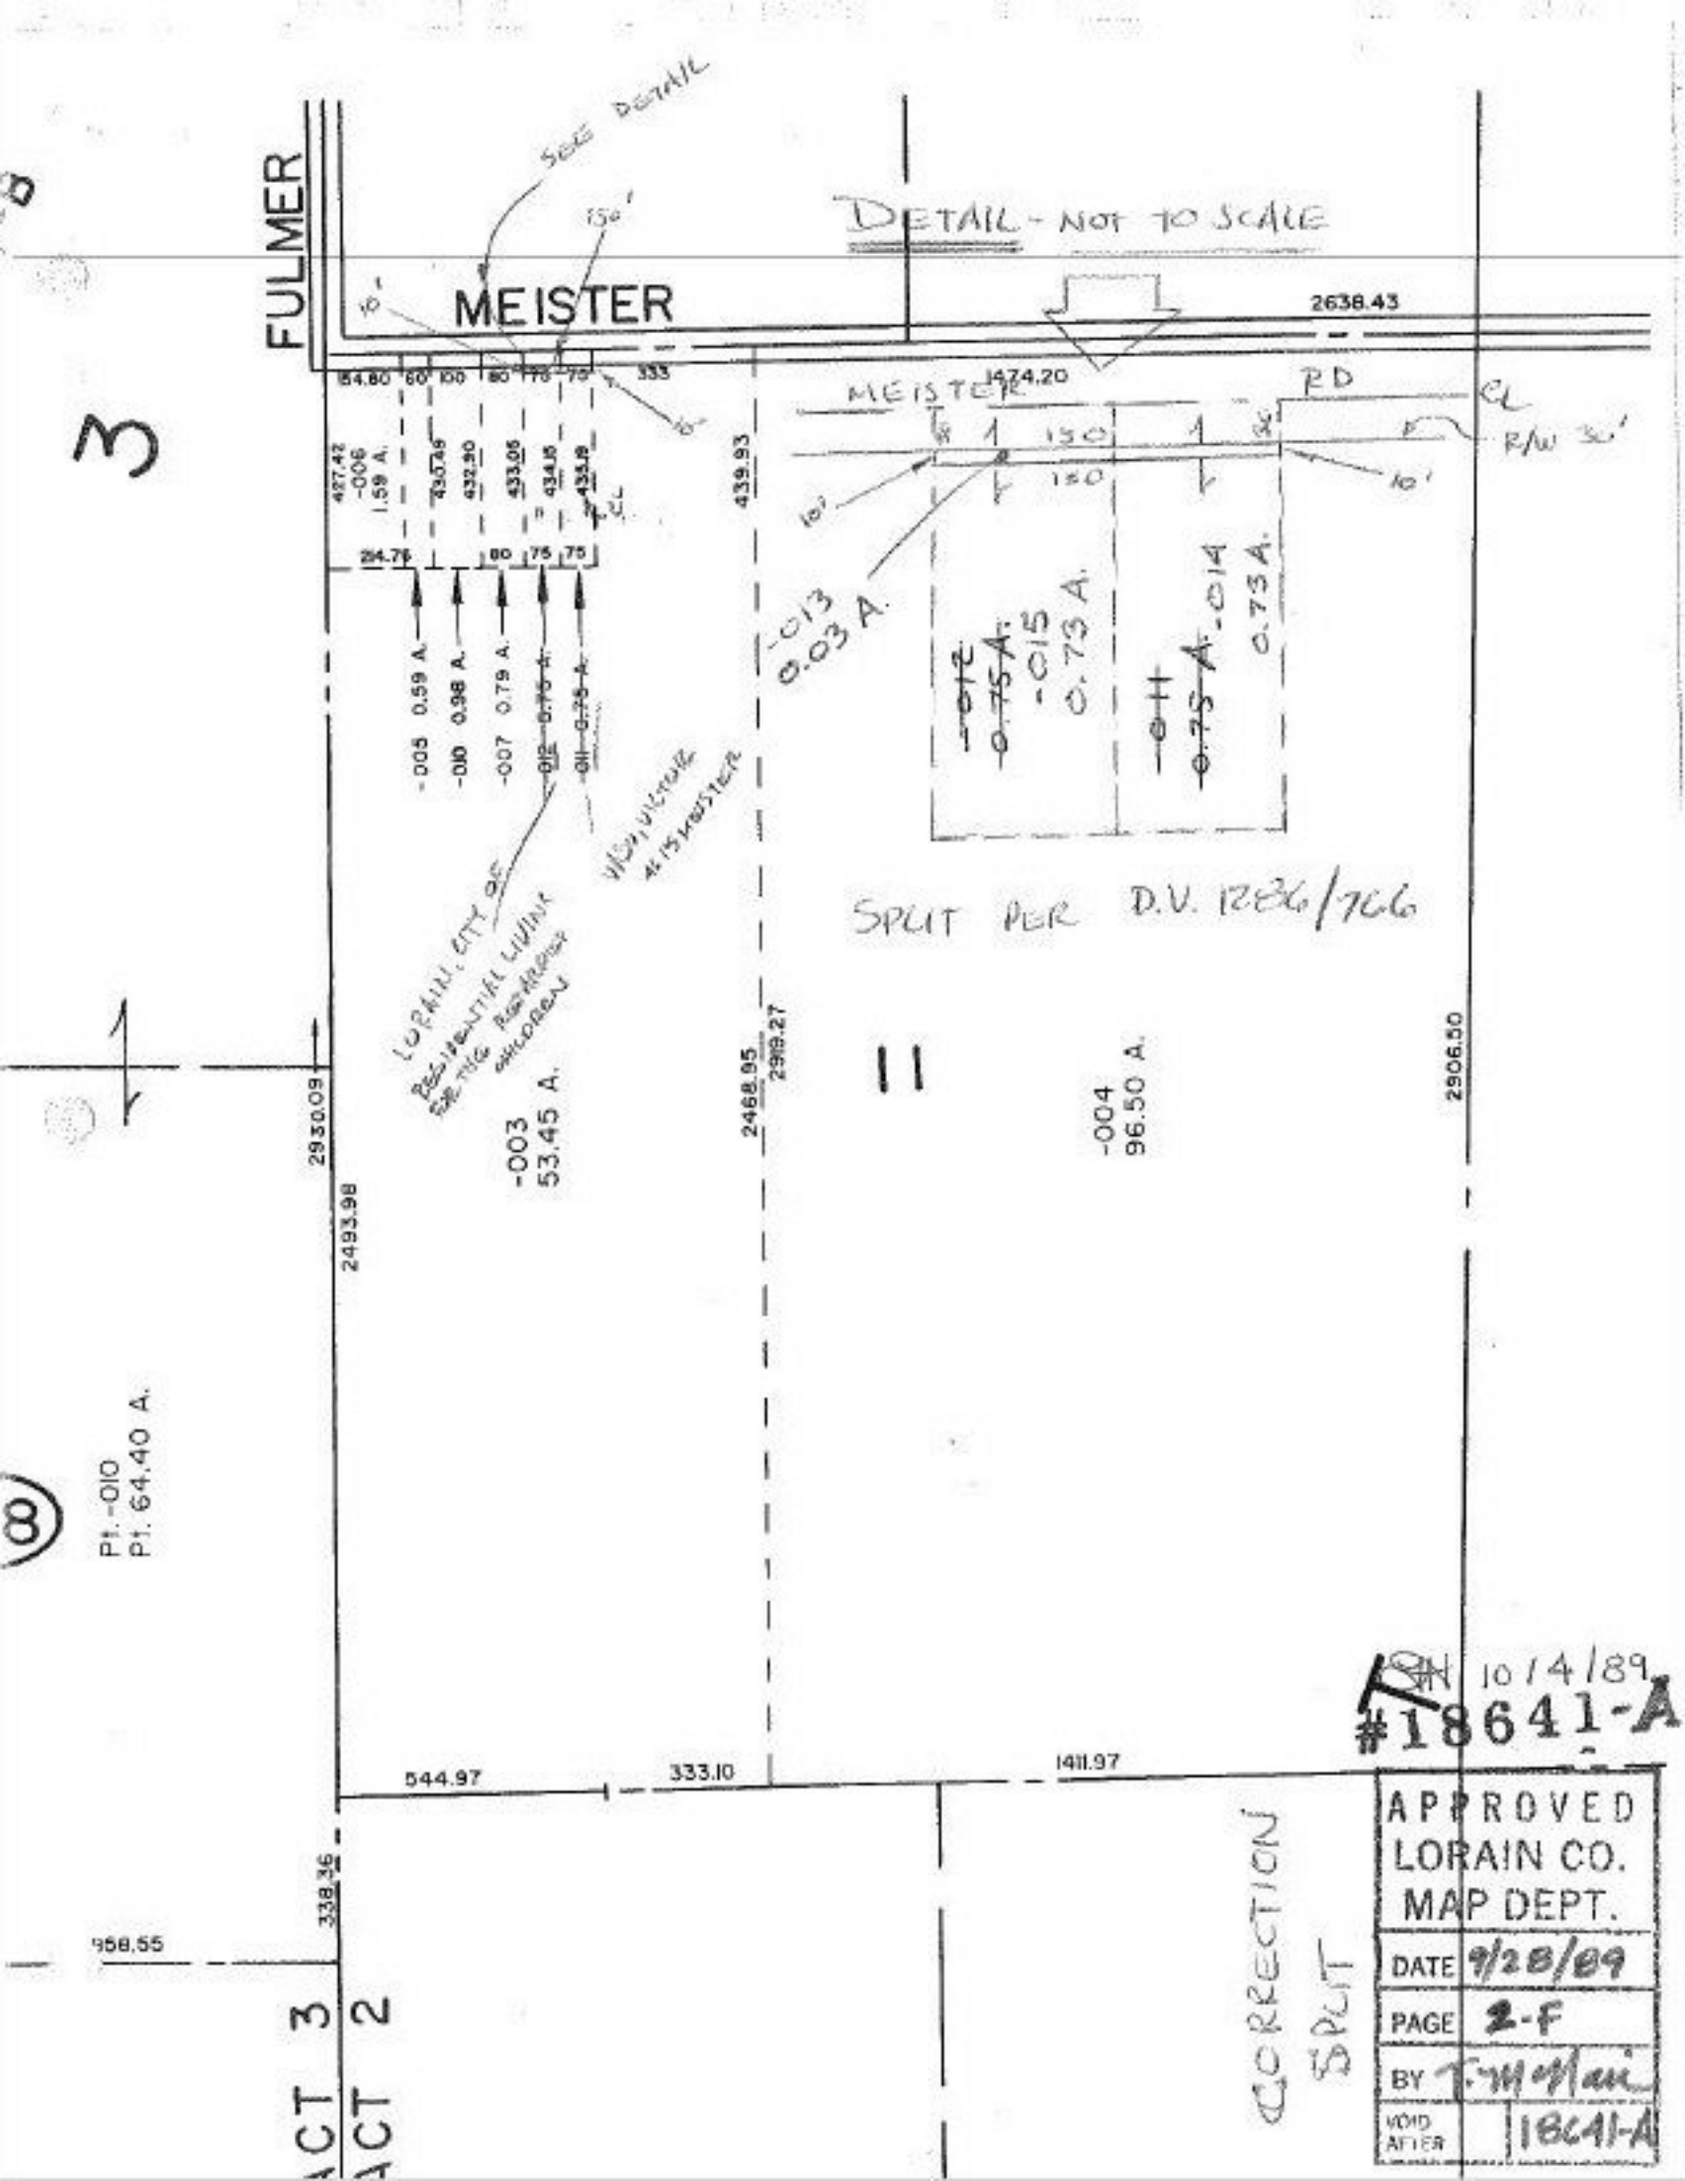
FULMER
MEISTER
SEE DETAIL
150'
DETAIL - NOT TO SCALE
2638.43
MEISTER RD
R/W 30'
1474.20
439.93
-013
0.03 A.
-012
0.75 A.
-015
0.73 A.
-014
0.73 A.
SPLIT PER D.V. 1226/766
-003
53.45 A.
-004
96.50 A.
2468.95
299.27
2930.09
2493.98
2906.50
P.I. -010
P.I. 64.40 A.
544.97
333.10
1411.97
338.36
958.55
CORRECTION SPLIT
10/4/89
#18641-A
APPROVED
LORAIN CO.
MAP DEPT.
DATE 9/28/89
PAGE 2-F
BY T. McClain
VOID AFTER 18641-A