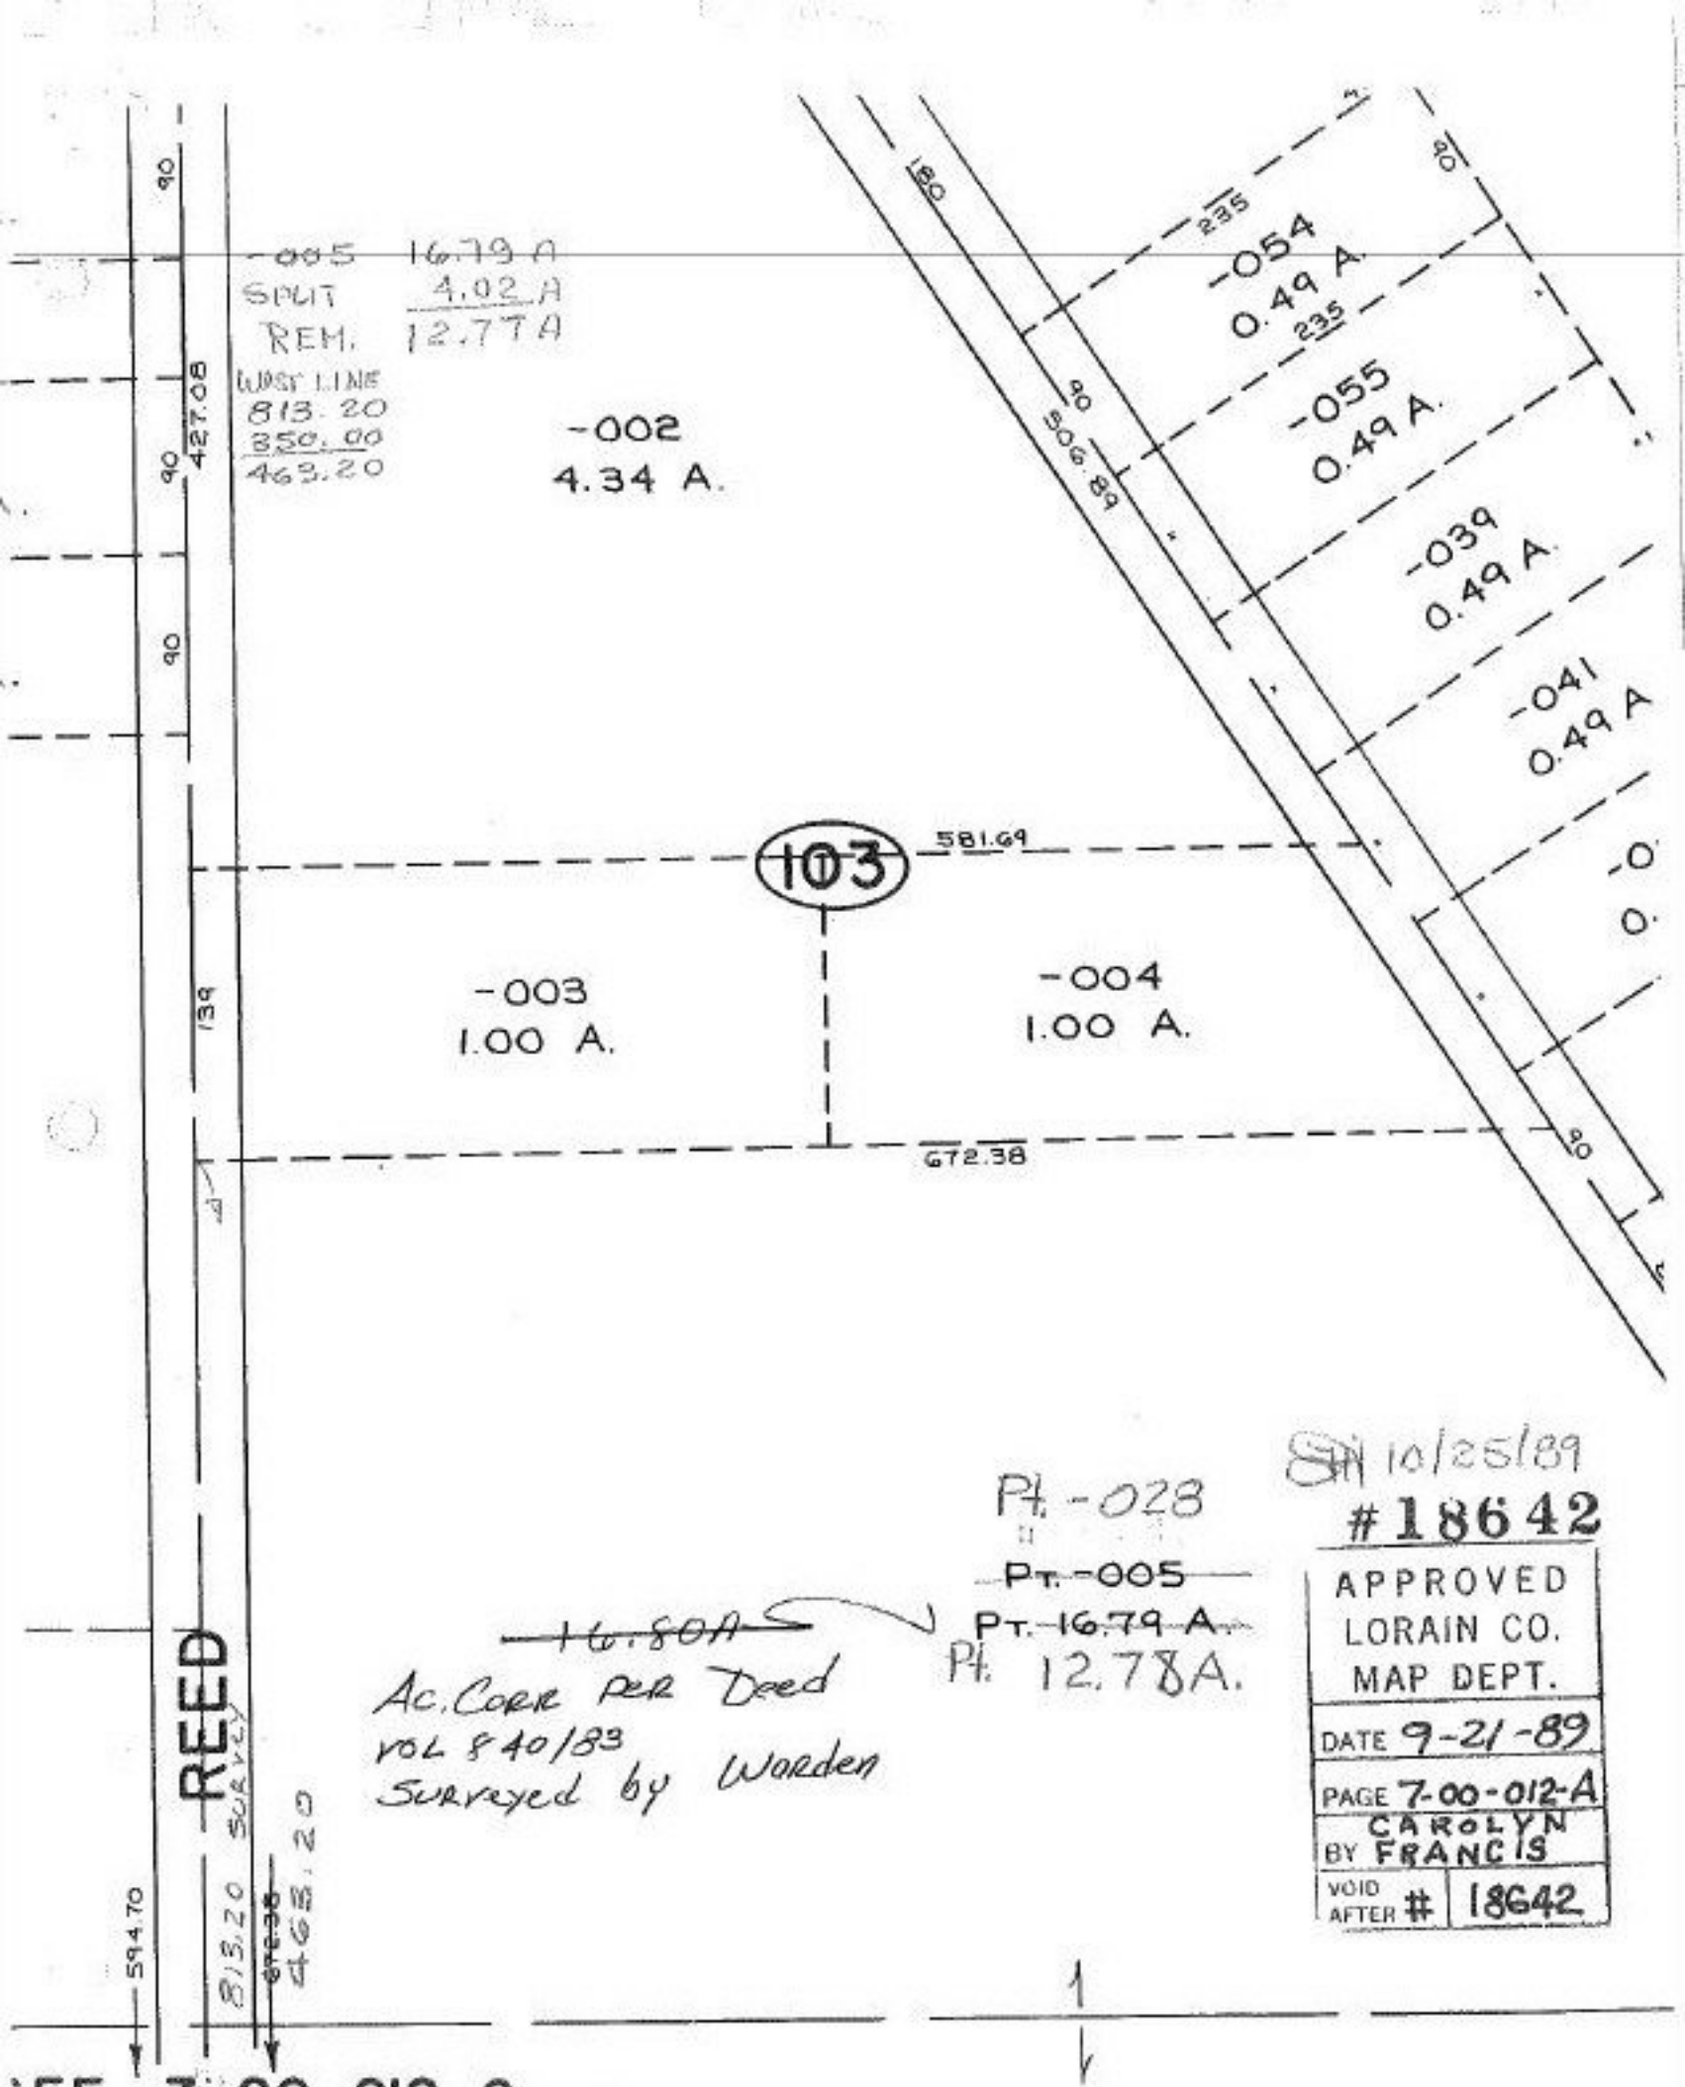

Pt. -028
~~Pt. -005~~
~~Pt. 16.79 A.~~
Pt. 12.78A.

~~16.80A~~
Ac. Corr per Deed
Vol 840/83
Surveyed by Worden

SH 10/25/89

#18642

APPROVED
LORAIN CO.
MAP DEPT.
DATE 9-21-89
PAGE 7-00-012-A
BY CAROLYN FRANCIS
VOID AFTER # 18642

SEE 7-00-012-C