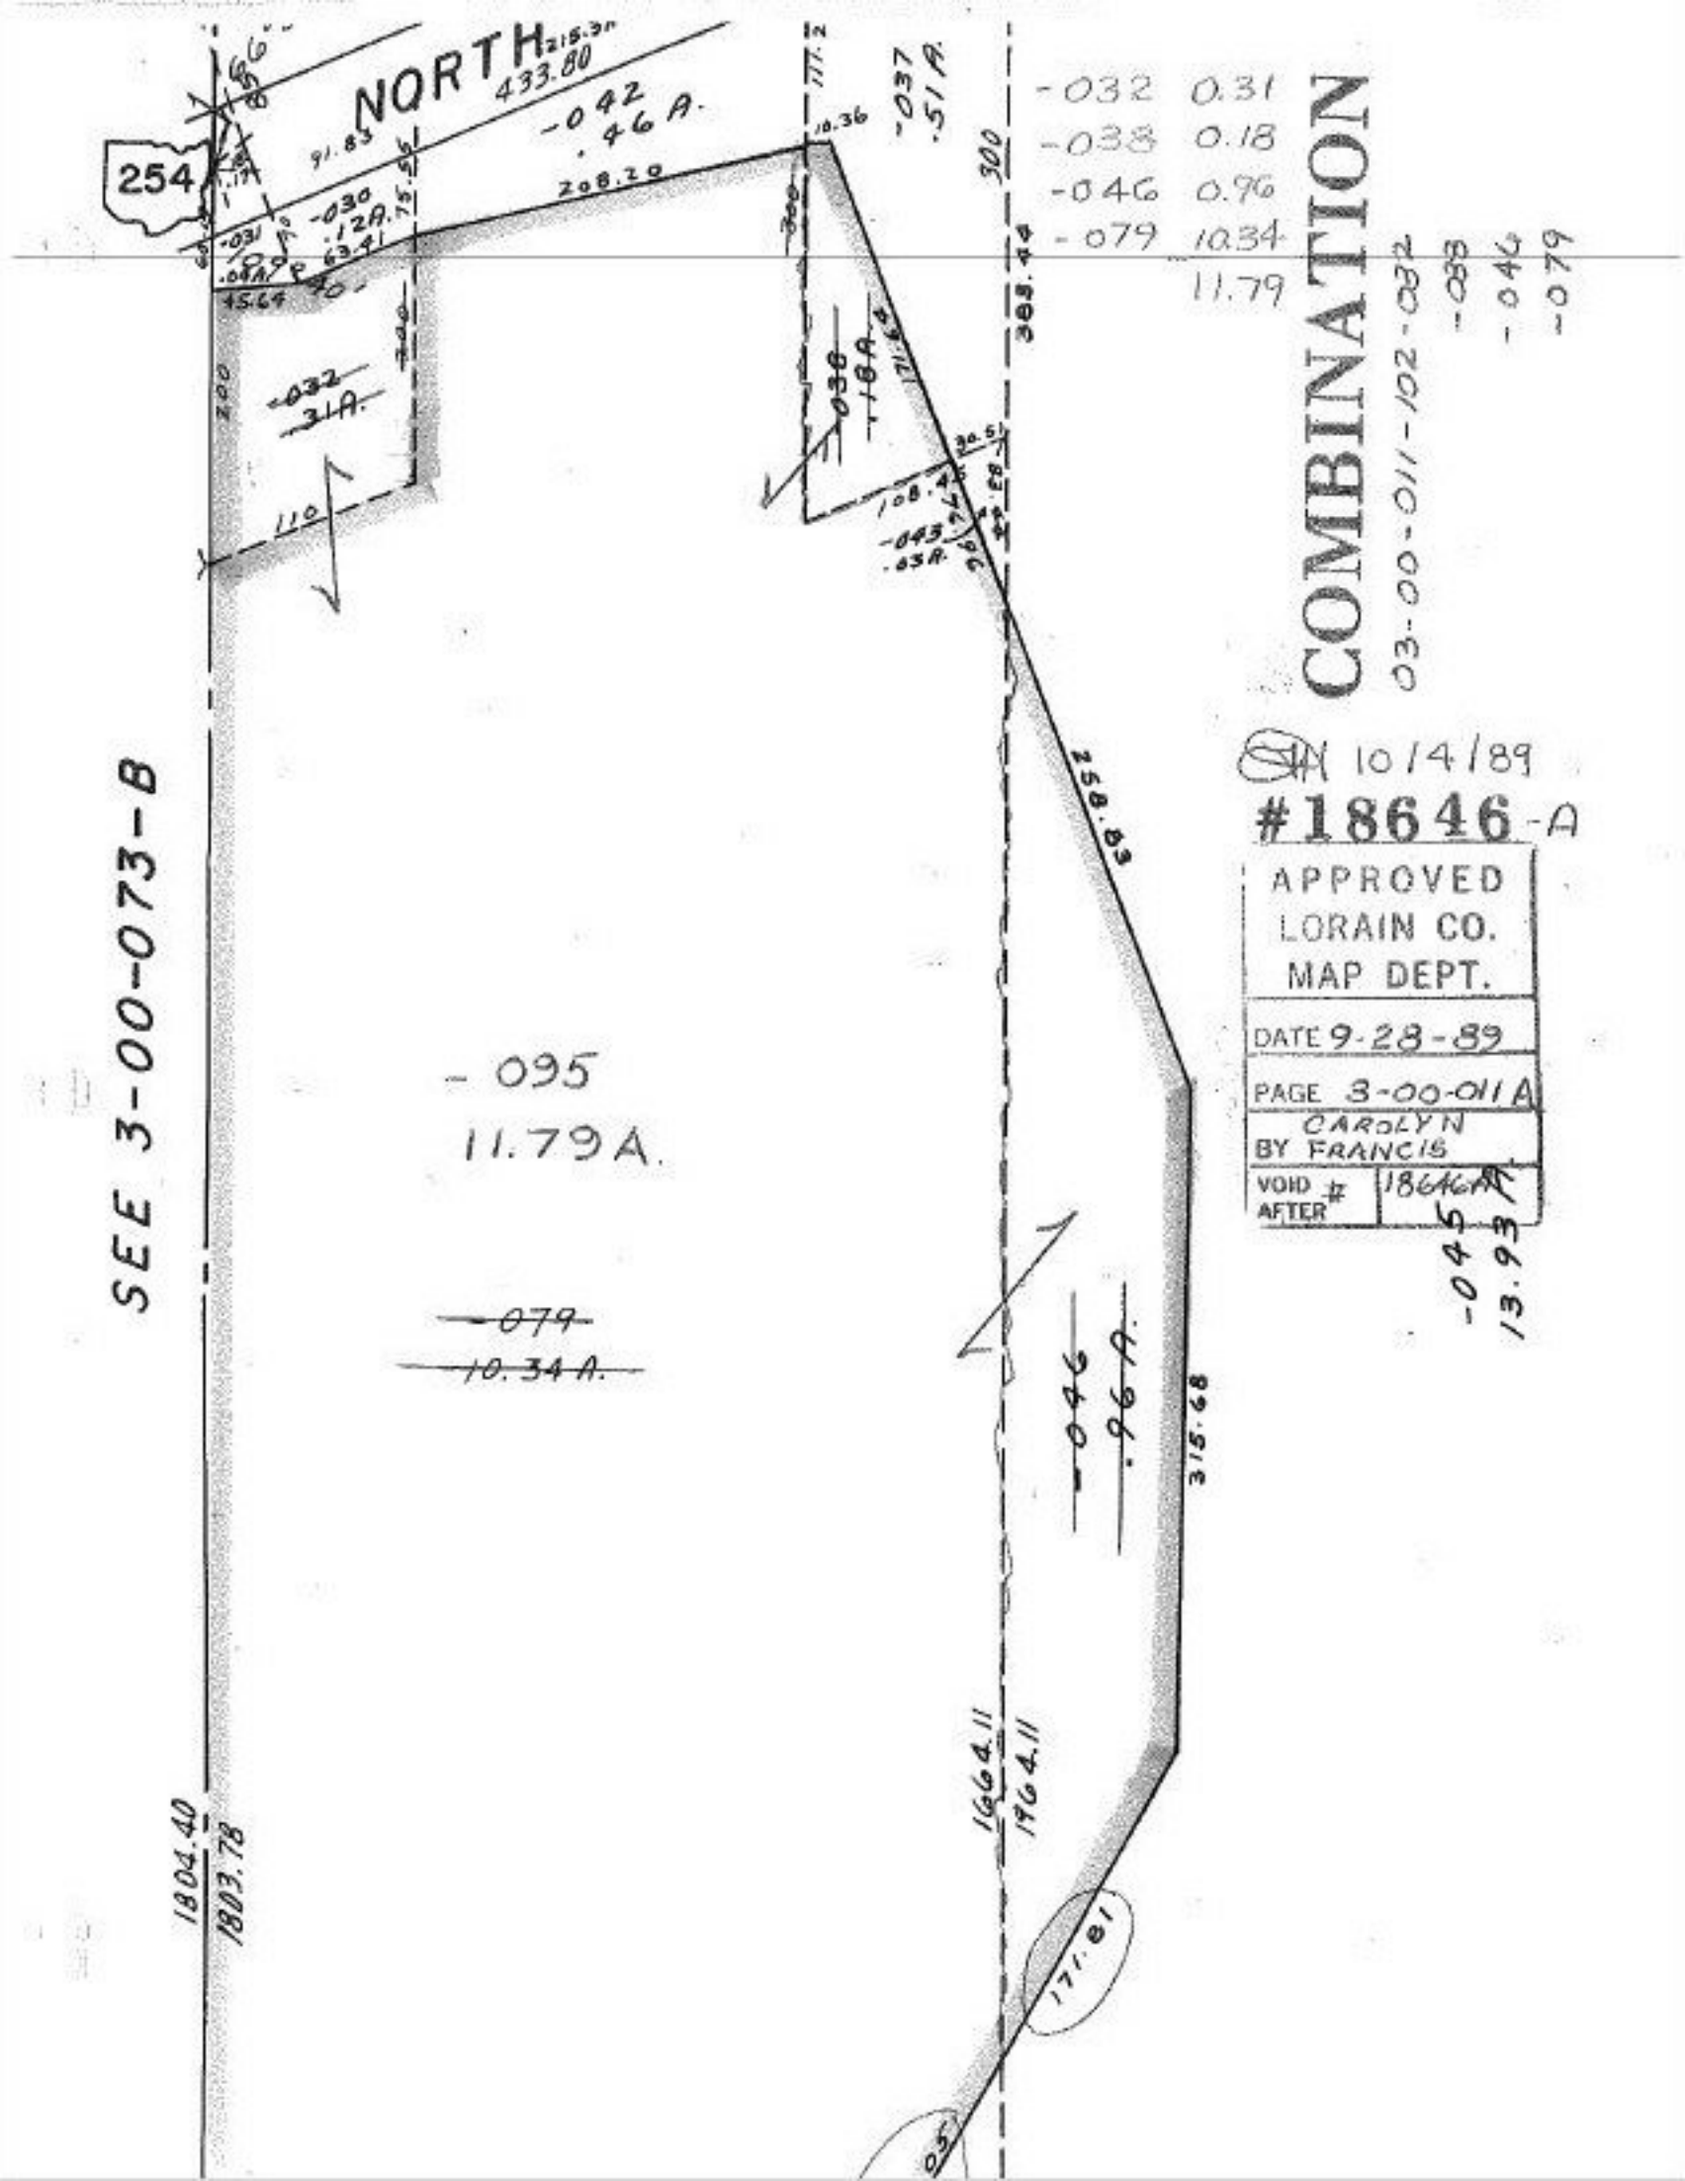
NORTH
254
433.80
-042
.46 A.
208.20
-037
.51 A.
-032 0.31
-038 0.18
-046 0.96
-079 10.34
11.79
COMBINATION
03-00-011-102-032
-038
-046
-079
-032
.31 A.
-038
.18 A.
-043
.03 A.
258.83
SEE 3-00-073-B
-095
11.79 A.
-079
10.34 A.
-046
.96 A.
315.68
1664.11
1964.11
1804.40
1803.78
171.81
10/4/89
#18646-A
APPROVED
LORAIN CO.
MAP DEPT.
DATE 9-28-89
PAGE 3-00-011 A
BY CAROLYN FRANCIS
VOID AFTER # 18646A
-045
13.93 A