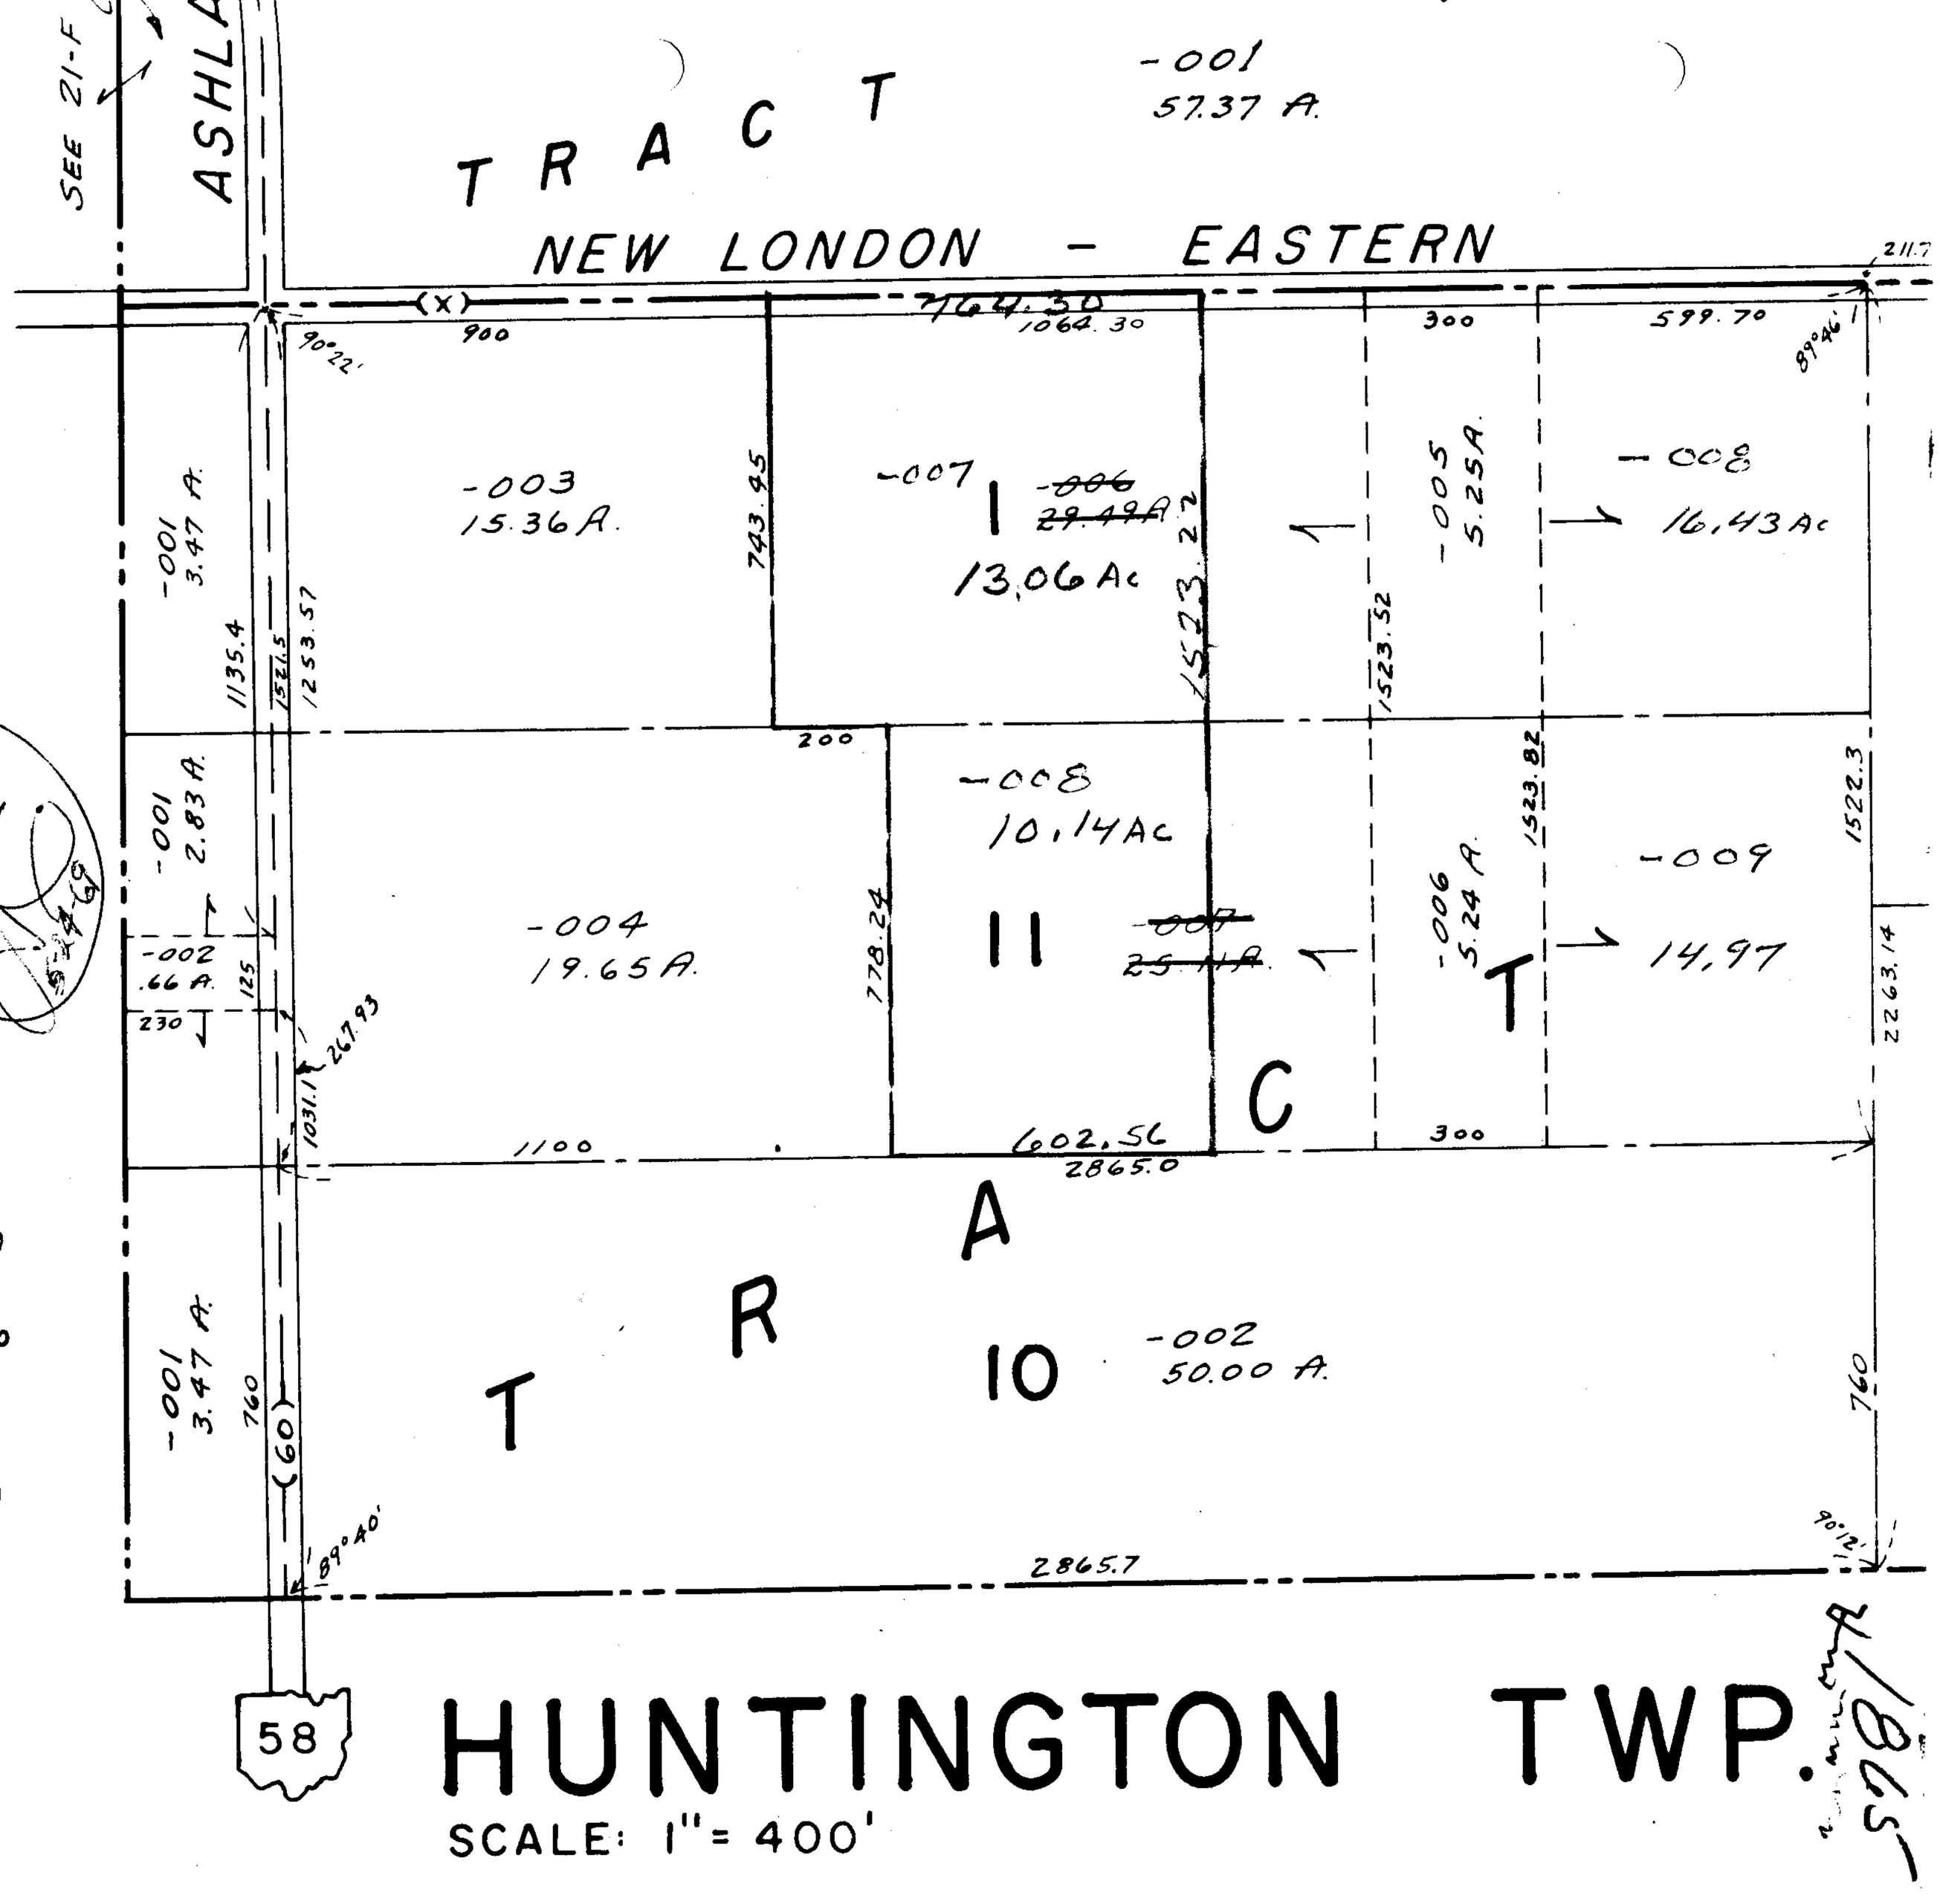

#1865
APPROVED
LORAIN CO.
MAP DEPT.
DATE 6-14-68
21-6
BY LWHall

Owner Initiated 7/23/68

opyright 1962
REVISED 5-24-68

21-G