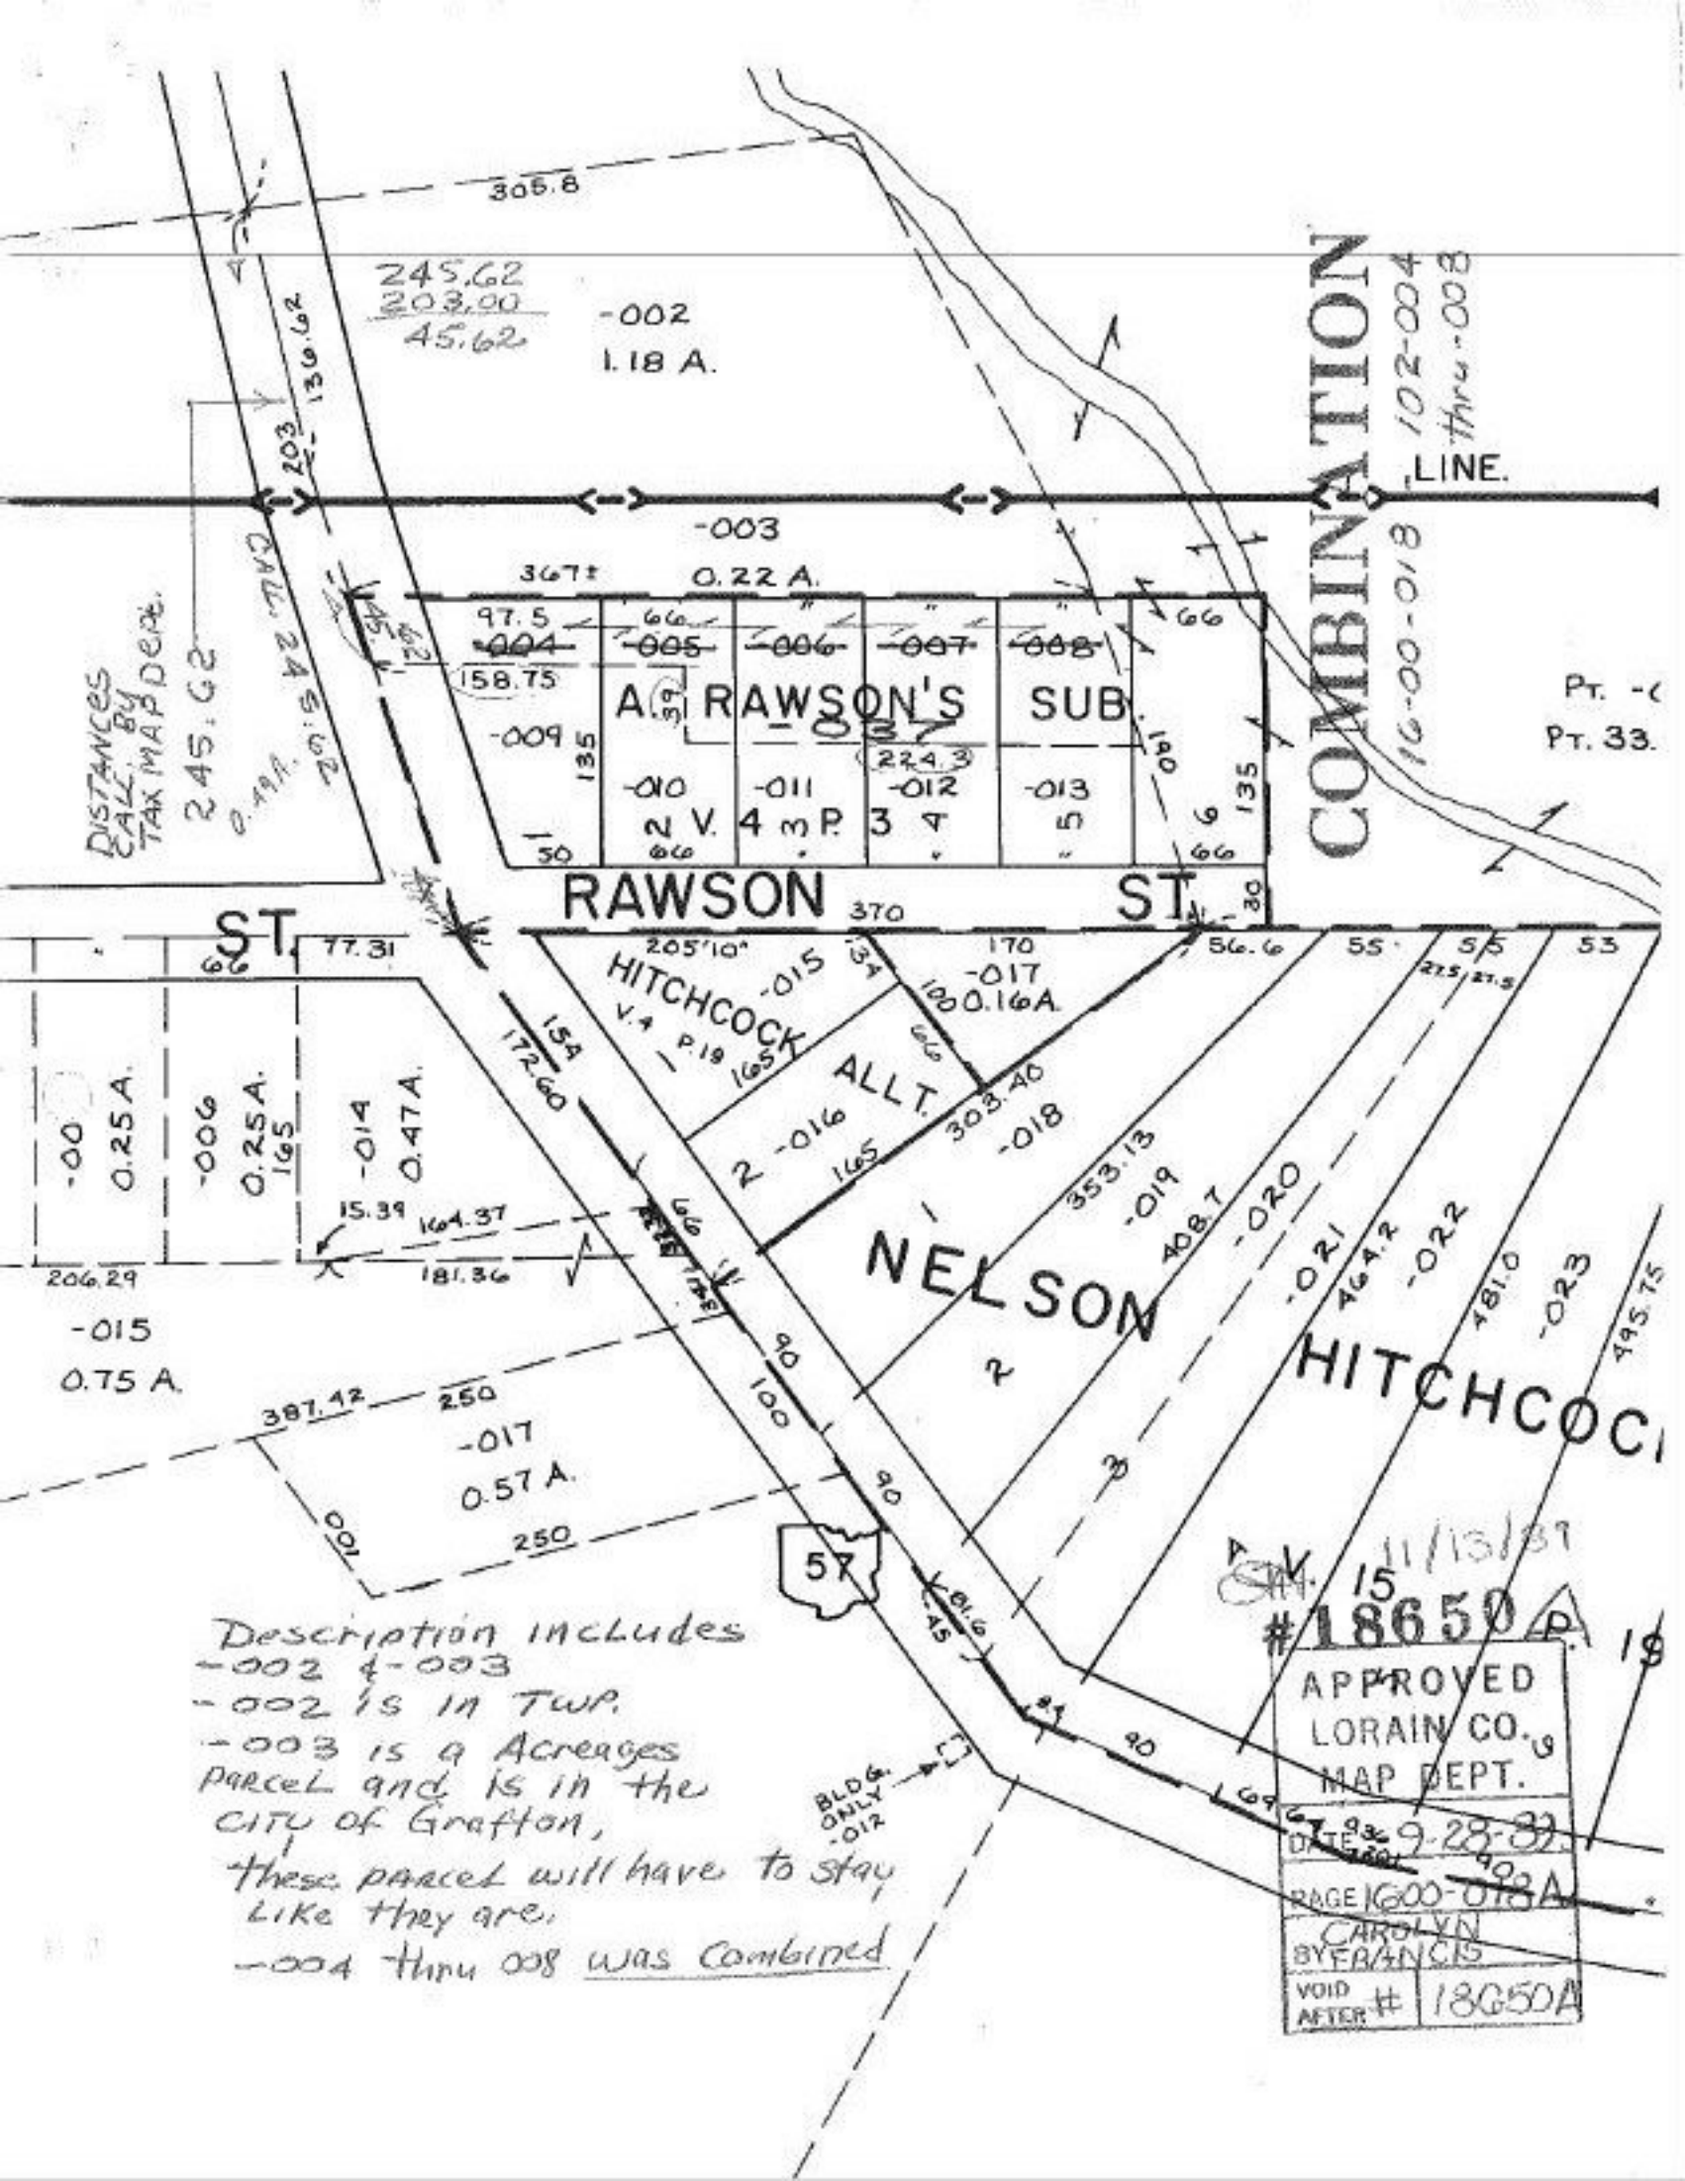

Description includes
-002 & -003
-002 is in Twp.
-003 is a Acreages parcel and is in the city of Grafton,
these parcel will have to stay like they are.
-004 thru 008 was combined