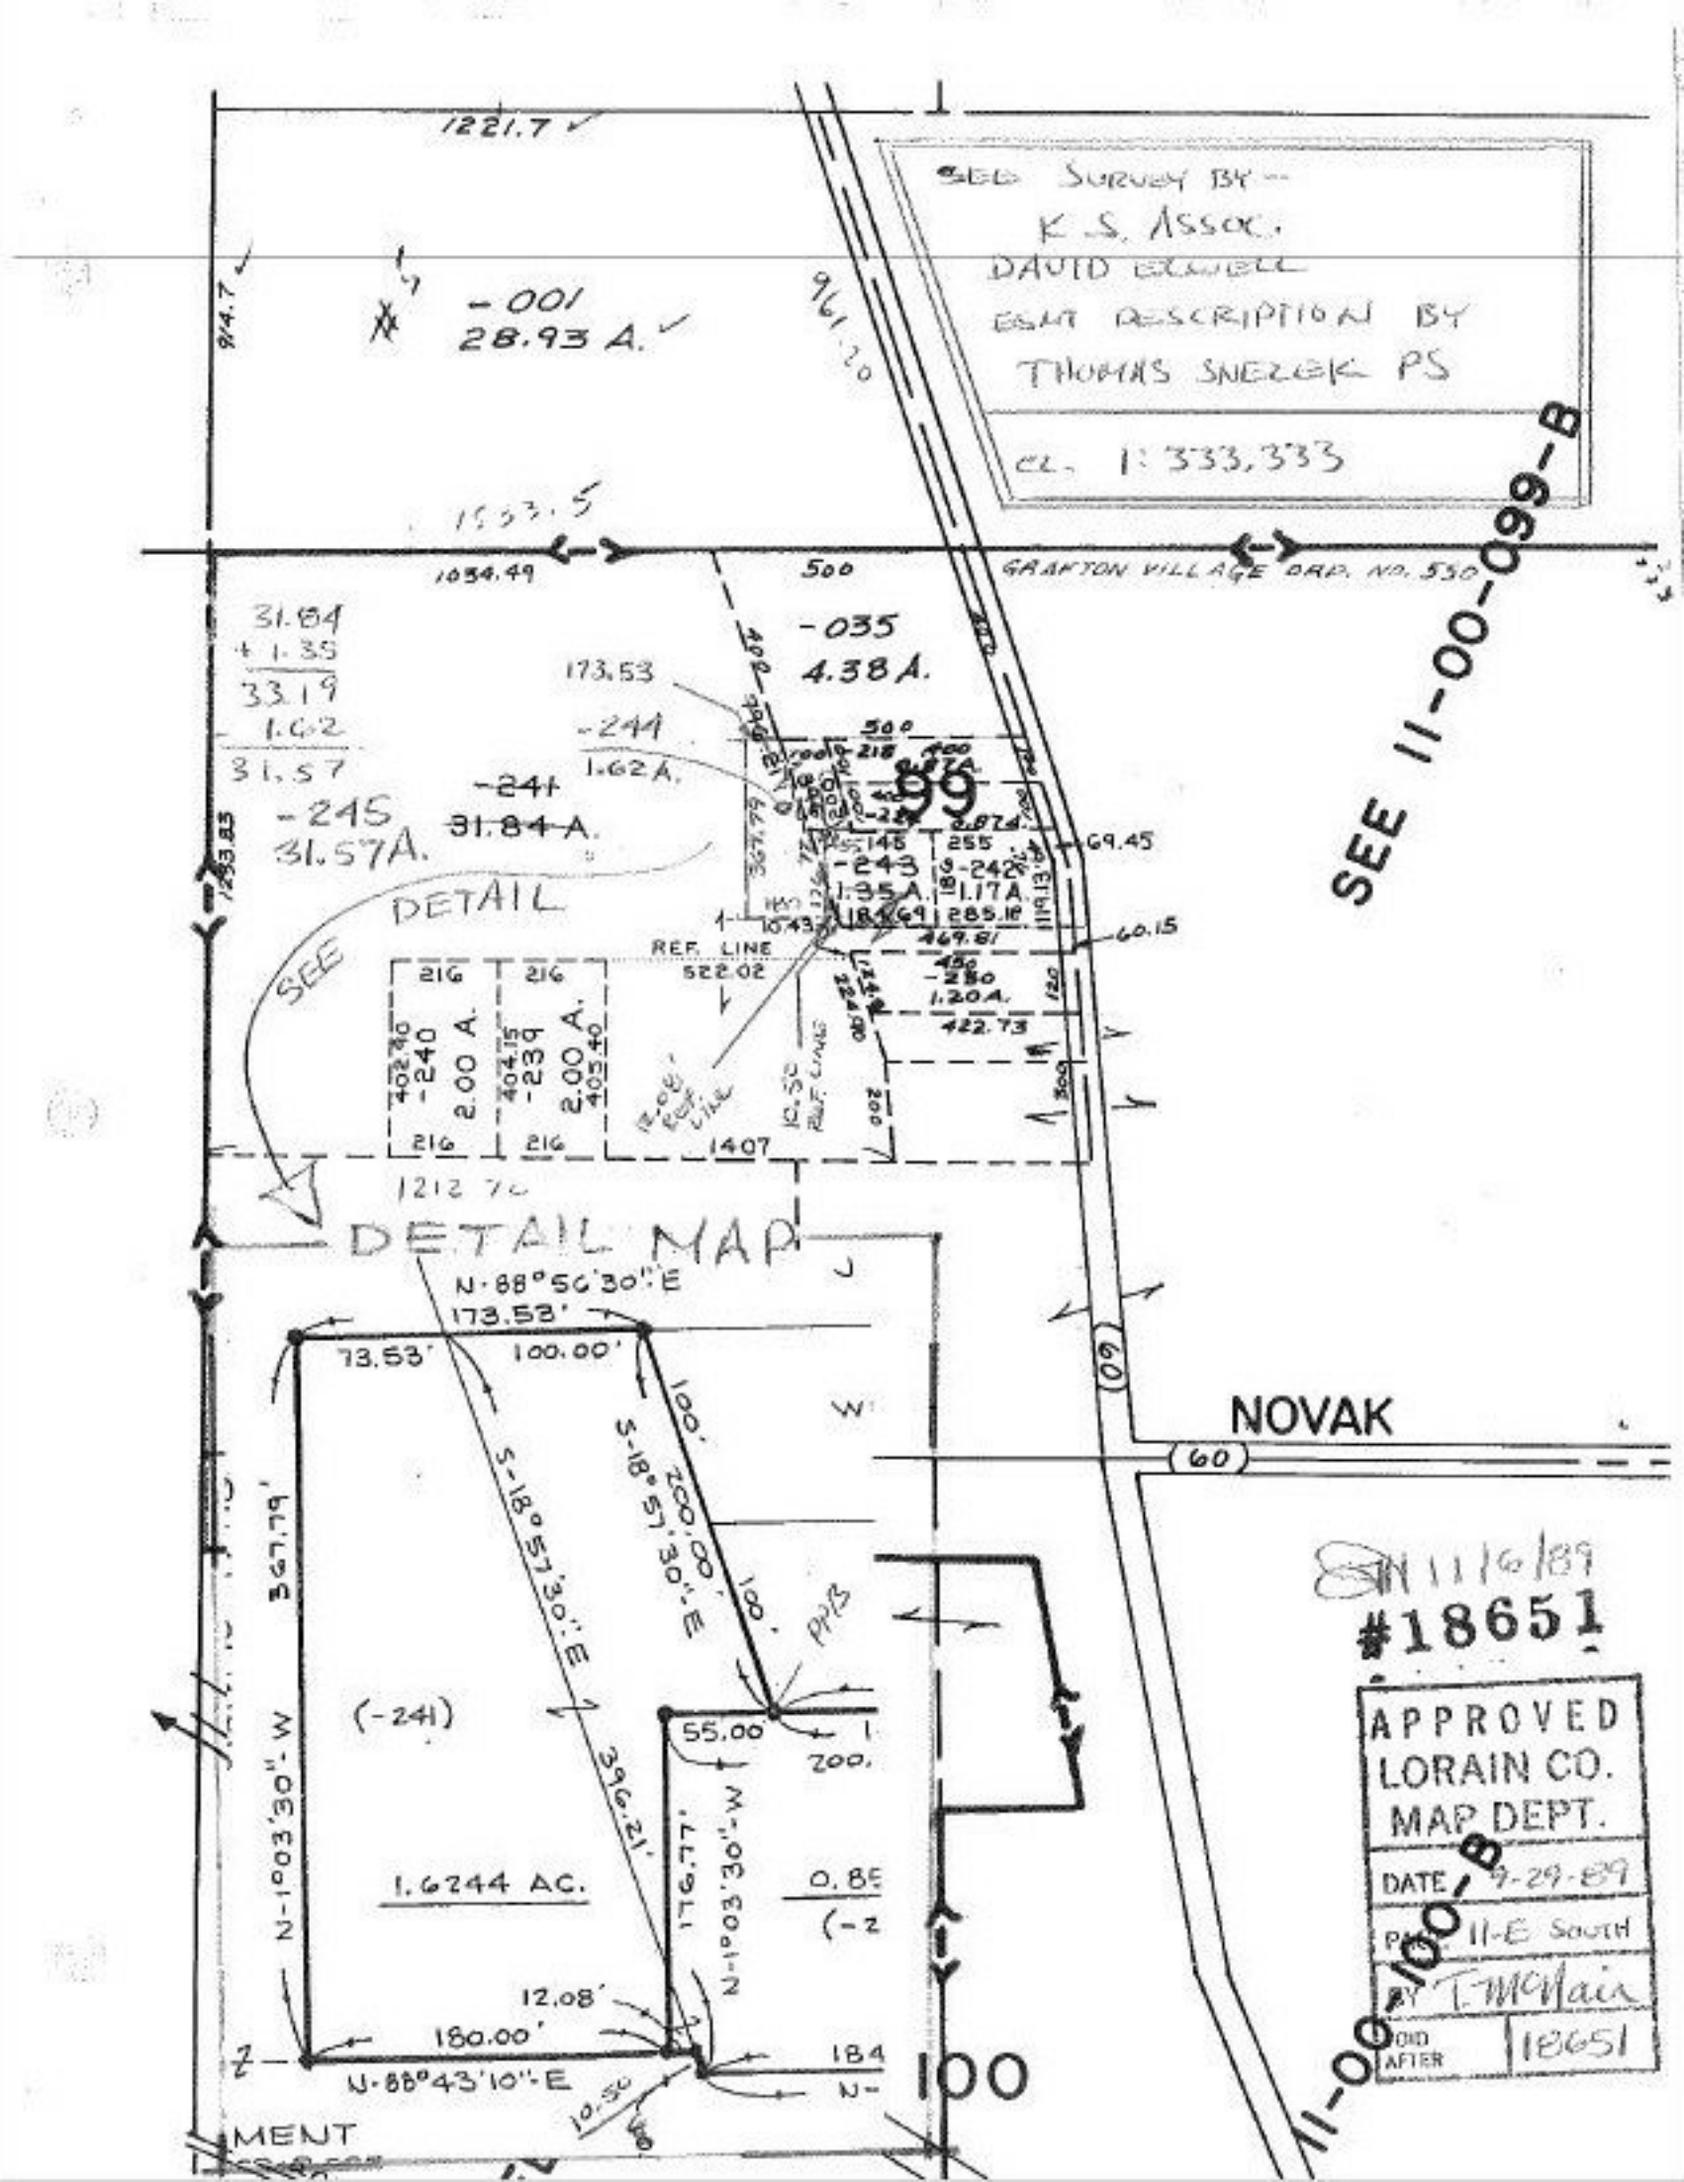
SEE SURVEY BY --
K. S. ASSOC.
DAVID BOWELL
EASMT DESCRIPTION BY
THOMAS SNEZEK PS
CL. 1: 333,333
1221.7
914.7
-001
28.93 A.
961.20
1533.5
1054.49
500
GRAFTON VILLAGE ORD. NO. 530
SEE 11-00-099-B
31.84
+ 1.35
33.19
1.62
31.57
-241
31.84 A.
-245
31.57A.
173.53
-244
1.62A.
-035
4.38A.
99
-243
1.35A
-242
1.17A
-250
1.20A.
SEE DETAIL
REF. LINE
522.02
402.90
-240
2.00 A.
405.40
404.15
-239
2.00 A.
405.40
1407
1212.70
DETAIL MAP
N-88°50'30"-E
173.53'
100.00'
367.79'
S-18°57'30"-E
200.00'
N-1°03'30"-W
(-241)
396.21'
1.6244 AC.
55.00
176.77'
12.08'
180.00'
N-88°43'10"-E
10.50
100
NOVAK
60
11-00-100-B
11/16/89
#18651
APPROVED
LORAIN CO.
MAP DEPT.
DATE 9-29-89
BY T. McNair
VOID AFTER 18651