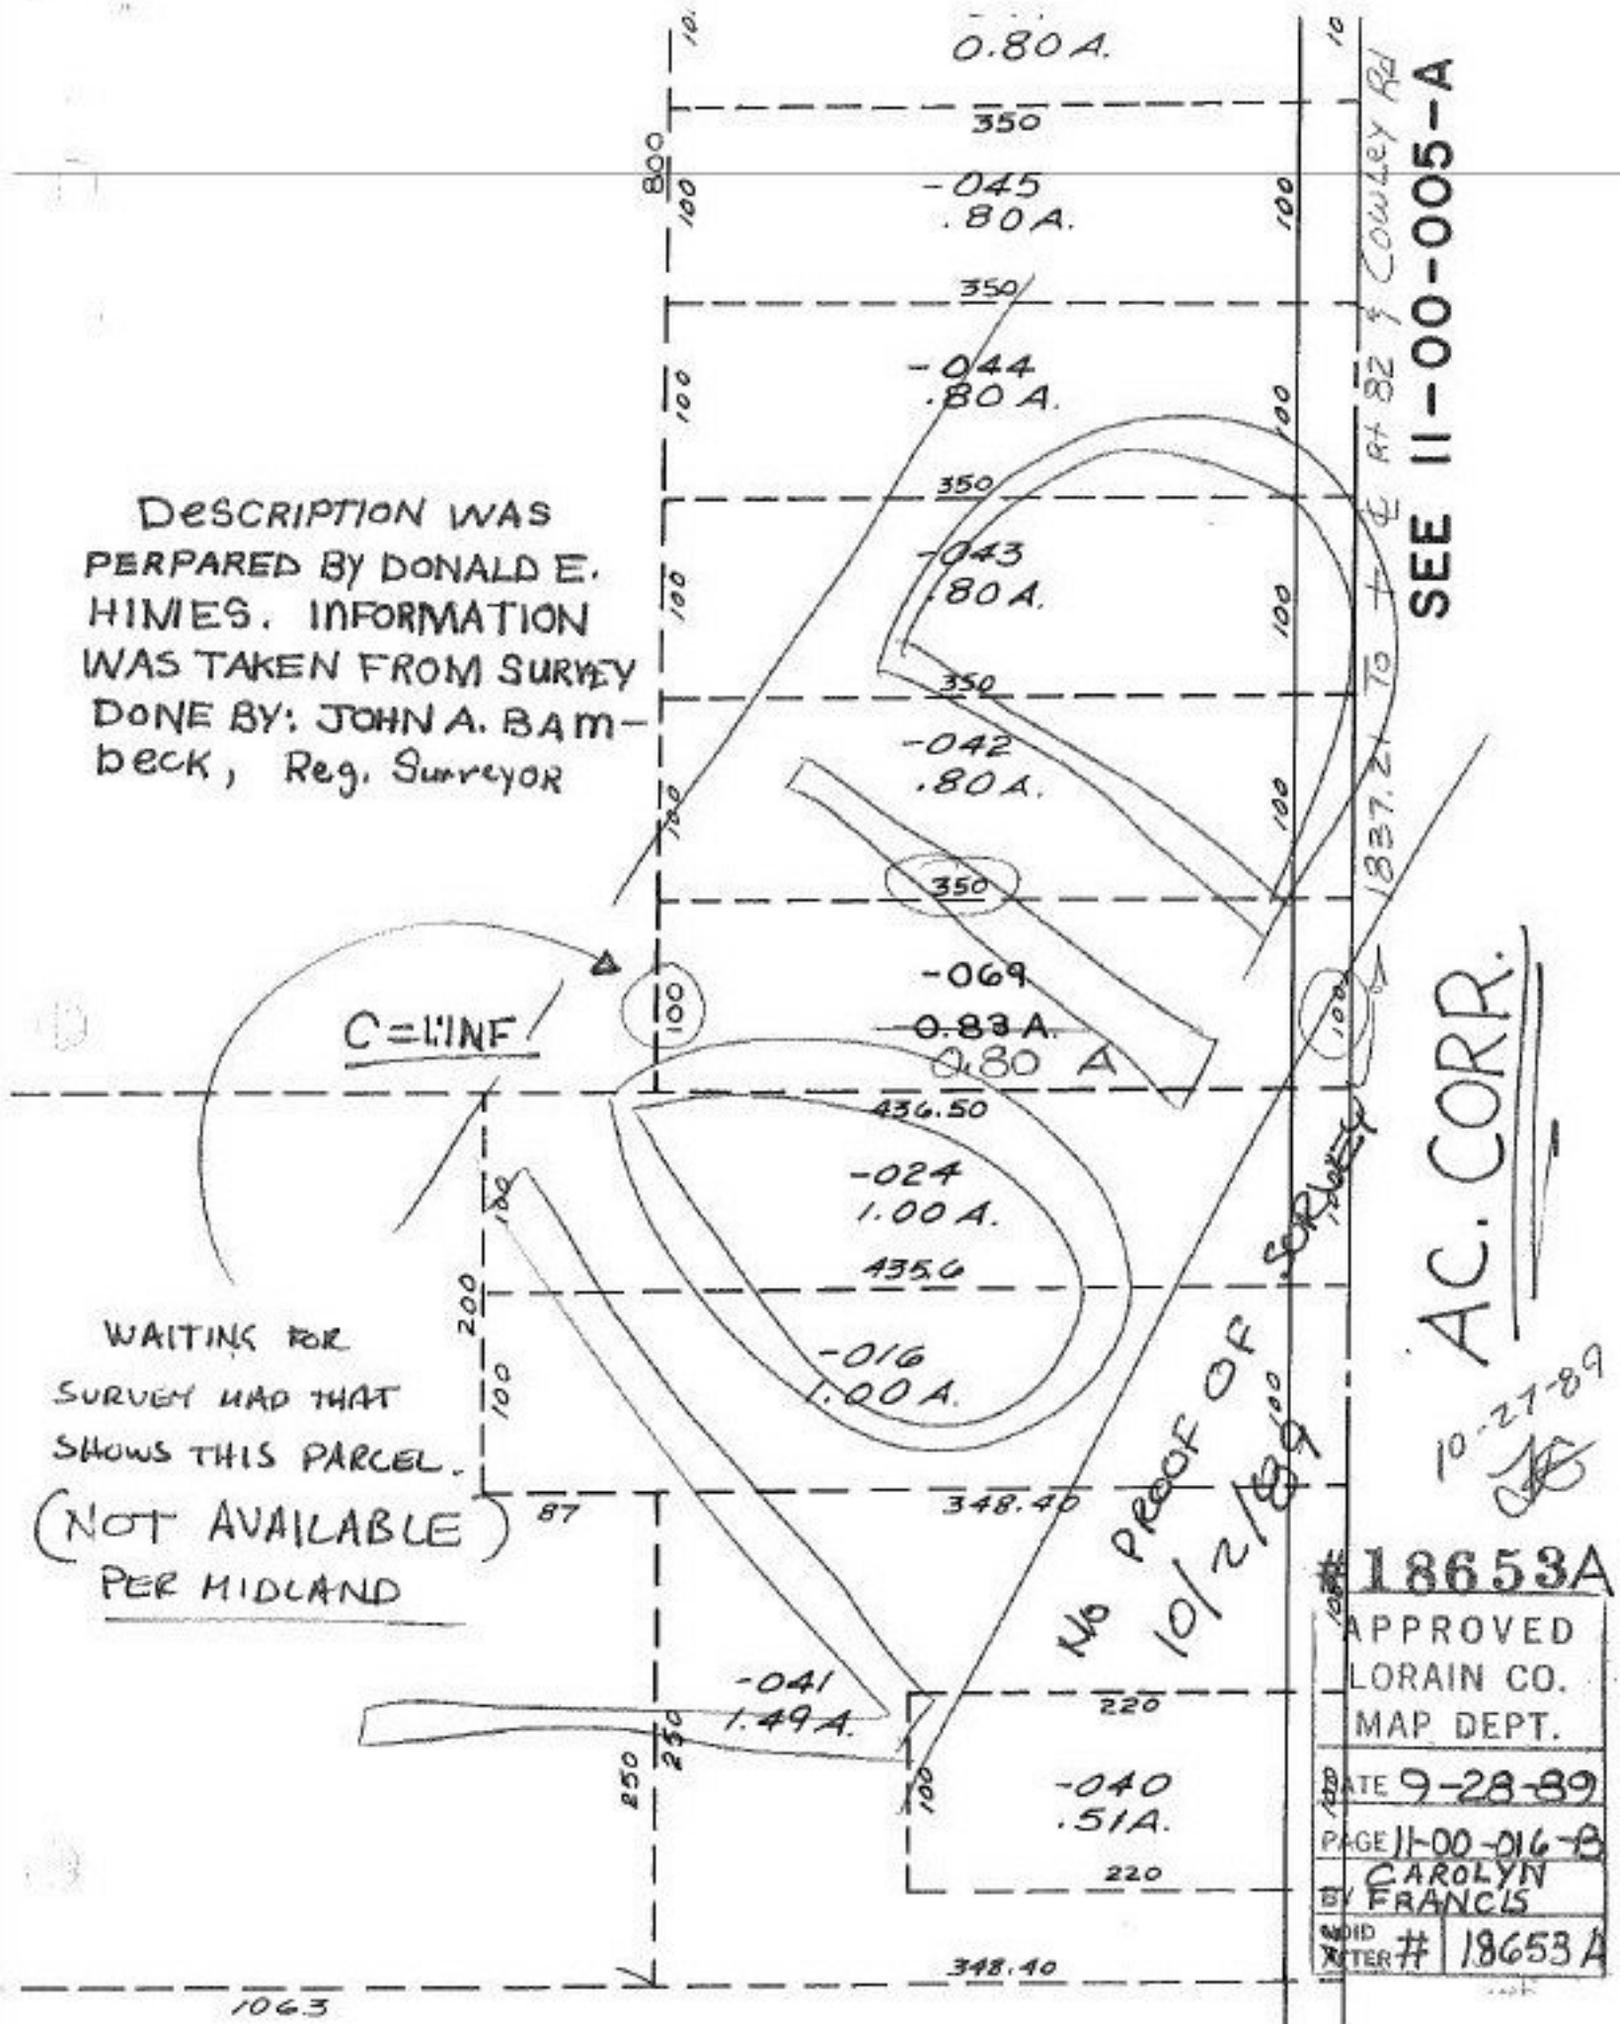

0.80 A.
350
-045
.80 A.
-044
.80 A.
-043
.80 A.
-042
.80 A.
-069
0.83 A.
0.80 A
436.50
-024
1.00 A.
435.6
-016
1.00 A.
348.40
-041
1.49 A.
220
-040
.51 A.
220
348.40
1063
C=1:INF
DESCRIPTION WAS PERPARED BY DONALD E. HIMES. INFORMATION WAS TAKEN FROM SURVEY DONE BY: JOHN A. BAMBECK, Reg. Surveyor
WAITING FOR SURVEY MAP THAT SHOWS THIS PARCEL.
(NOT AVAILABLE) PER MIDLAND
SEE 11-00-005-A
1837.21 To ℄ Rt 82 & Cowley Rd
AC. CORR.
10-27-89
No PROOF OF SURVEY
10/2/89
#18653A
APPROVED
LORAIN CO.
MAP DEPT.
DATE 9-28-89
PAGE 11-00-016-B
BY CAROLYN FRANCIS
MOD ATTER # 18653A