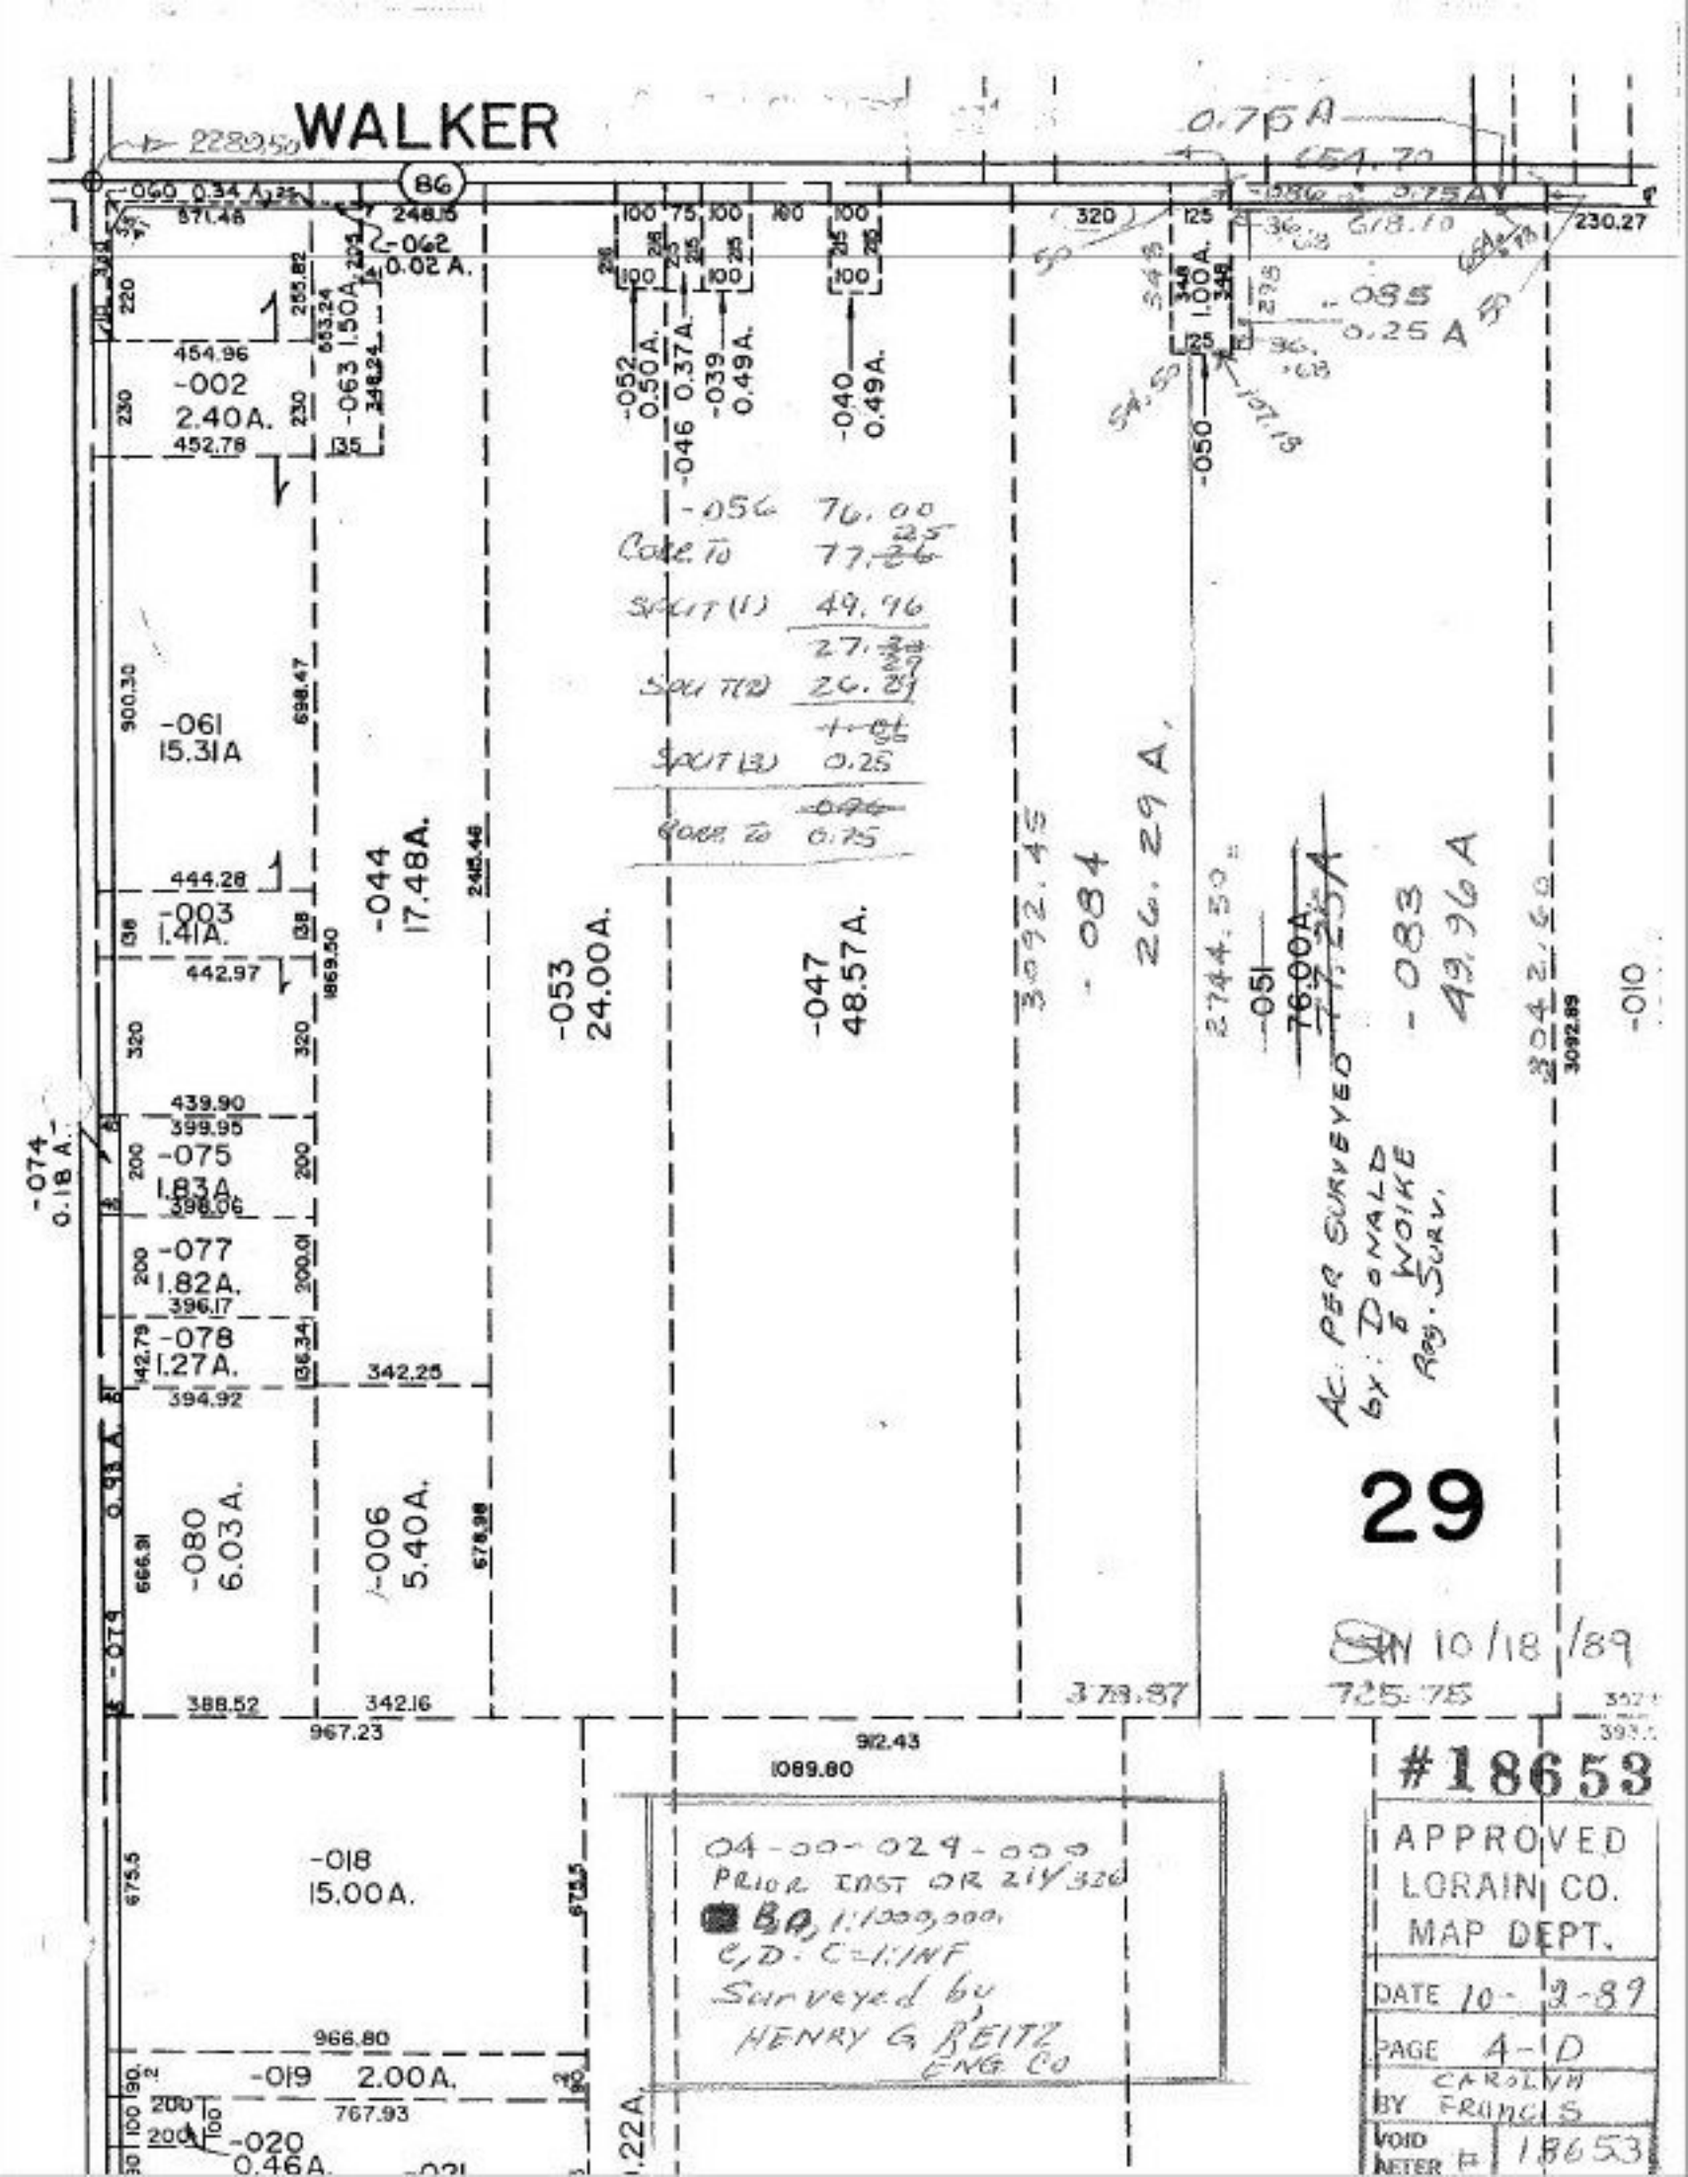
WALKER
86
-060 0.34 A.
871.48
248.15
-062 0.02 A.
-063 1.50A.
454.96
-002 2.40A.
452.78
-061 15.31A
-044 17.48A.
444.28
-003 1.41A.
442.97
-074 0.18 A.
-075 1.83A
-077 1.82A.
-078 1.27A.
342.25
394.92
-080 6.03 A.
-006 5.40A.
388.52
342.16
967.23
-018 15.00A.
966.80
-019 2.00A.
767.93
-020 0.46A.
-052 0.50A.
-046 0.37A.
-039 0.49A.
-040 0.49A.
-053 24.00A.
-047 48.57A.
-056 76.00
Code 10 77.26
Split (1) 49.96
27.30
Split (2) 20.29
+.97
Split (3) 0.25
Code 20 0.75
3092.45
-084 26.29 A.
2744.50
-051 76.00A.
-050
-085 0.25 A
0.75A
154.70
-086 3.75A
218.10
230.27
-083 49.96A
-010
AC. PER SURVEYED BY: DONALD E NOIKE Reg. Surv.
29
RN 10/18/89
725.75
378.87
1089.80
#18653
APPROVED
LORAIN CO.
MAP DEPT.
DATE 10-2-89
PAGE 4-D
BY CAROLYN FRANCIS
VOID METER # 18653
04-00-029-000
PRIOR INST OR 214/320
BR 1:1000,000
C/D: C-1:INF
Surveyed by
HENRY G REITZ
ENG CO