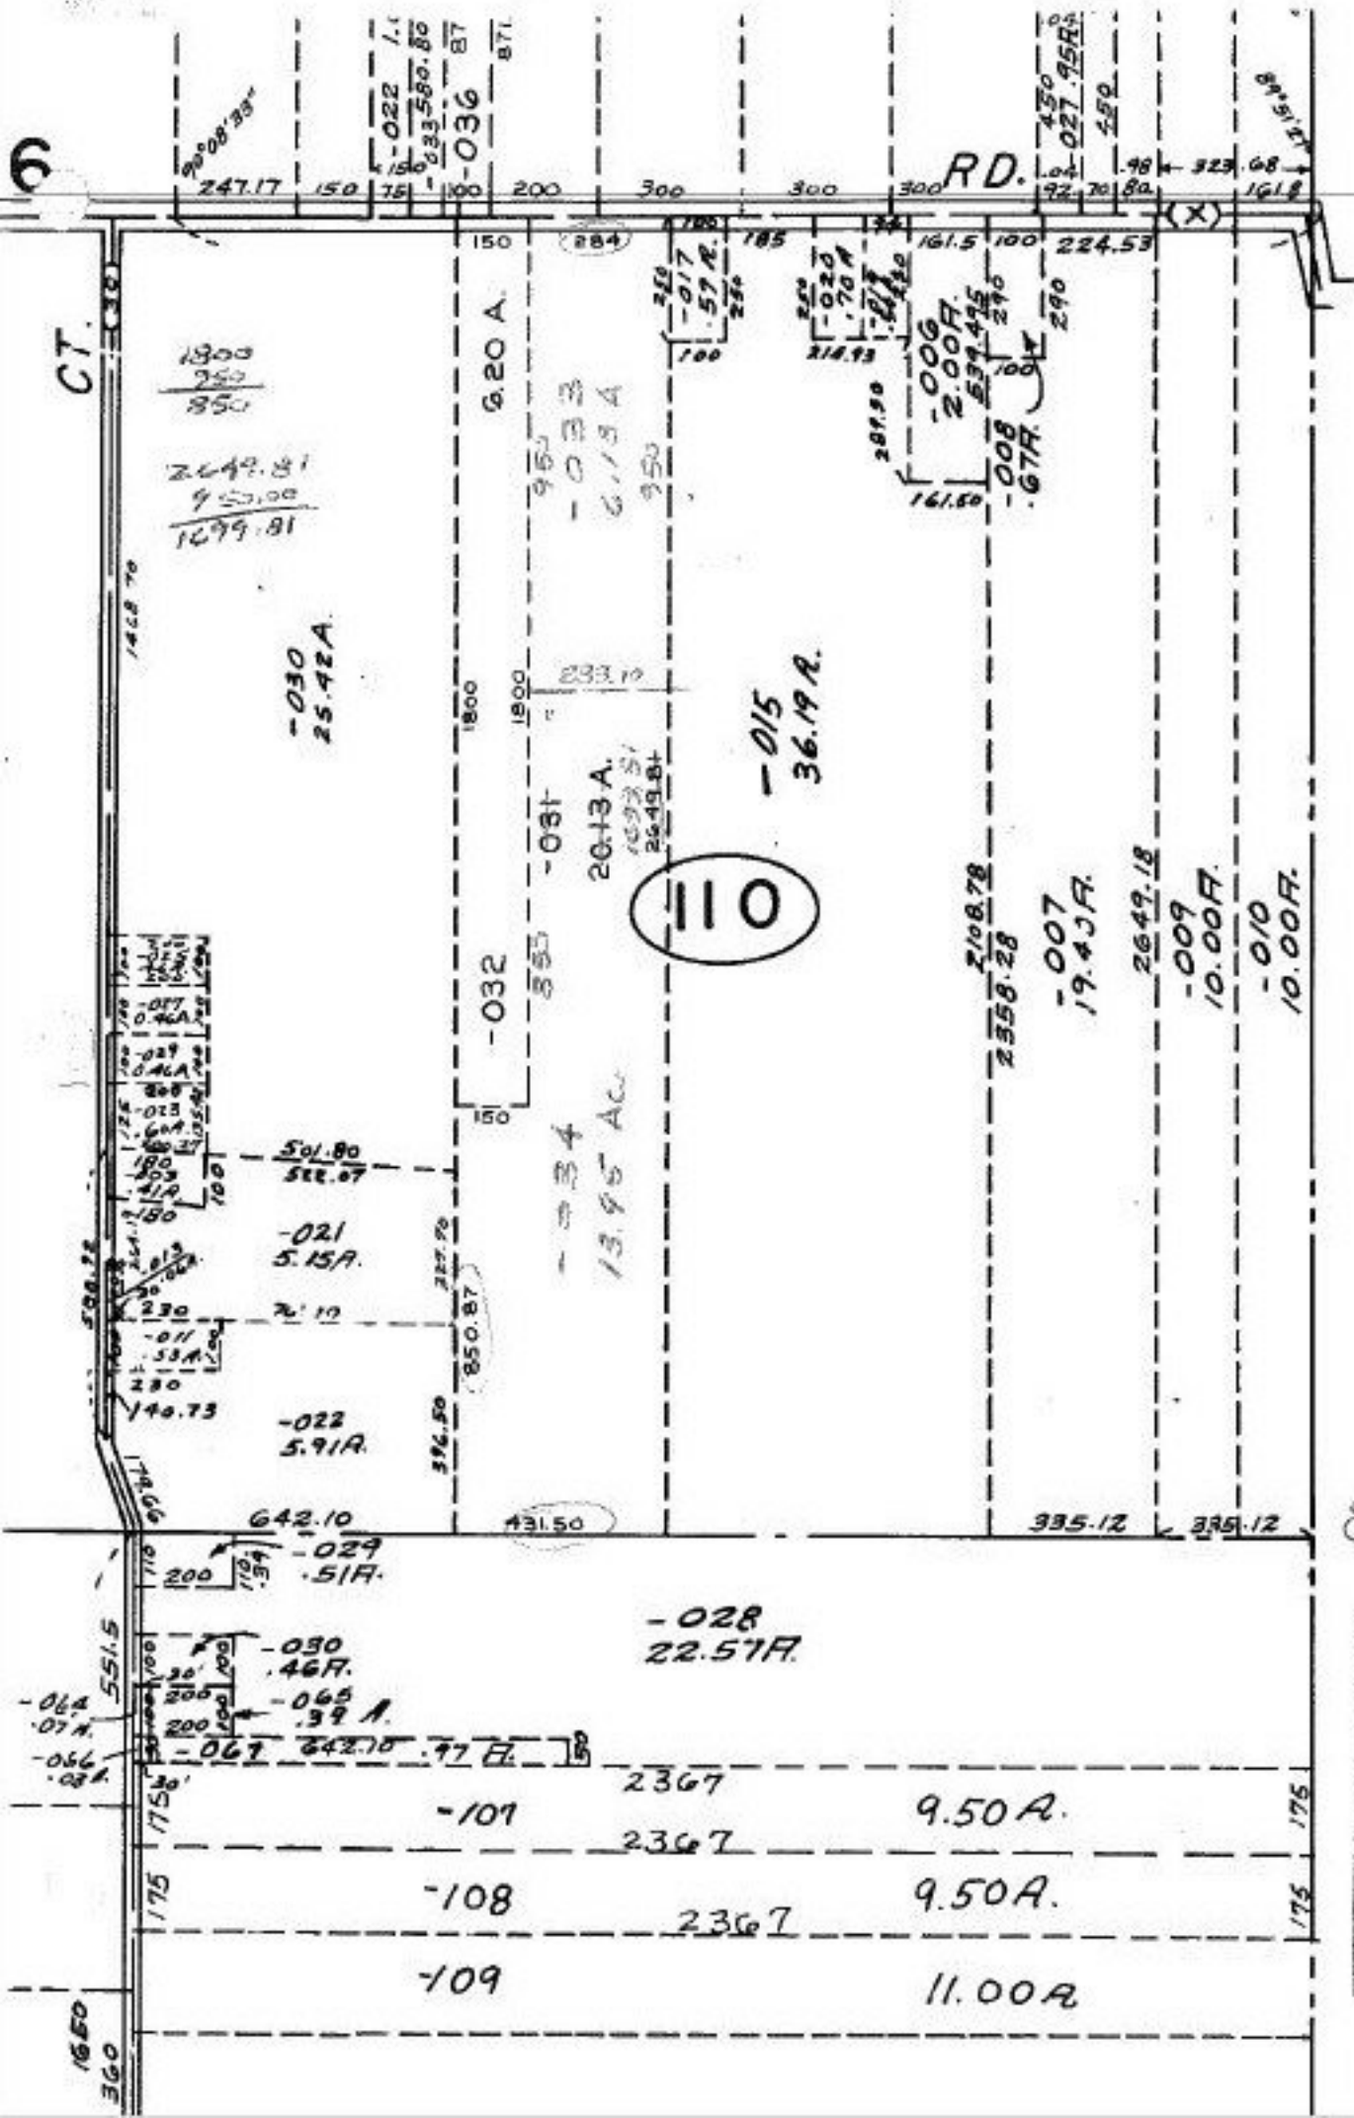

04-00-026-110-
PRIOR INST. 1394/119
SURVEYED BY: Thomas A. Resar
A.C =1: 10000,000. Reg. Surv.
B.C =1:500,000.

10/18/89

#18658

APPROVED
LORAIN CO.
MAP DEPT.

DATE 10-4-89
PAGE 4-L
BY CAROLYN FRANCIS
VOID AFTER # 18658