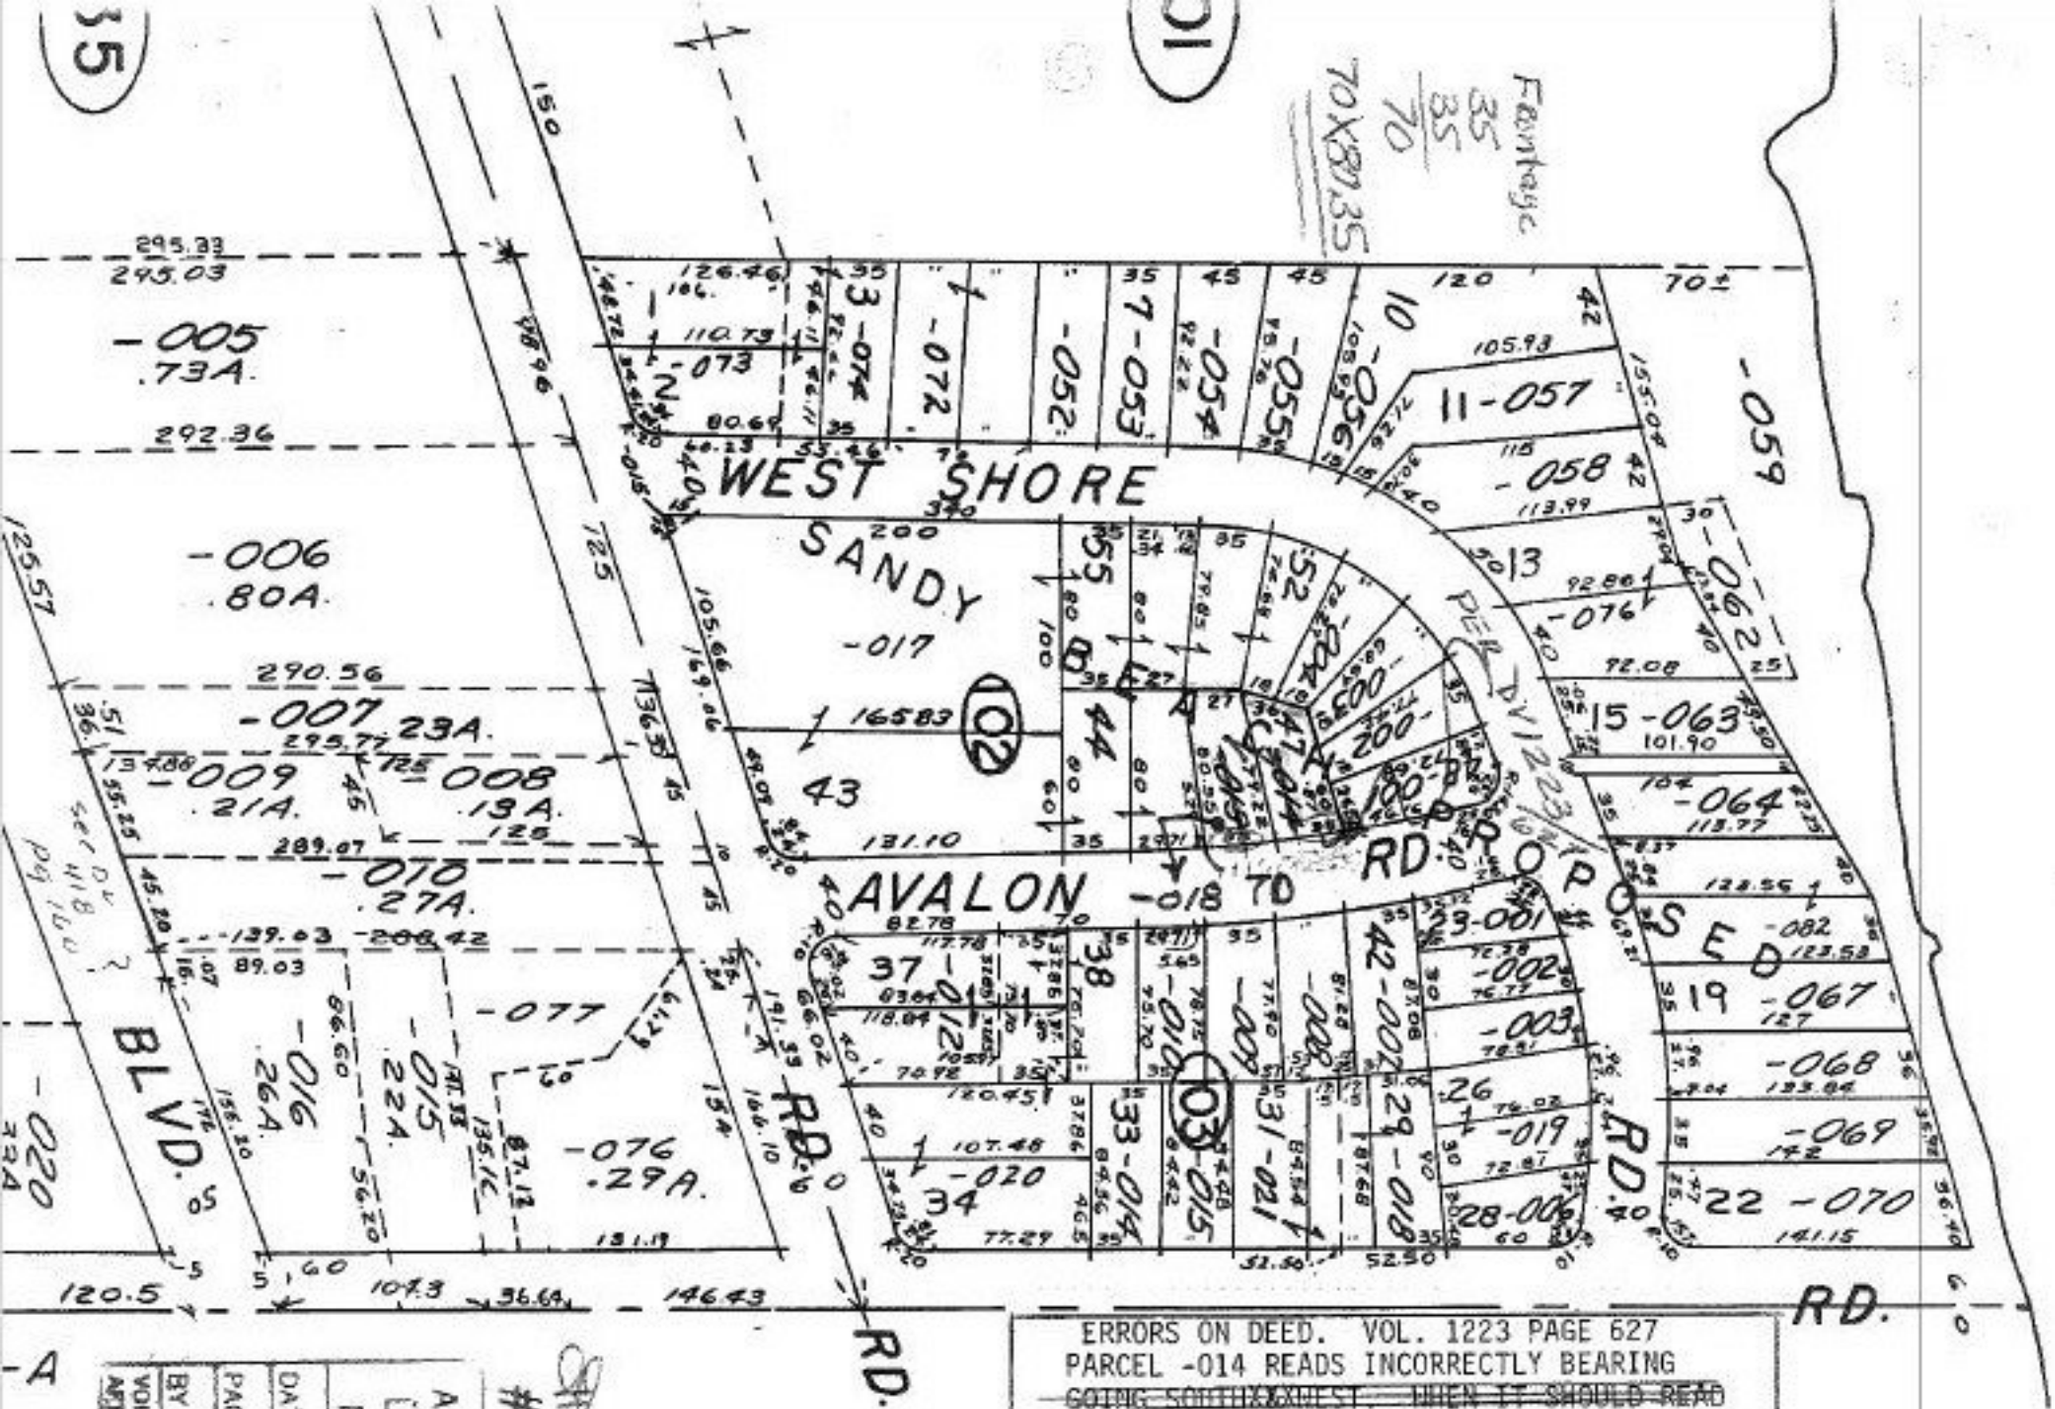
WEST SHORE
SANDY
AVALON
RD.
BLVD.
-005 .73A.
-006 .80A.
-007 .23A.
-008 .19A.
-009 .21A.
-010 .27A.
-076 .29A.
-077
-016 .26A.
-015 .22A.
-020 .24A.
-017
-018 TO
-059
-062
-063
-064
-067
-068
-069
-070
-082
-001
-002
-003
-019
-021
-057
-058
-076
-072
-073
-074
-075
-052
-053
-054
-055
-056
-012
-010
-009
-008
-014
-015
-013
-020
-018
-022
-023
