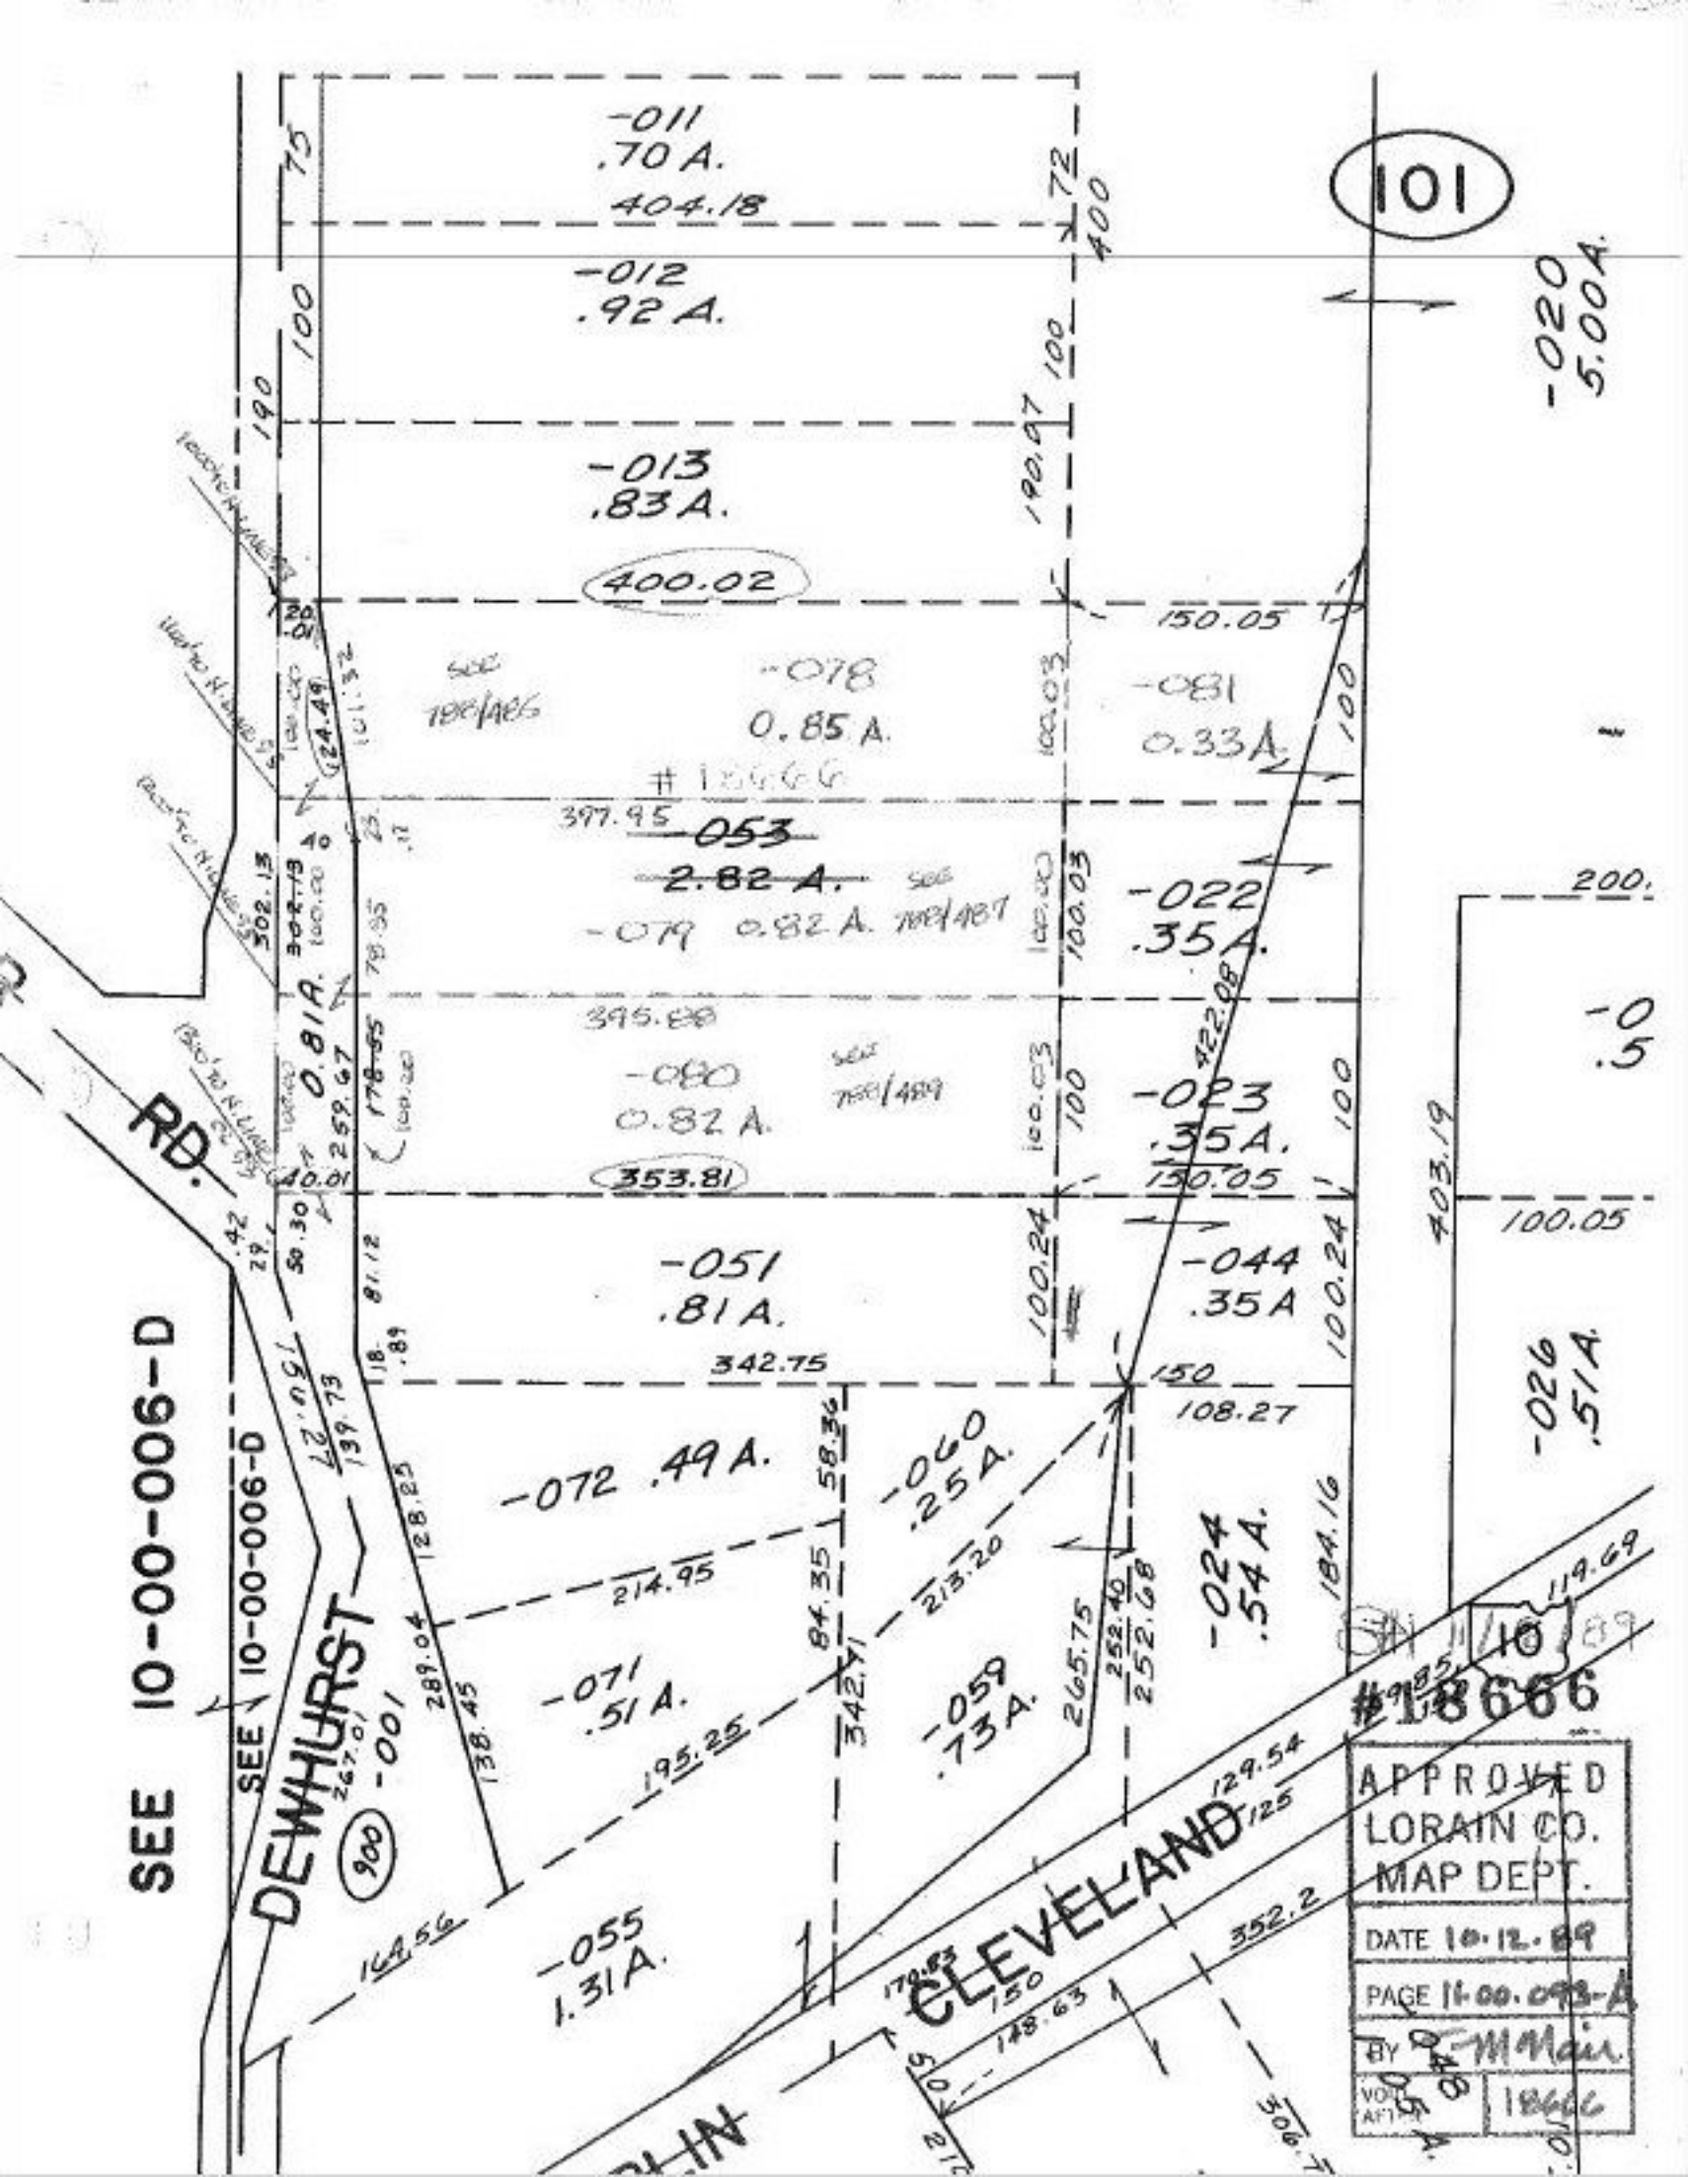
101
-011
.70 A.
404.18
-012
.92 A.
-013
.83 A.
400.02
-020
5.004.
-078
0.85 A.
-081
0.33 A.
#18666
-053
2.82 A.
-079 0.82 A.
-022
.35 A.
-080
0.82 A.
-023
.35 A.
-051
.81 A.
-044
.35 A
-026
.51 A.
-072 .49 A.
-060
.25 A.
-024
.54 A.
-071
.51 A.
-059
.73 A.
-055
1.31 A.
SEE 10-00-006-D
DEWHURST RD.
CLEVELAND
APPROVED
LORAIN CO.
MAP DEPT.
DATE 10-12-89
PAGE 11-00-093-A
BY M Main
VOL 48
AFT 18666