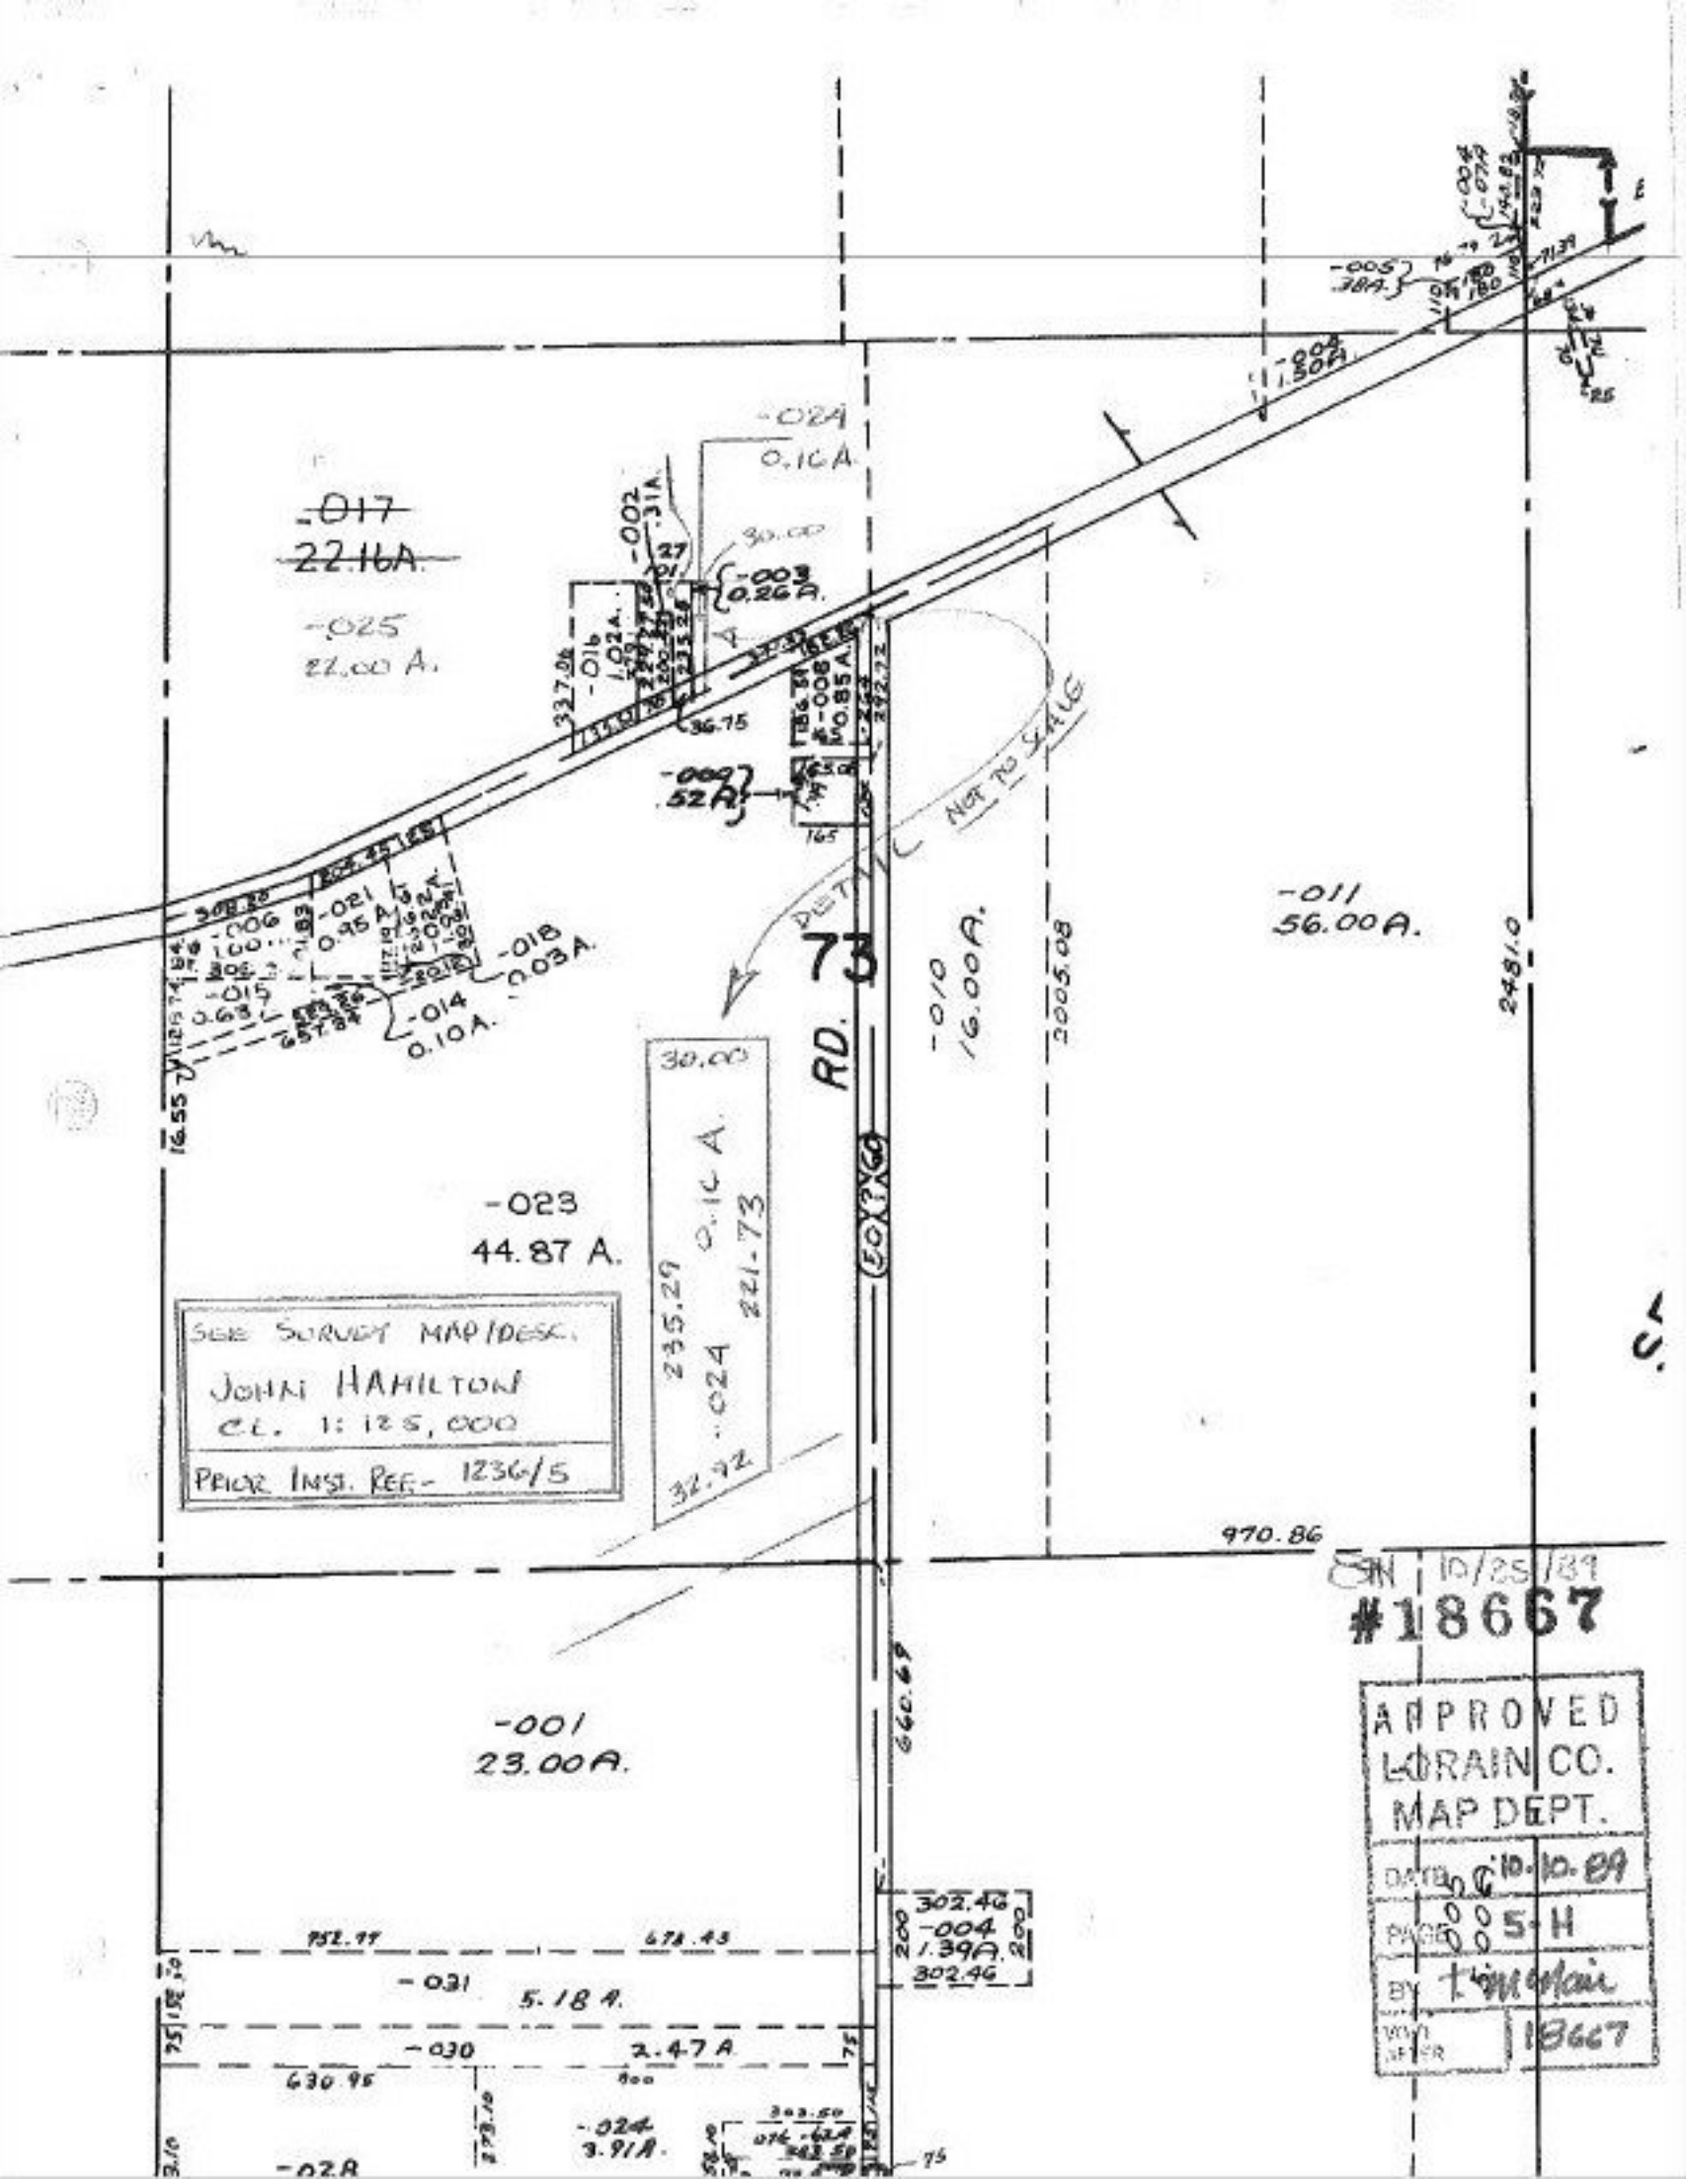
-017
22.16A.
-025
22.00 A.
-029
0.16A.
-002
.31A.
-003
0.26A.
-016
1.02A.
-008
M0.85A.
-007
.52A.
-021
0.95A.
-006
0.68A.
-015
-018
0.03A.
-014
0.10A.
-023
44.87 A.
-010
16.00A.
-011
56.00A.
RD. 73
(EXTND)
NOT TO SCALE
DETAIL
30.00
235.29
0.16 A.
-024
221-73
32.92
SEE SURVEY MAP/DESC.
JOHN HAMILTON
CL. 1: 125,000
PRIOR INST. REF.- 1236/5
-001
23.00A.
970.86
660.68
302.46
-004
1.39A.
302.46
752.99
678.43
-031
5.18 A.
-030
2.47 A
630.95
-024
3.91A.
-028
2005.08
2481.0
16.55
327.08
SEN 10/25/89
#18667
APPROVED
LORAIN CO.
MAP DEPT.
DATE 10.10.89
PAGE 005 H
BY tmclain
VOL/FOLIO 18667